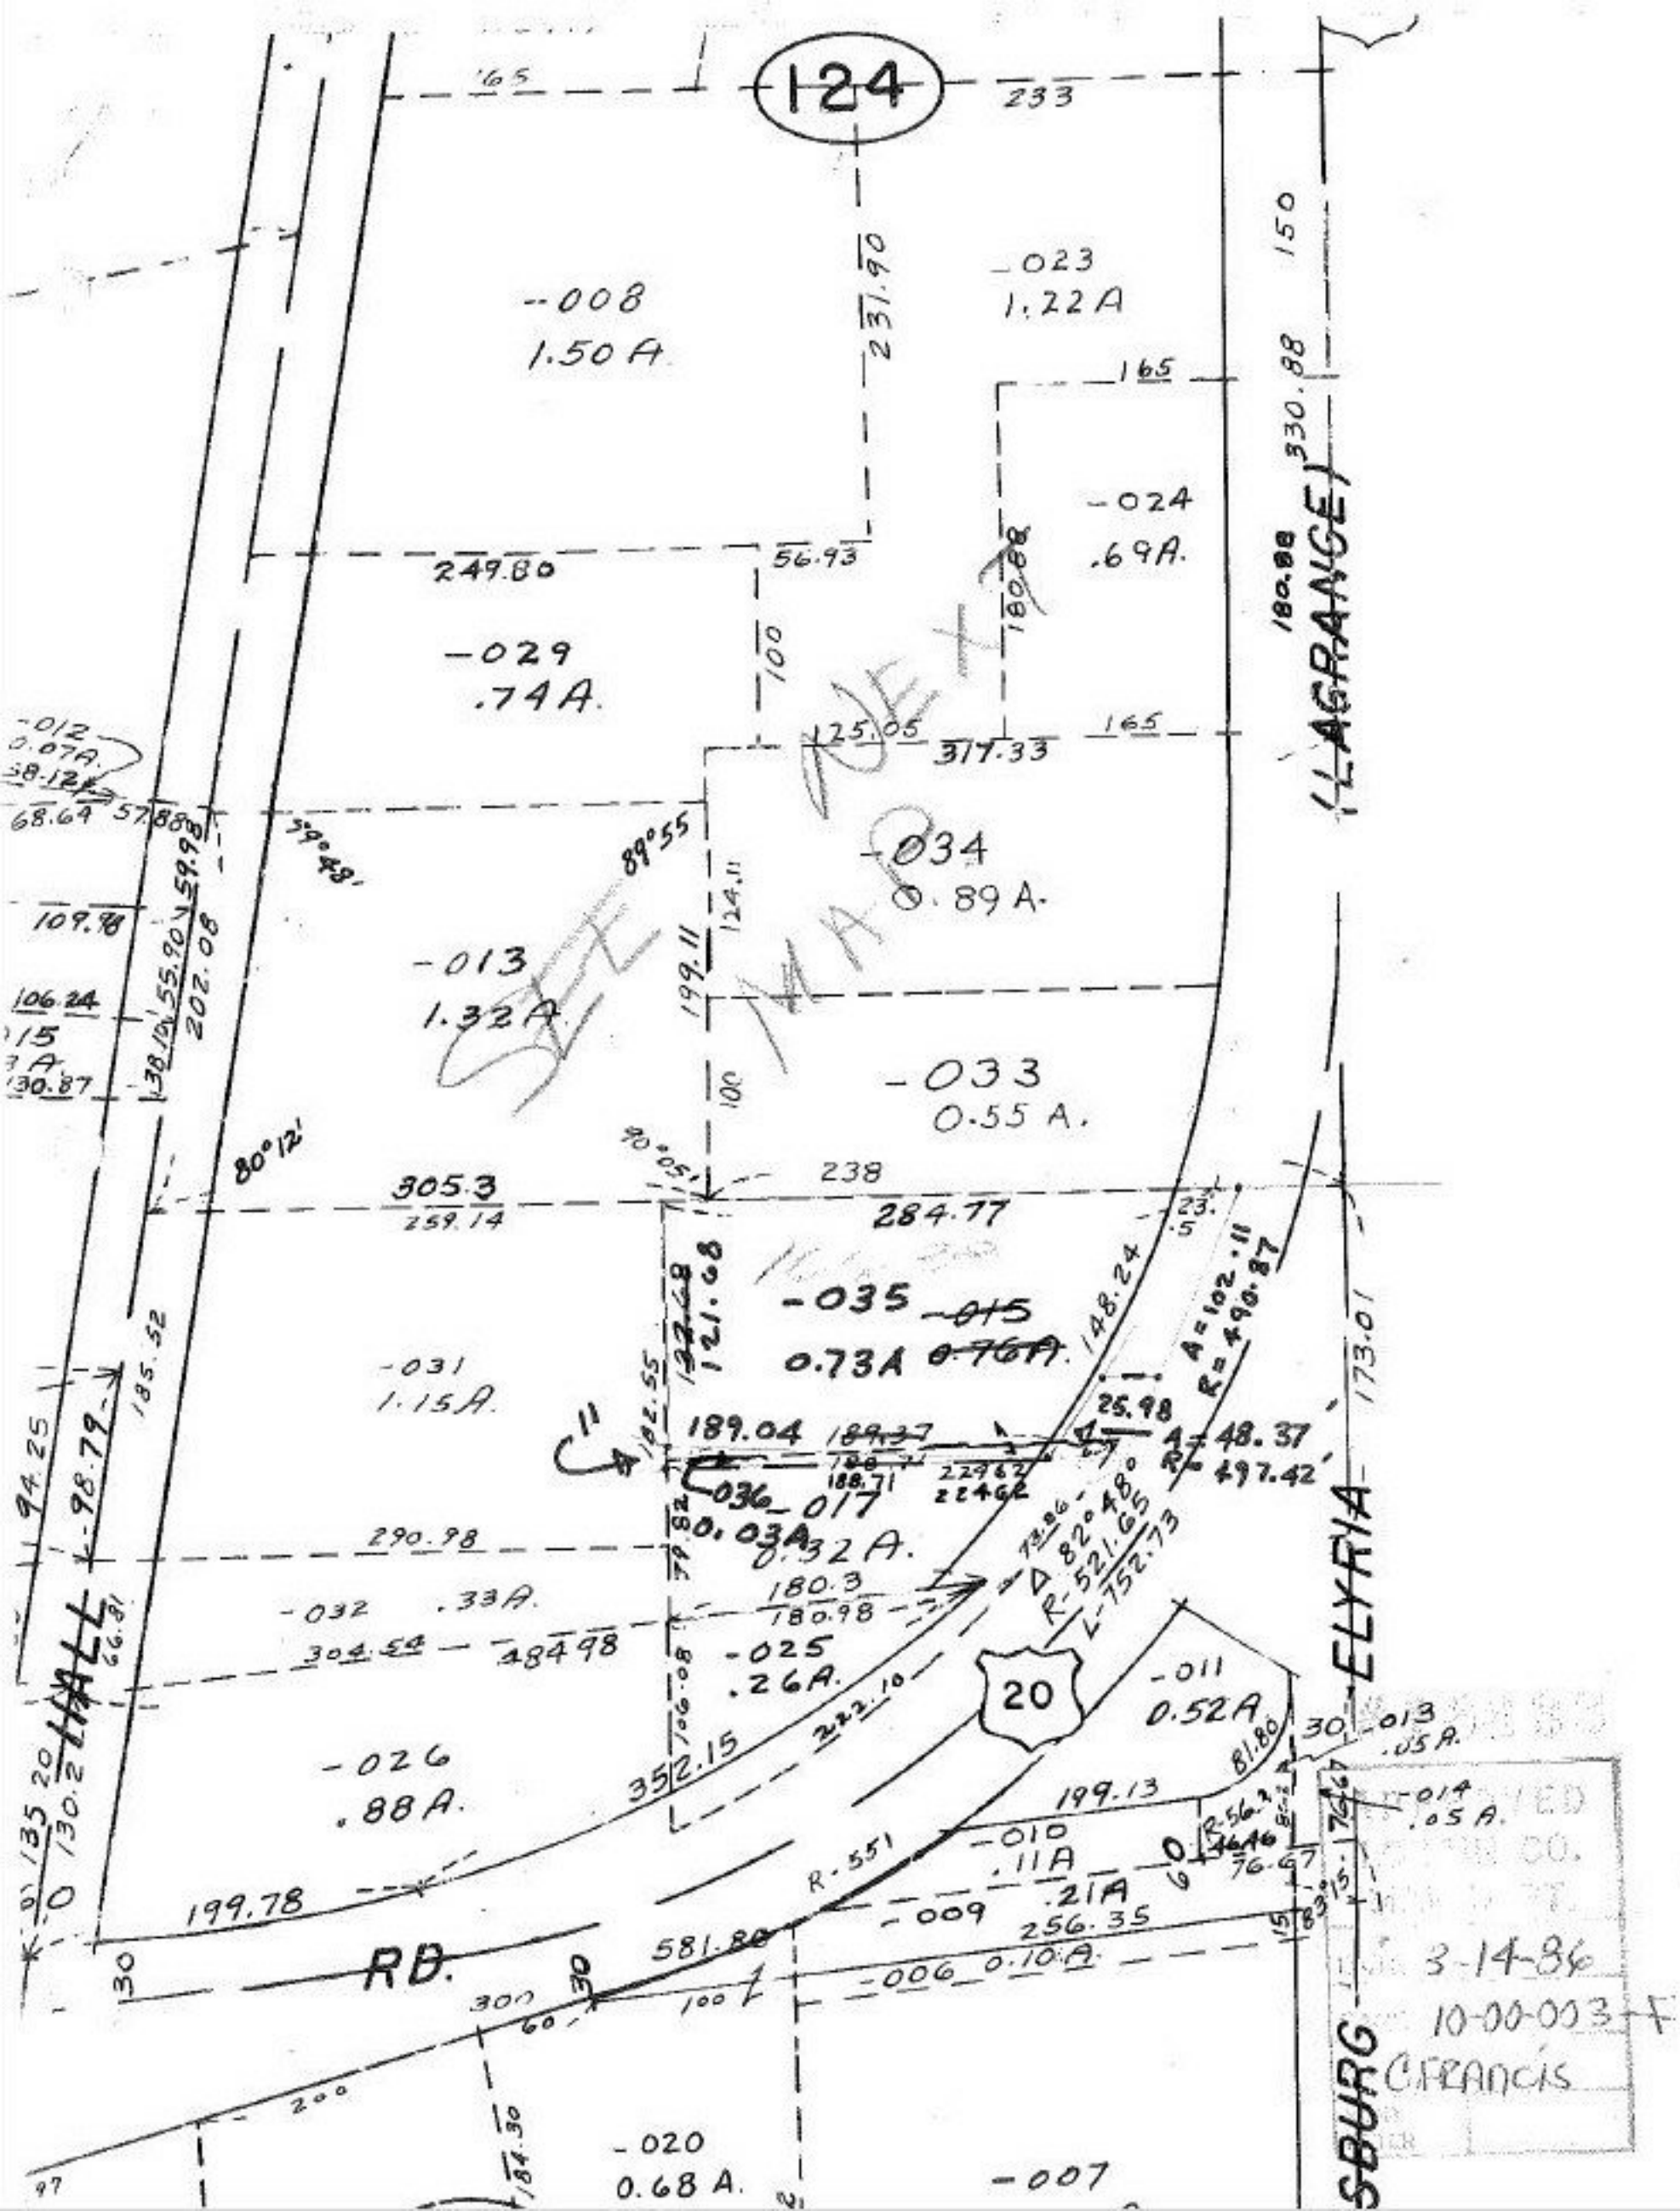
124
-008
1.50 A
-023
1.22 A
-024
.69A.
-029
.74A.
-034
0.89 A.
-013
1.32A
-033
0.55 A.
-035
0.73A
-031
1.15A.
-036
0.03A
-017
0.32 A.
-032
.33A.
-025
.26A.
-026
.88A.
-011
0.52A
-010
.11A
-009
.21A
-006
0.10A
-020
0.68 A.
-007
-012
0.07A.
-013
.05 A.
-014
.05 A.
20
RD.
HALL
ELYRIA
LAGRANGE
SBURG
SEE NEXT MAP
A=102.11
R=490.87
A=48.37
R=497.42
R-521.65
L-752.73
R-551
3-14-86
10-00-003-F
C.FRANCIS