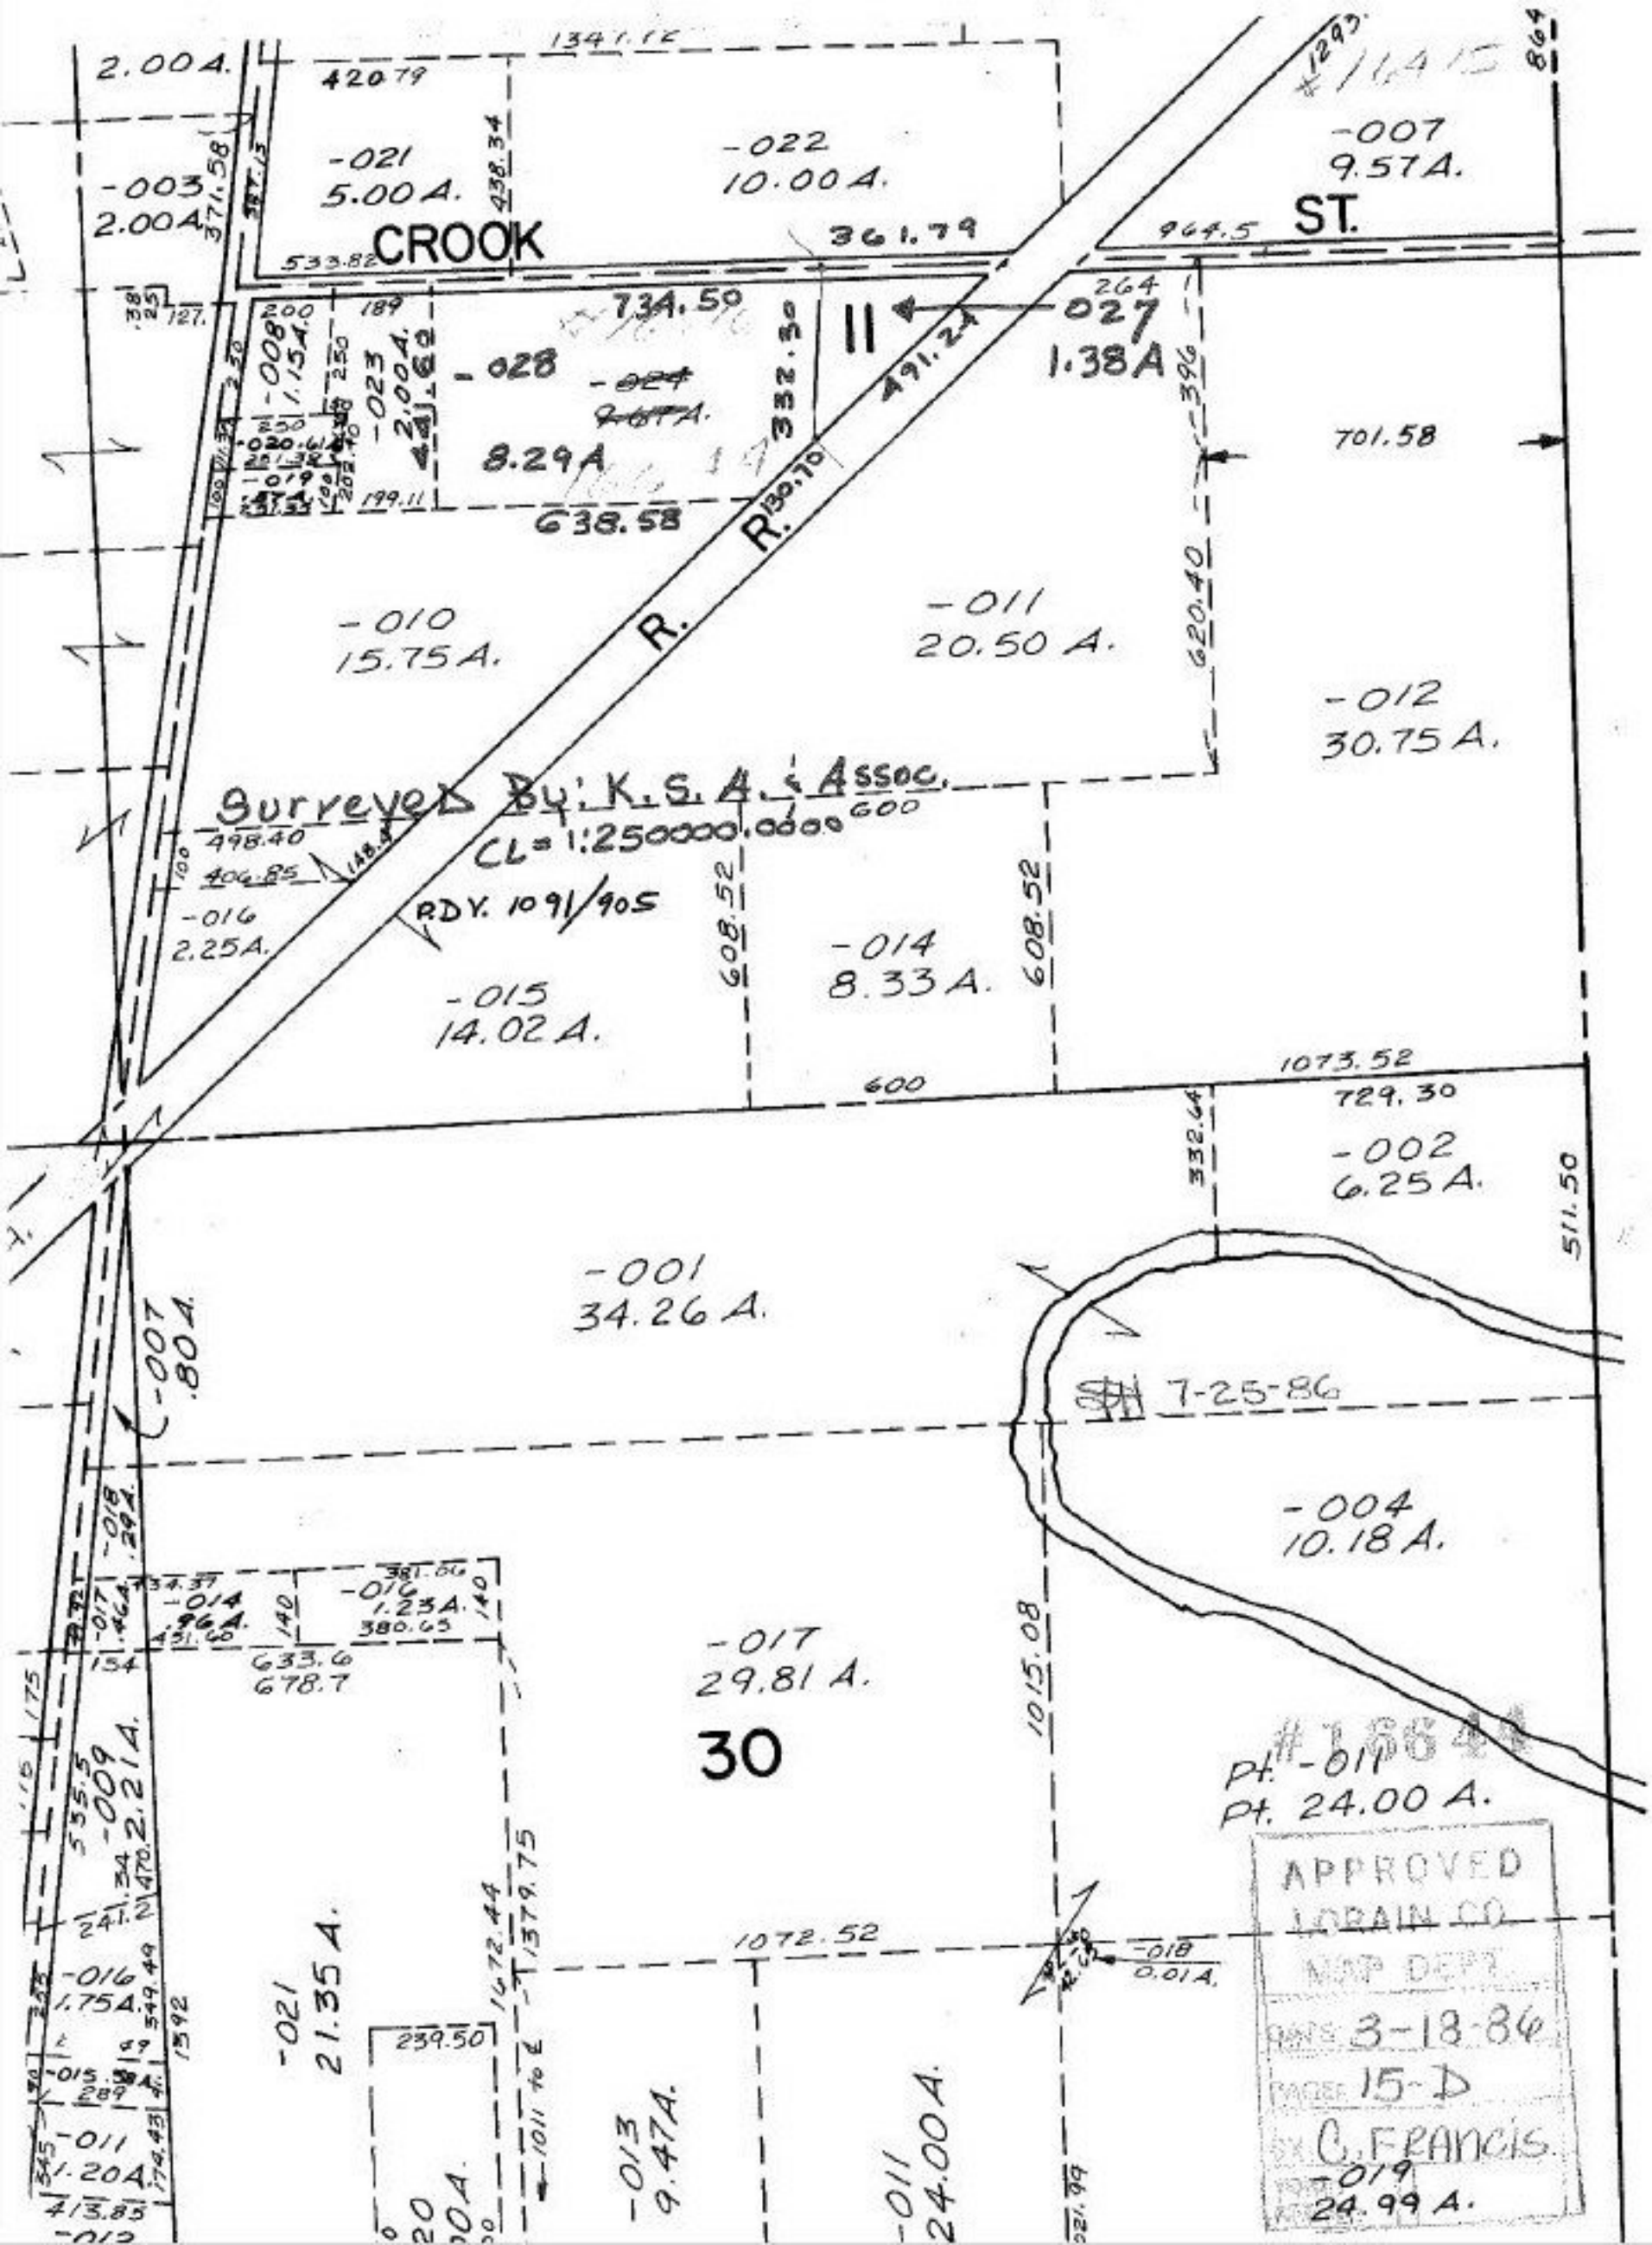
CROOK
ST.
R.
R.
-021
5.00 A.
-022
10.00 A.
-007
9.57 A.
-003
2.00 A.
-027
1.38 A
-028
8.29 A
-010
15.75 A.
-011
20.50 A.
-012
30.75 A.
Surveyed By: K.S.A. & Assoc.
CL = 1:250000.0000
R.D.V. 1091/905
-016
2.25 A.
-015
14.02 A.
-014
8.33 A.
-002
6.25 A.
-001
34.26 A.
-007
.80 A.
7-25-86
-004
10.18 A.
-017
29.81 A.
30
-009
2.21 A.
-016
1.75 A.
-021
21.35 A.
-013
9.47 A.
-011
24.00 A.
-019
24.99 A.
Pt. -011
Pt. 24.00 A.
APPROVED
LORAIN CO.
MAP DEPT.
DATE 3-18-86
PAGE 15-D
BY C. FRANCIS