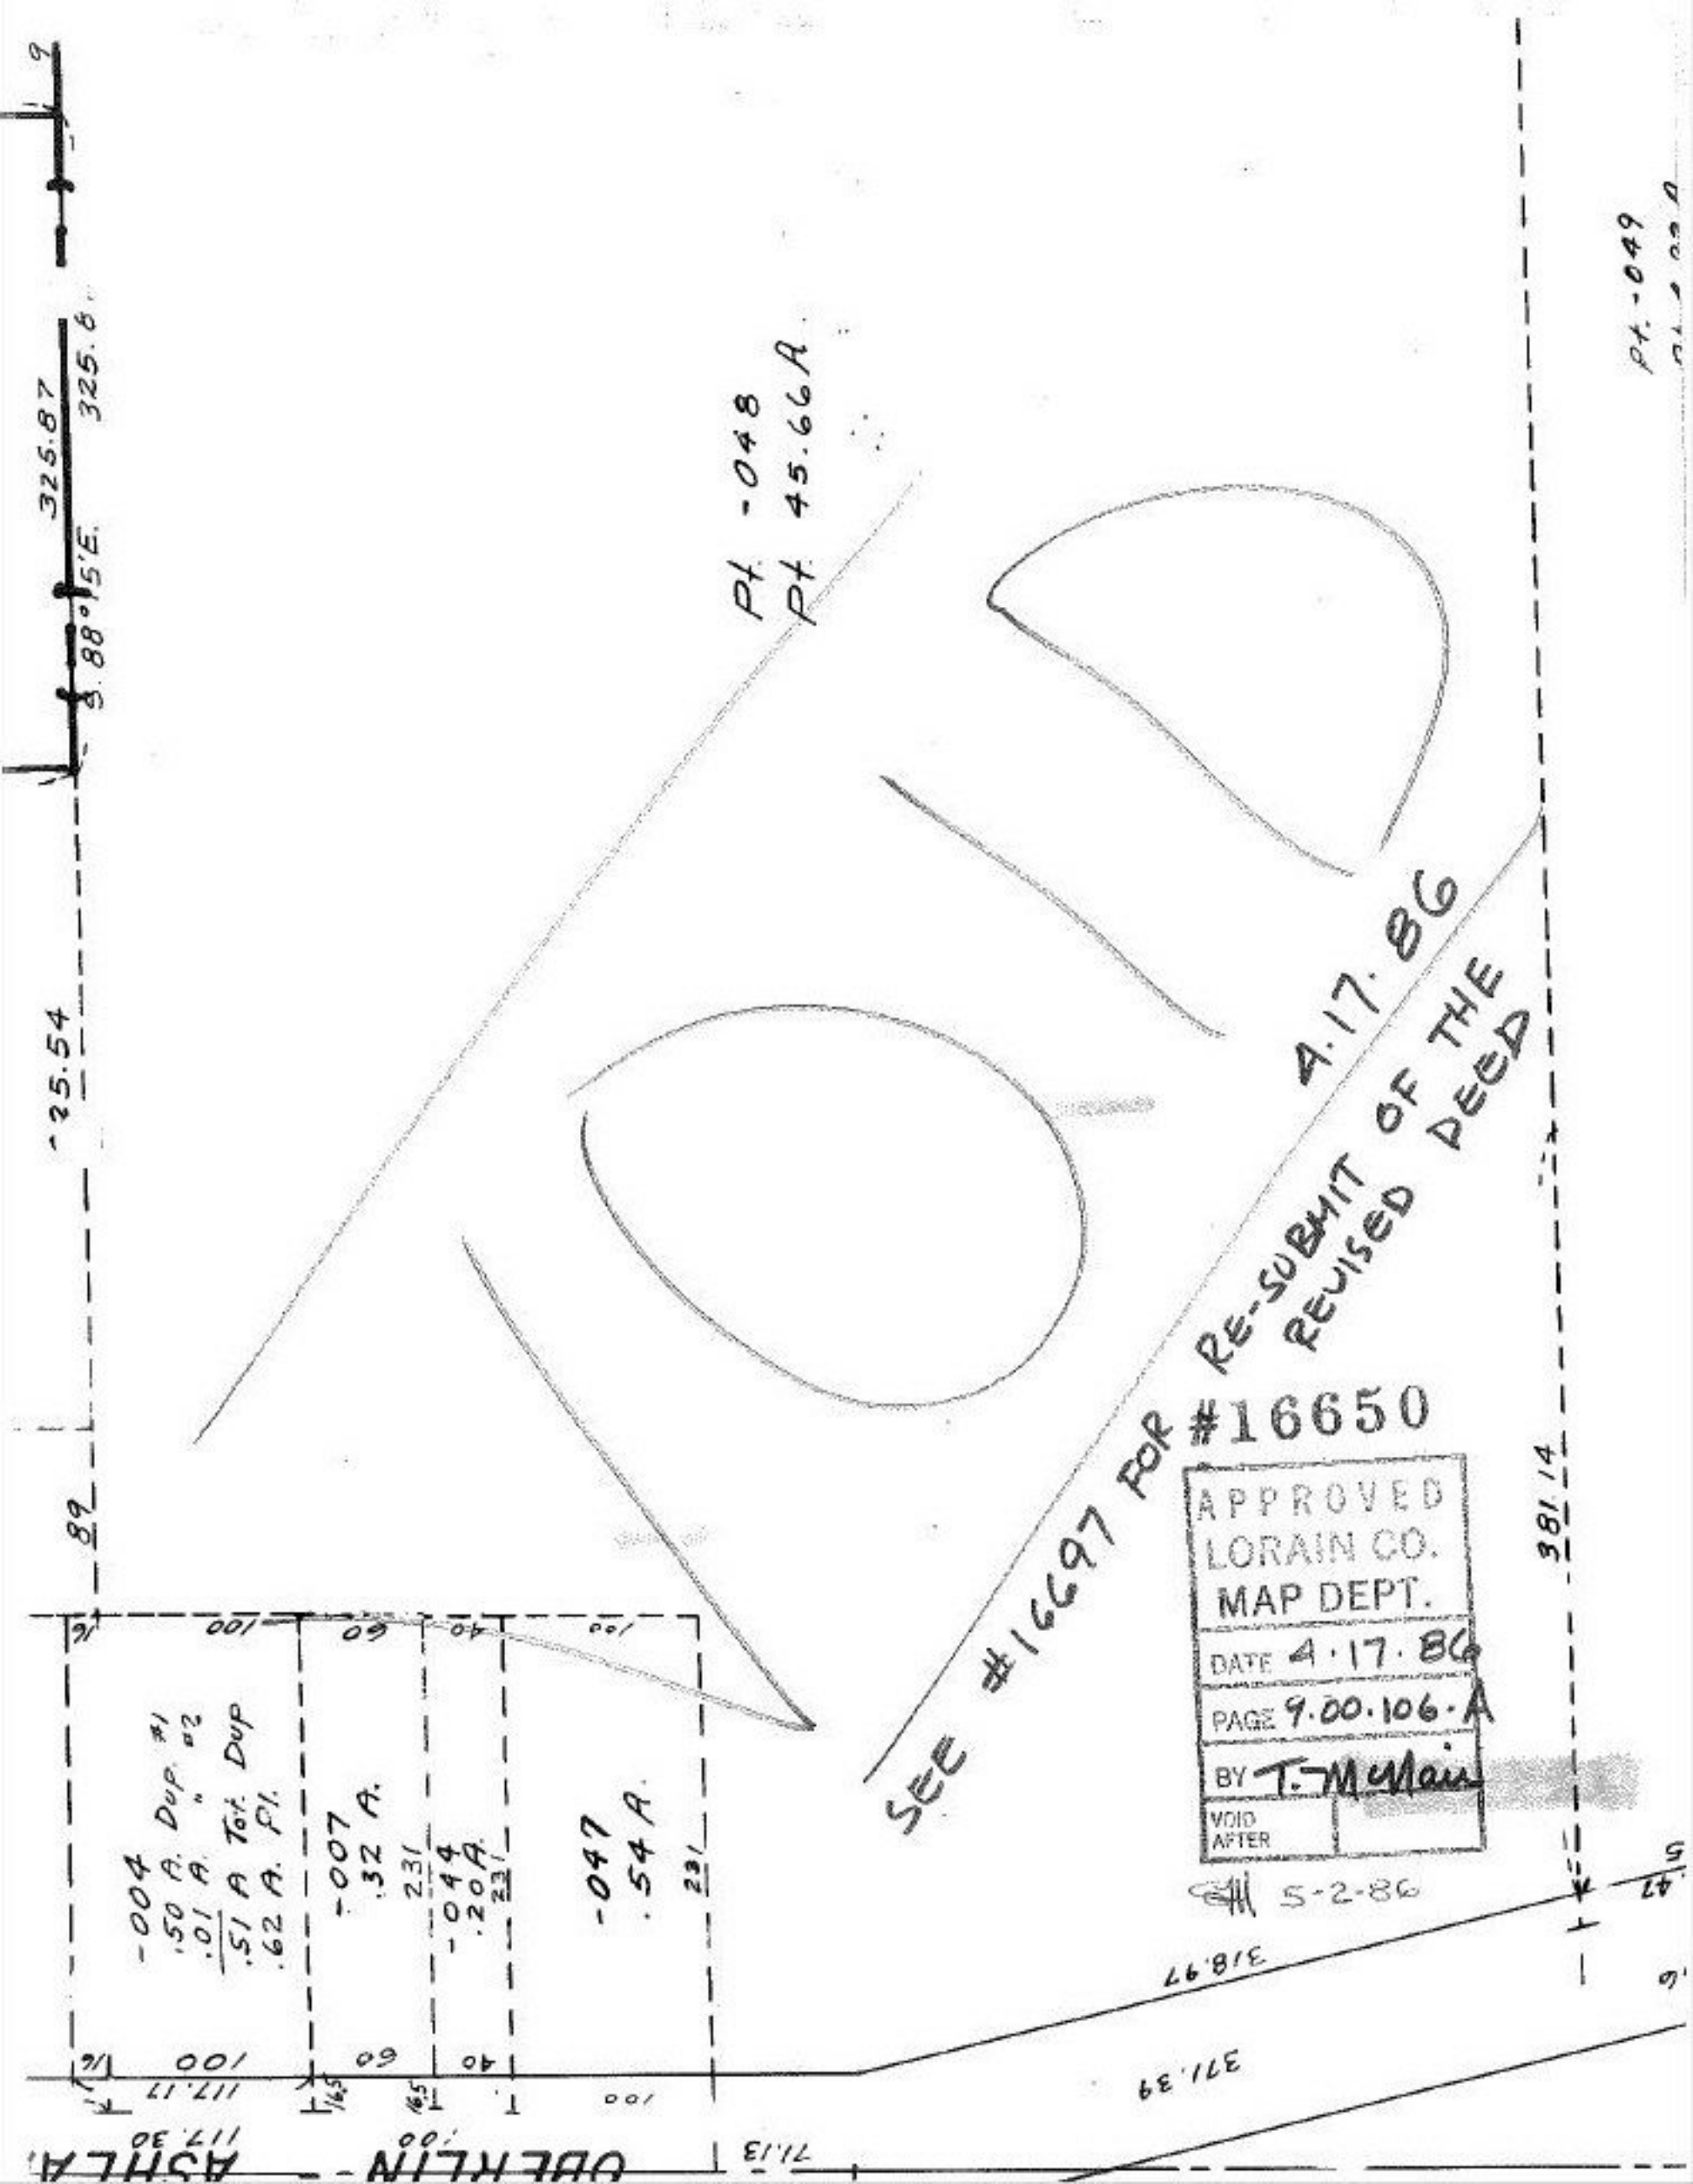

Pt. -048
Pt. 45.66A
SEE #16697 FOR RE-SUBMIT OF THE REVISED DEED
4.17.86
#16650
APPROVED
LORAIN CO.
MAP DEPT.
DATE 4.17.86
PAGE 9.00.106.A
BY T. McNair
VOID AFTER
5-2-86
-004
.50 A. Dup. #1
.01 A. " #2
.51 A Tot. Dup
.62 A. Pl.
-007
.32 A.
-044
.20 A.
-047
.54 A.
325.87
325.8
S. 88° 15' E.
325.54
89
381.14
318.97
371.39
117.17
117.30
71.13
OBERLIN - ASHLA
Pt. -049