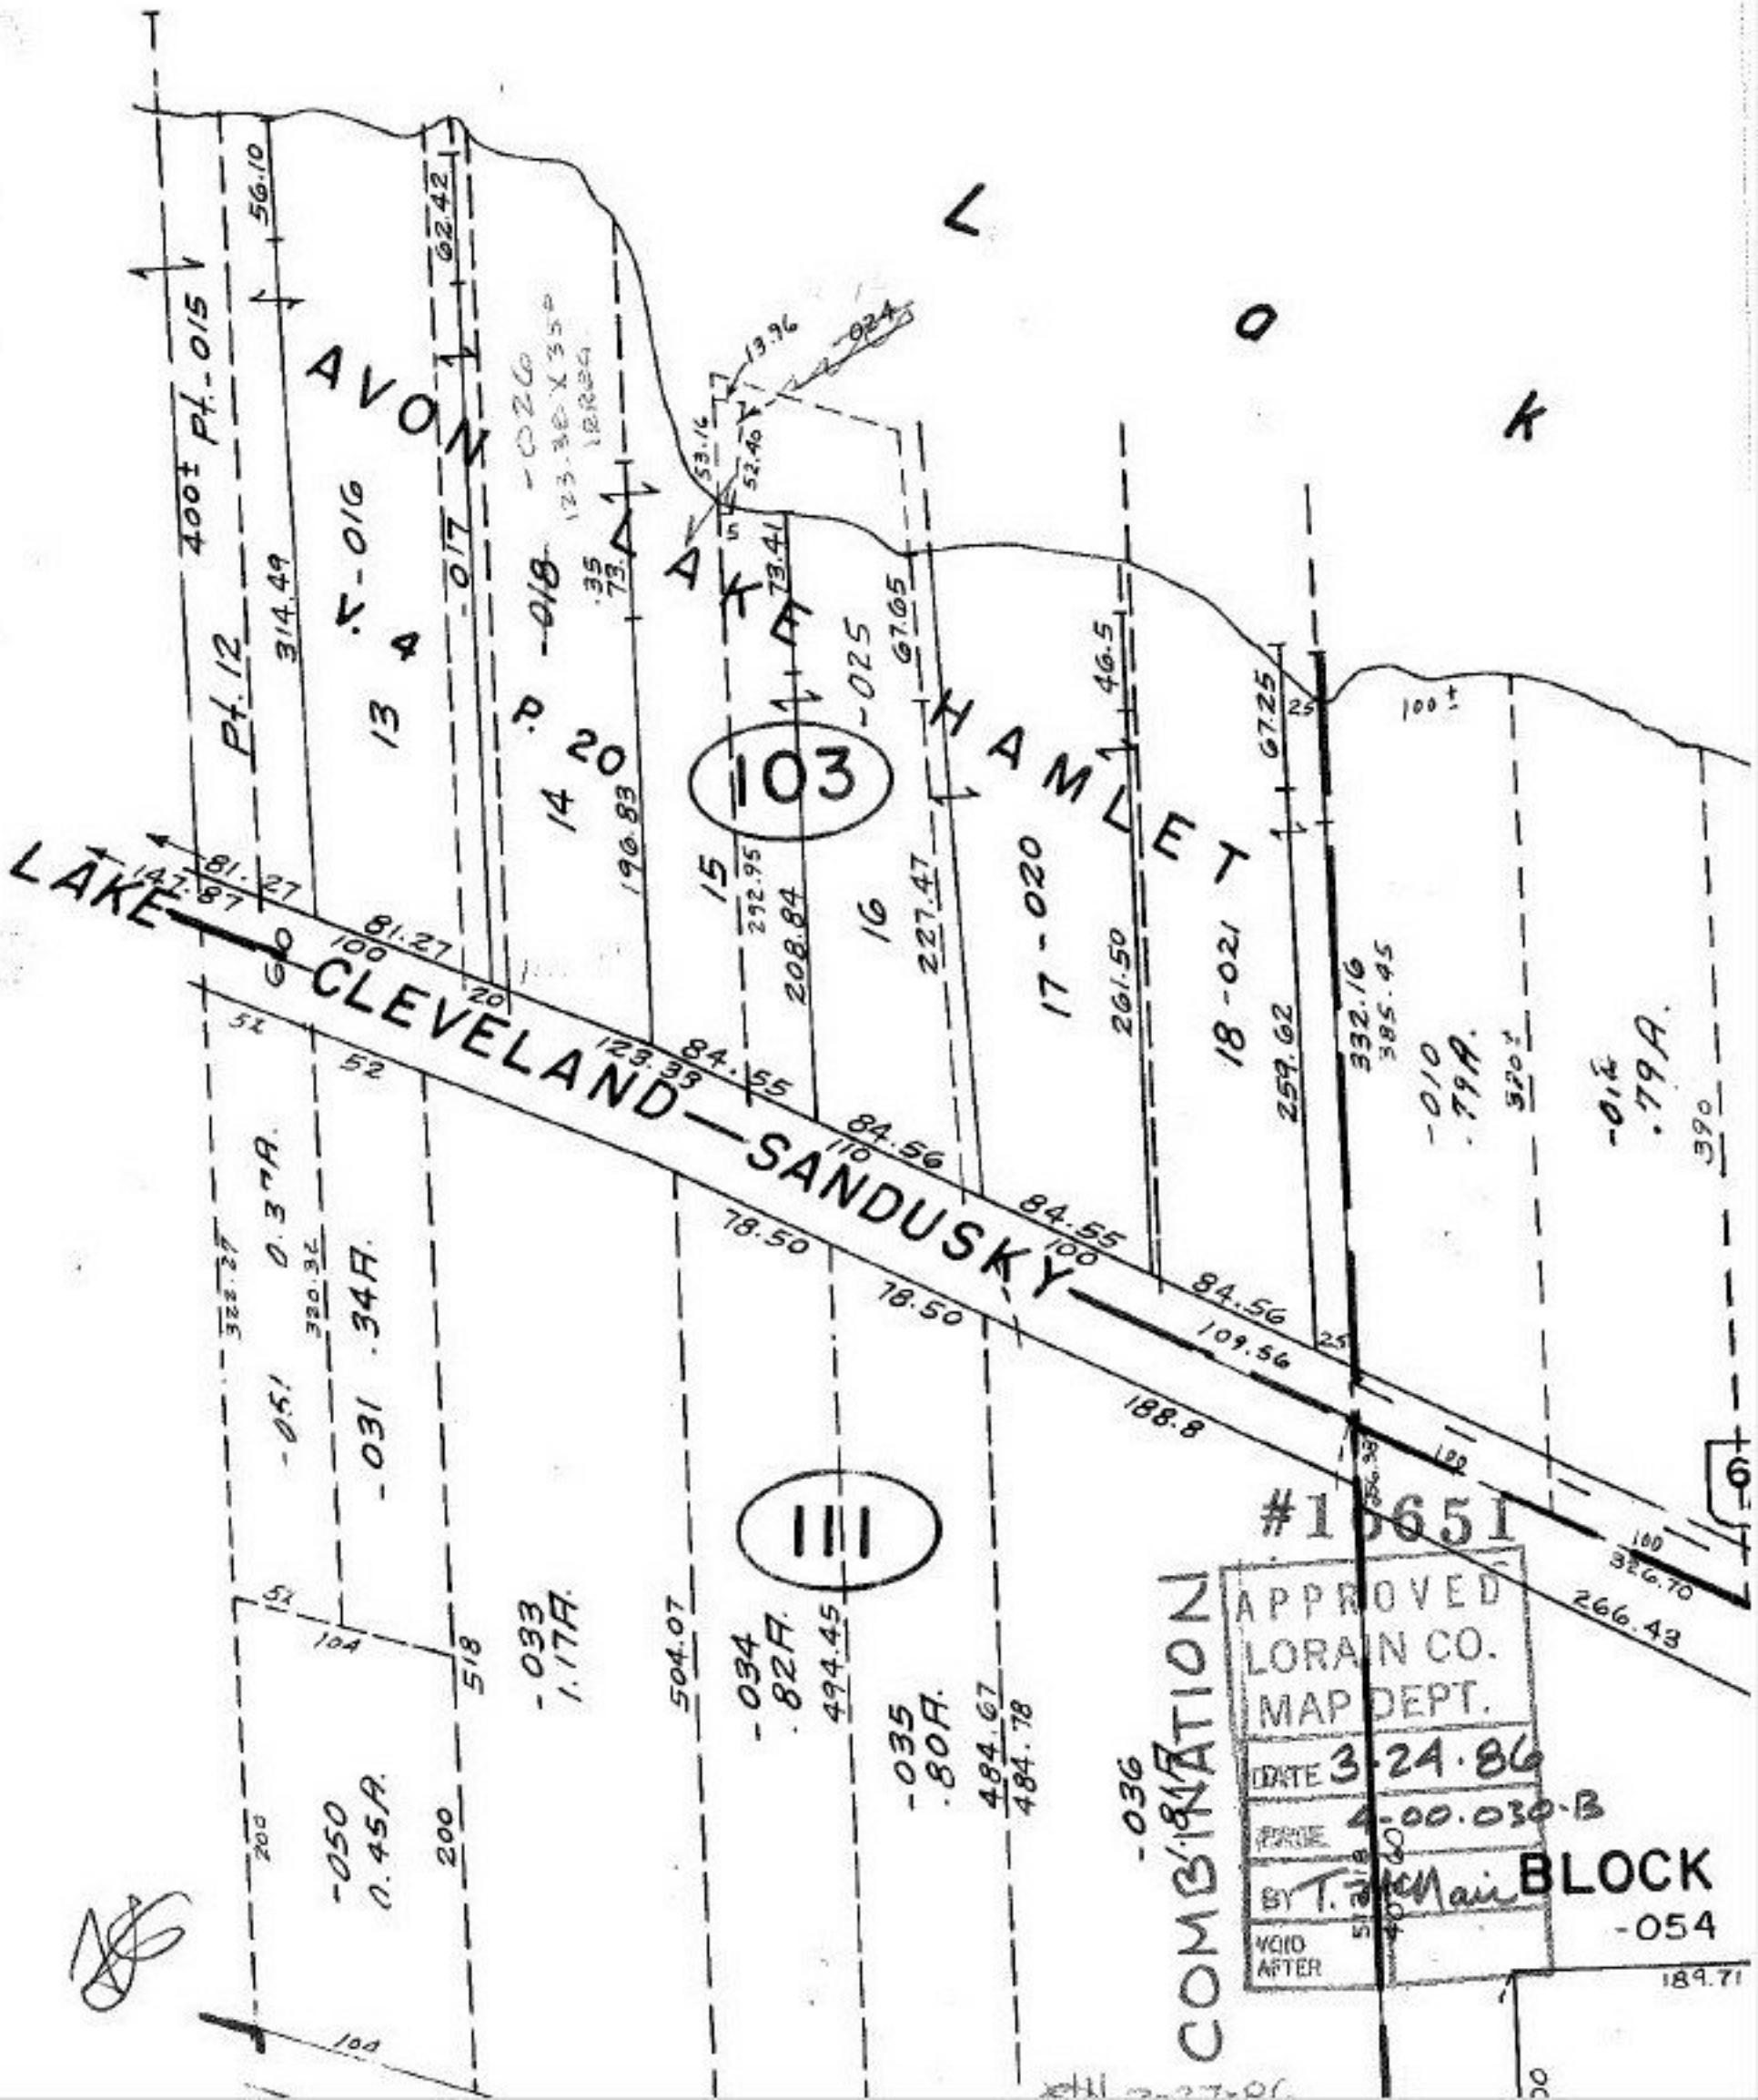
AVON
LAKE
CLEVELAND — SANDUSKY
HAMLET
COMBINATION
103
111
#15651
APPROVED
LORAIN CO.
MAP DEPT.
DATE 3-24-86
BY T. McMain
BLOCK
-054
-031 .34A.
-033 1.17A.
-034 .82A.
-035 .80A.
-036 .84A.
-050 0.45A.
-051 0.37A.
-010 .79A.
-014 .79A.
-017
-018
-020
-021
-024
-025
400± Pt.-015
Pt. 12
314.49
56.10
62.42
123.38 X 35.83
IRREG.
73.41
67.05
46.5
67.25
100±
147.87
81.27
100
20
123.39
84.55
84.56
110
78.50
18.50
188.8
109.56
25
208.84
227.47
261.50
259.62
332.16
385.45
320±
390
504.07
494.45
484.67
484.78
518
200
104
51
52
266.43
326.70
189.71
6