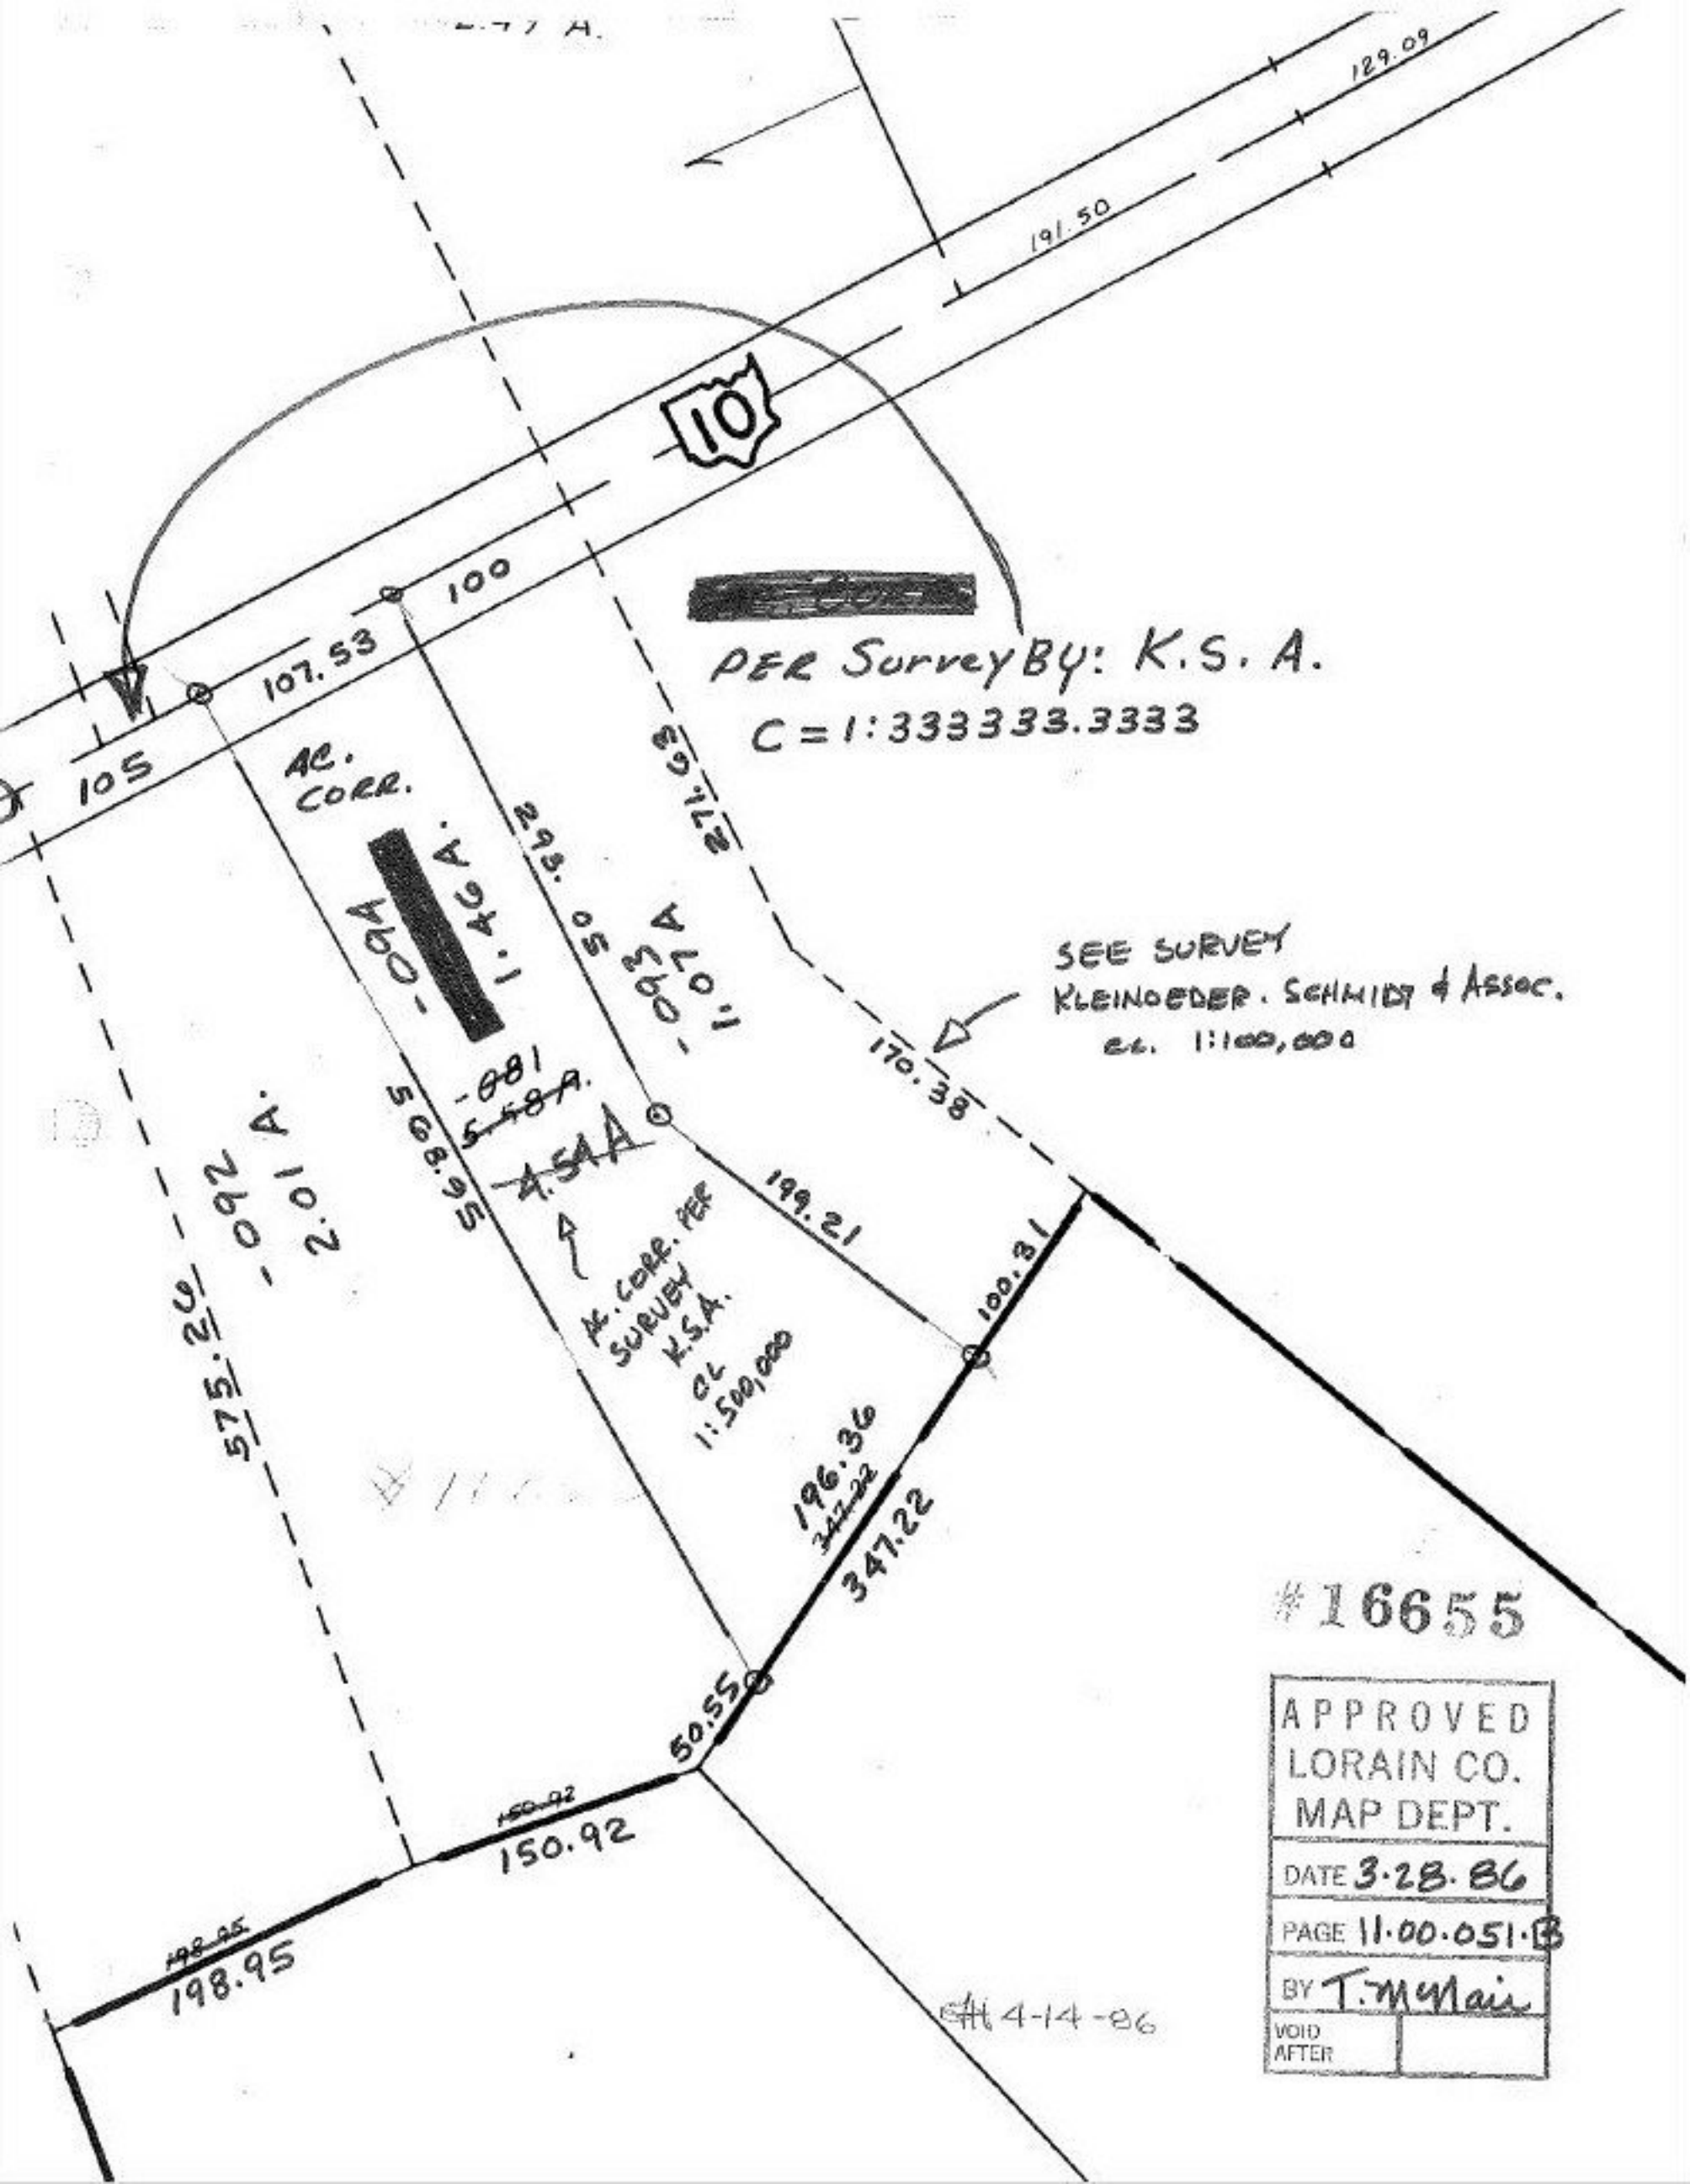

129.09
191.50
10
100
107.53
105
[redacted]
PER Survey By: K.S.A.
C = 1:333333.3333
AC. CORR.
-094 [redacted] 1.46 A.
293.50
271.63
-093 1.07 A
SEE SURVEY
KLEINOEDER. SCHMIDT & ASSOC.
CL. 1:100,000
170.38
-081 ~~5.58 A.~~
~~4.54 A~~
568.95
-092 2.01 A.
575.26
199.21
100.31
AC. CORR. PER SURVEY K.S.A. CL 1:500,000
196.36
~~347.22~~
347.22
50.55
~~150.92~~
150.92
~~198.95~~
198.95
#16655
APPROVED
LORAIN CO.
MAP DEPT.
DATE 3.28.86
PAGE 11.00.051.B
BY T. McNair
VOID AFTER
4-14-86