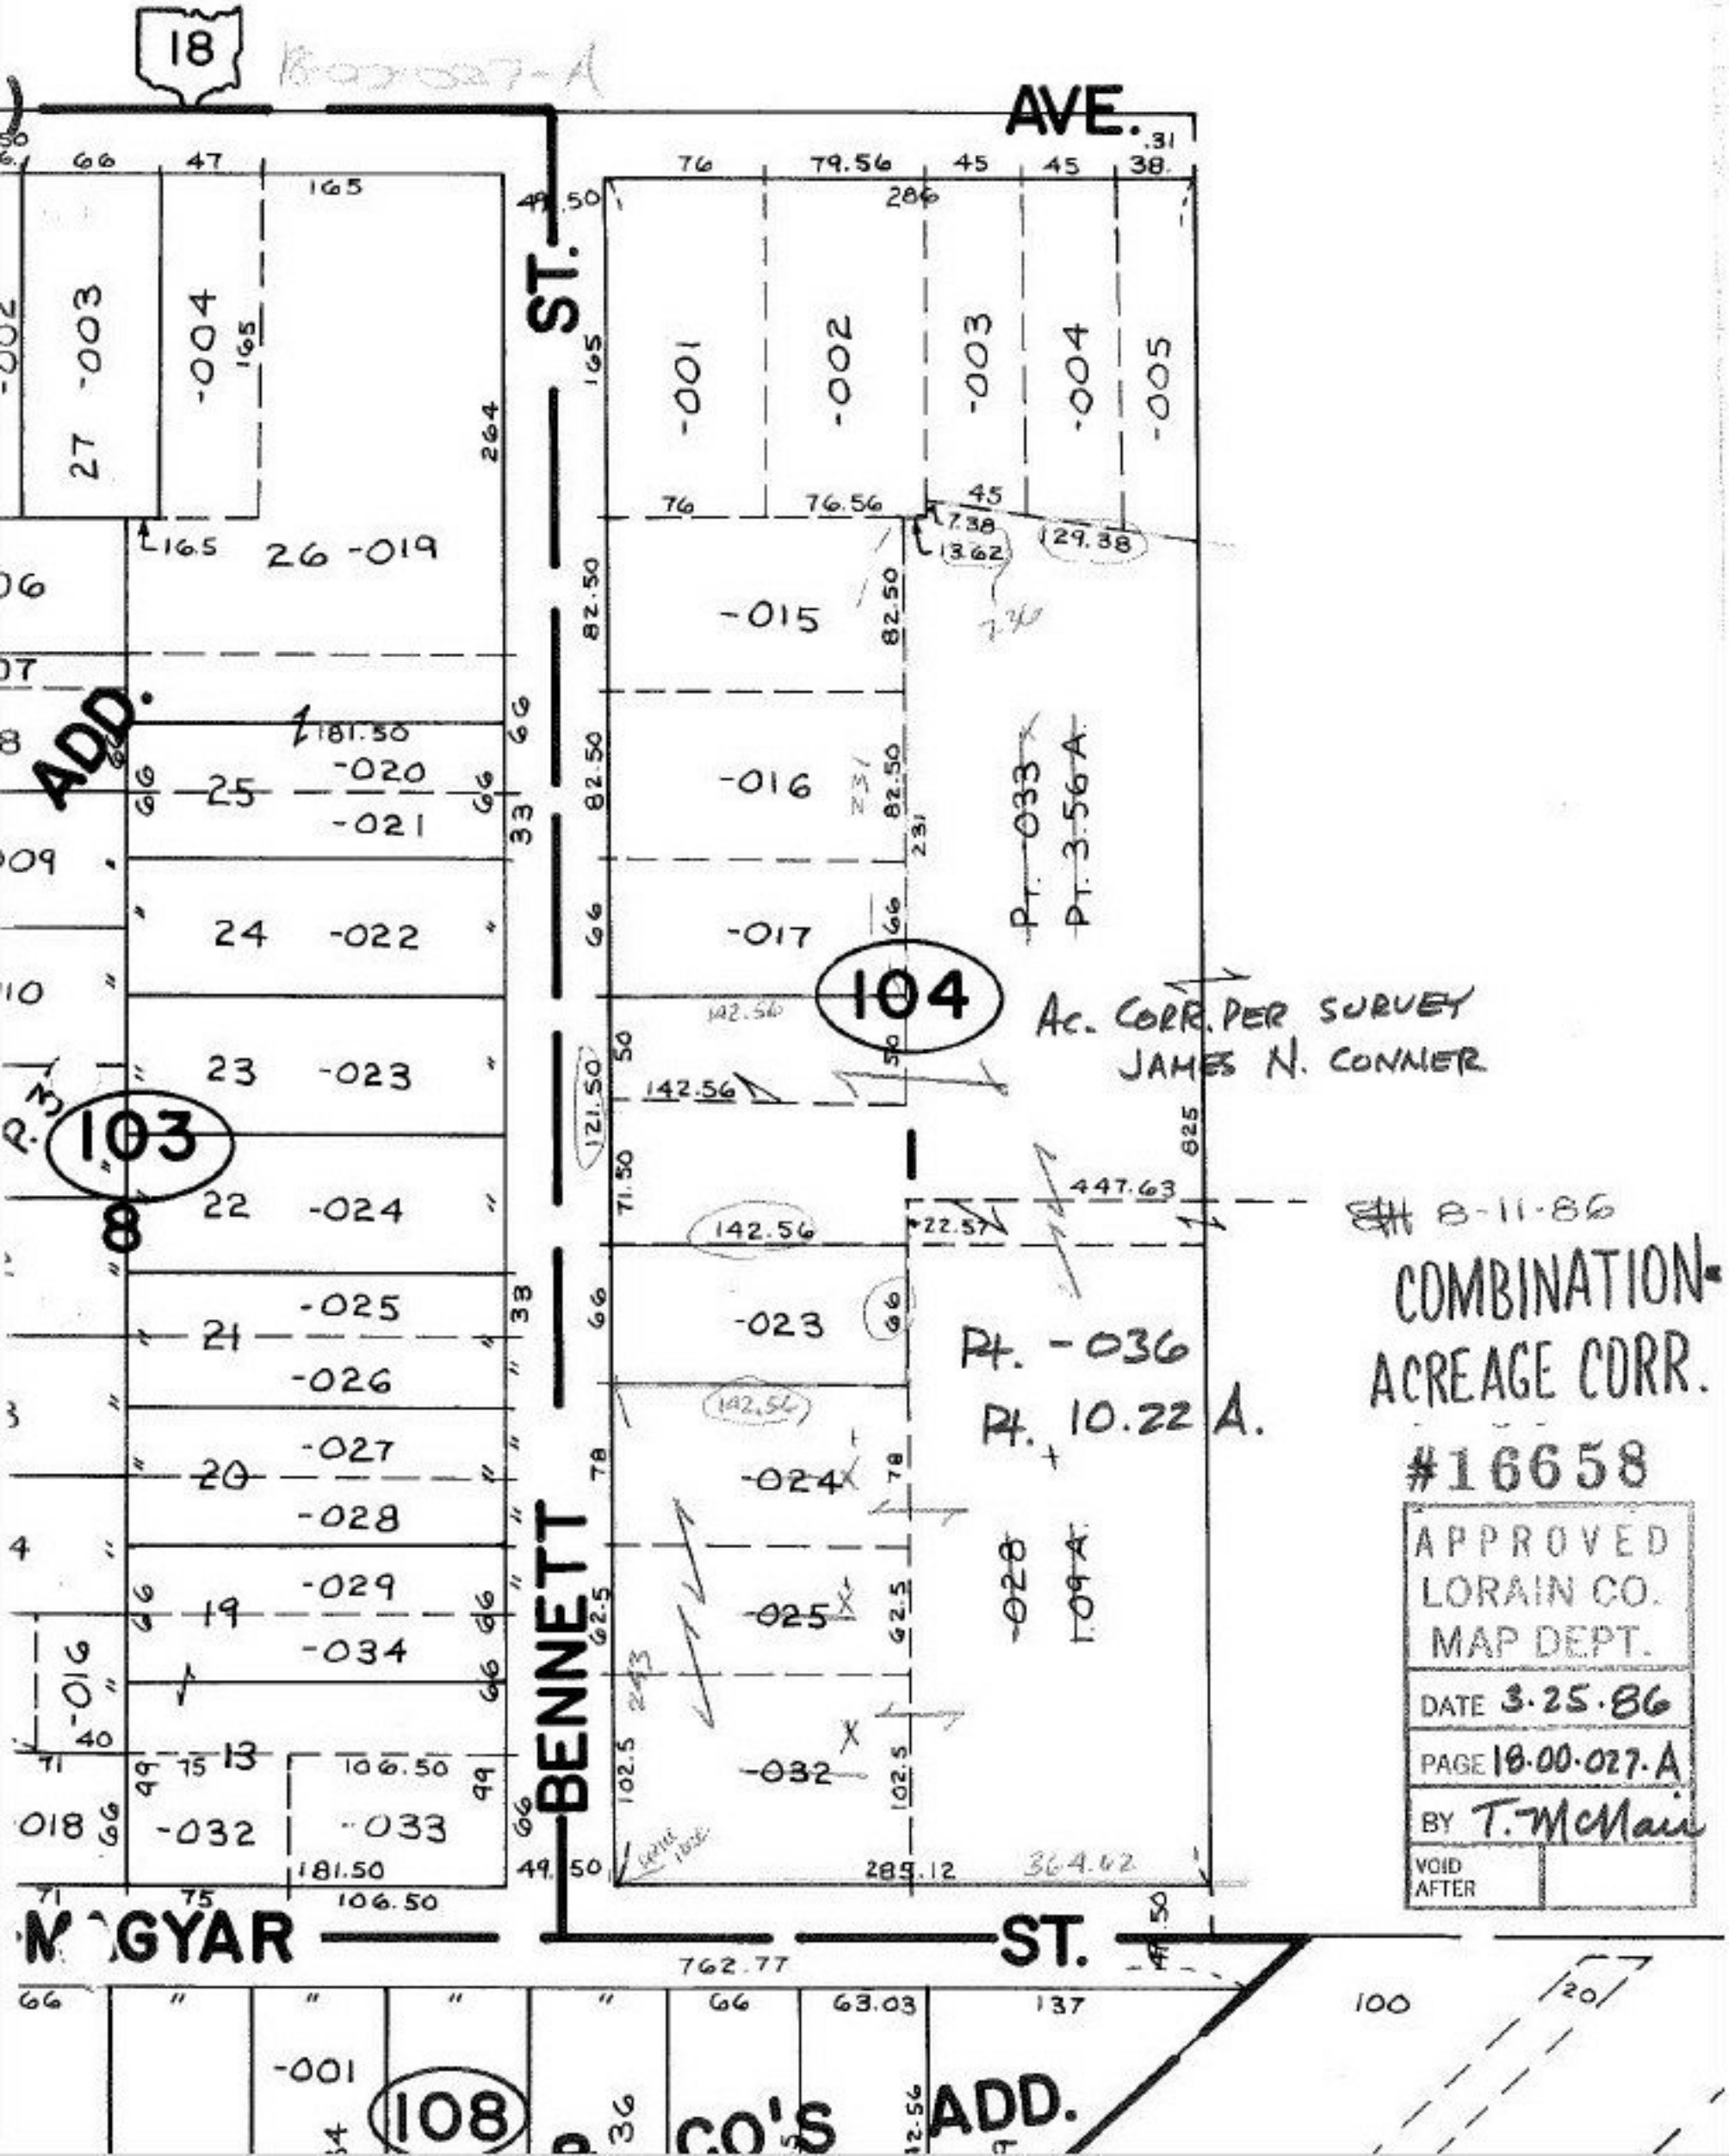
18
AVE.
ST.
BENNETT
ADD.
MAGYAR
ST.
CO'S
ADD.
103
104
108
Ac. CORR. PER SURVEY
JAMES N. CONNER
8-11-86
COMBINATION-
ACREAGE CORR.
#16658
APPROVED
LORAIN CO.
MAP DEPT.
DATE 3.25.86
PAGE 18.00.027.A
BY T. McNair
VOID
AFTER
Pt. -036
Pt. 10.22 A.
Pt. -033
Pt. 3.56 A.
26 -019
25 -020
-021
24 -022
23 -023
22 -024
21 -025
-026
20 -027
-028
19 -029
-034
13 -032
-033
-001
-002
-003
-004
-005
-015
-016
-017
-023
-024
-025
-032
-028
1.09 A.
447.63
142.56
121.50
285.12
364.62
762.77
181.50
106.50
49.50
100
20