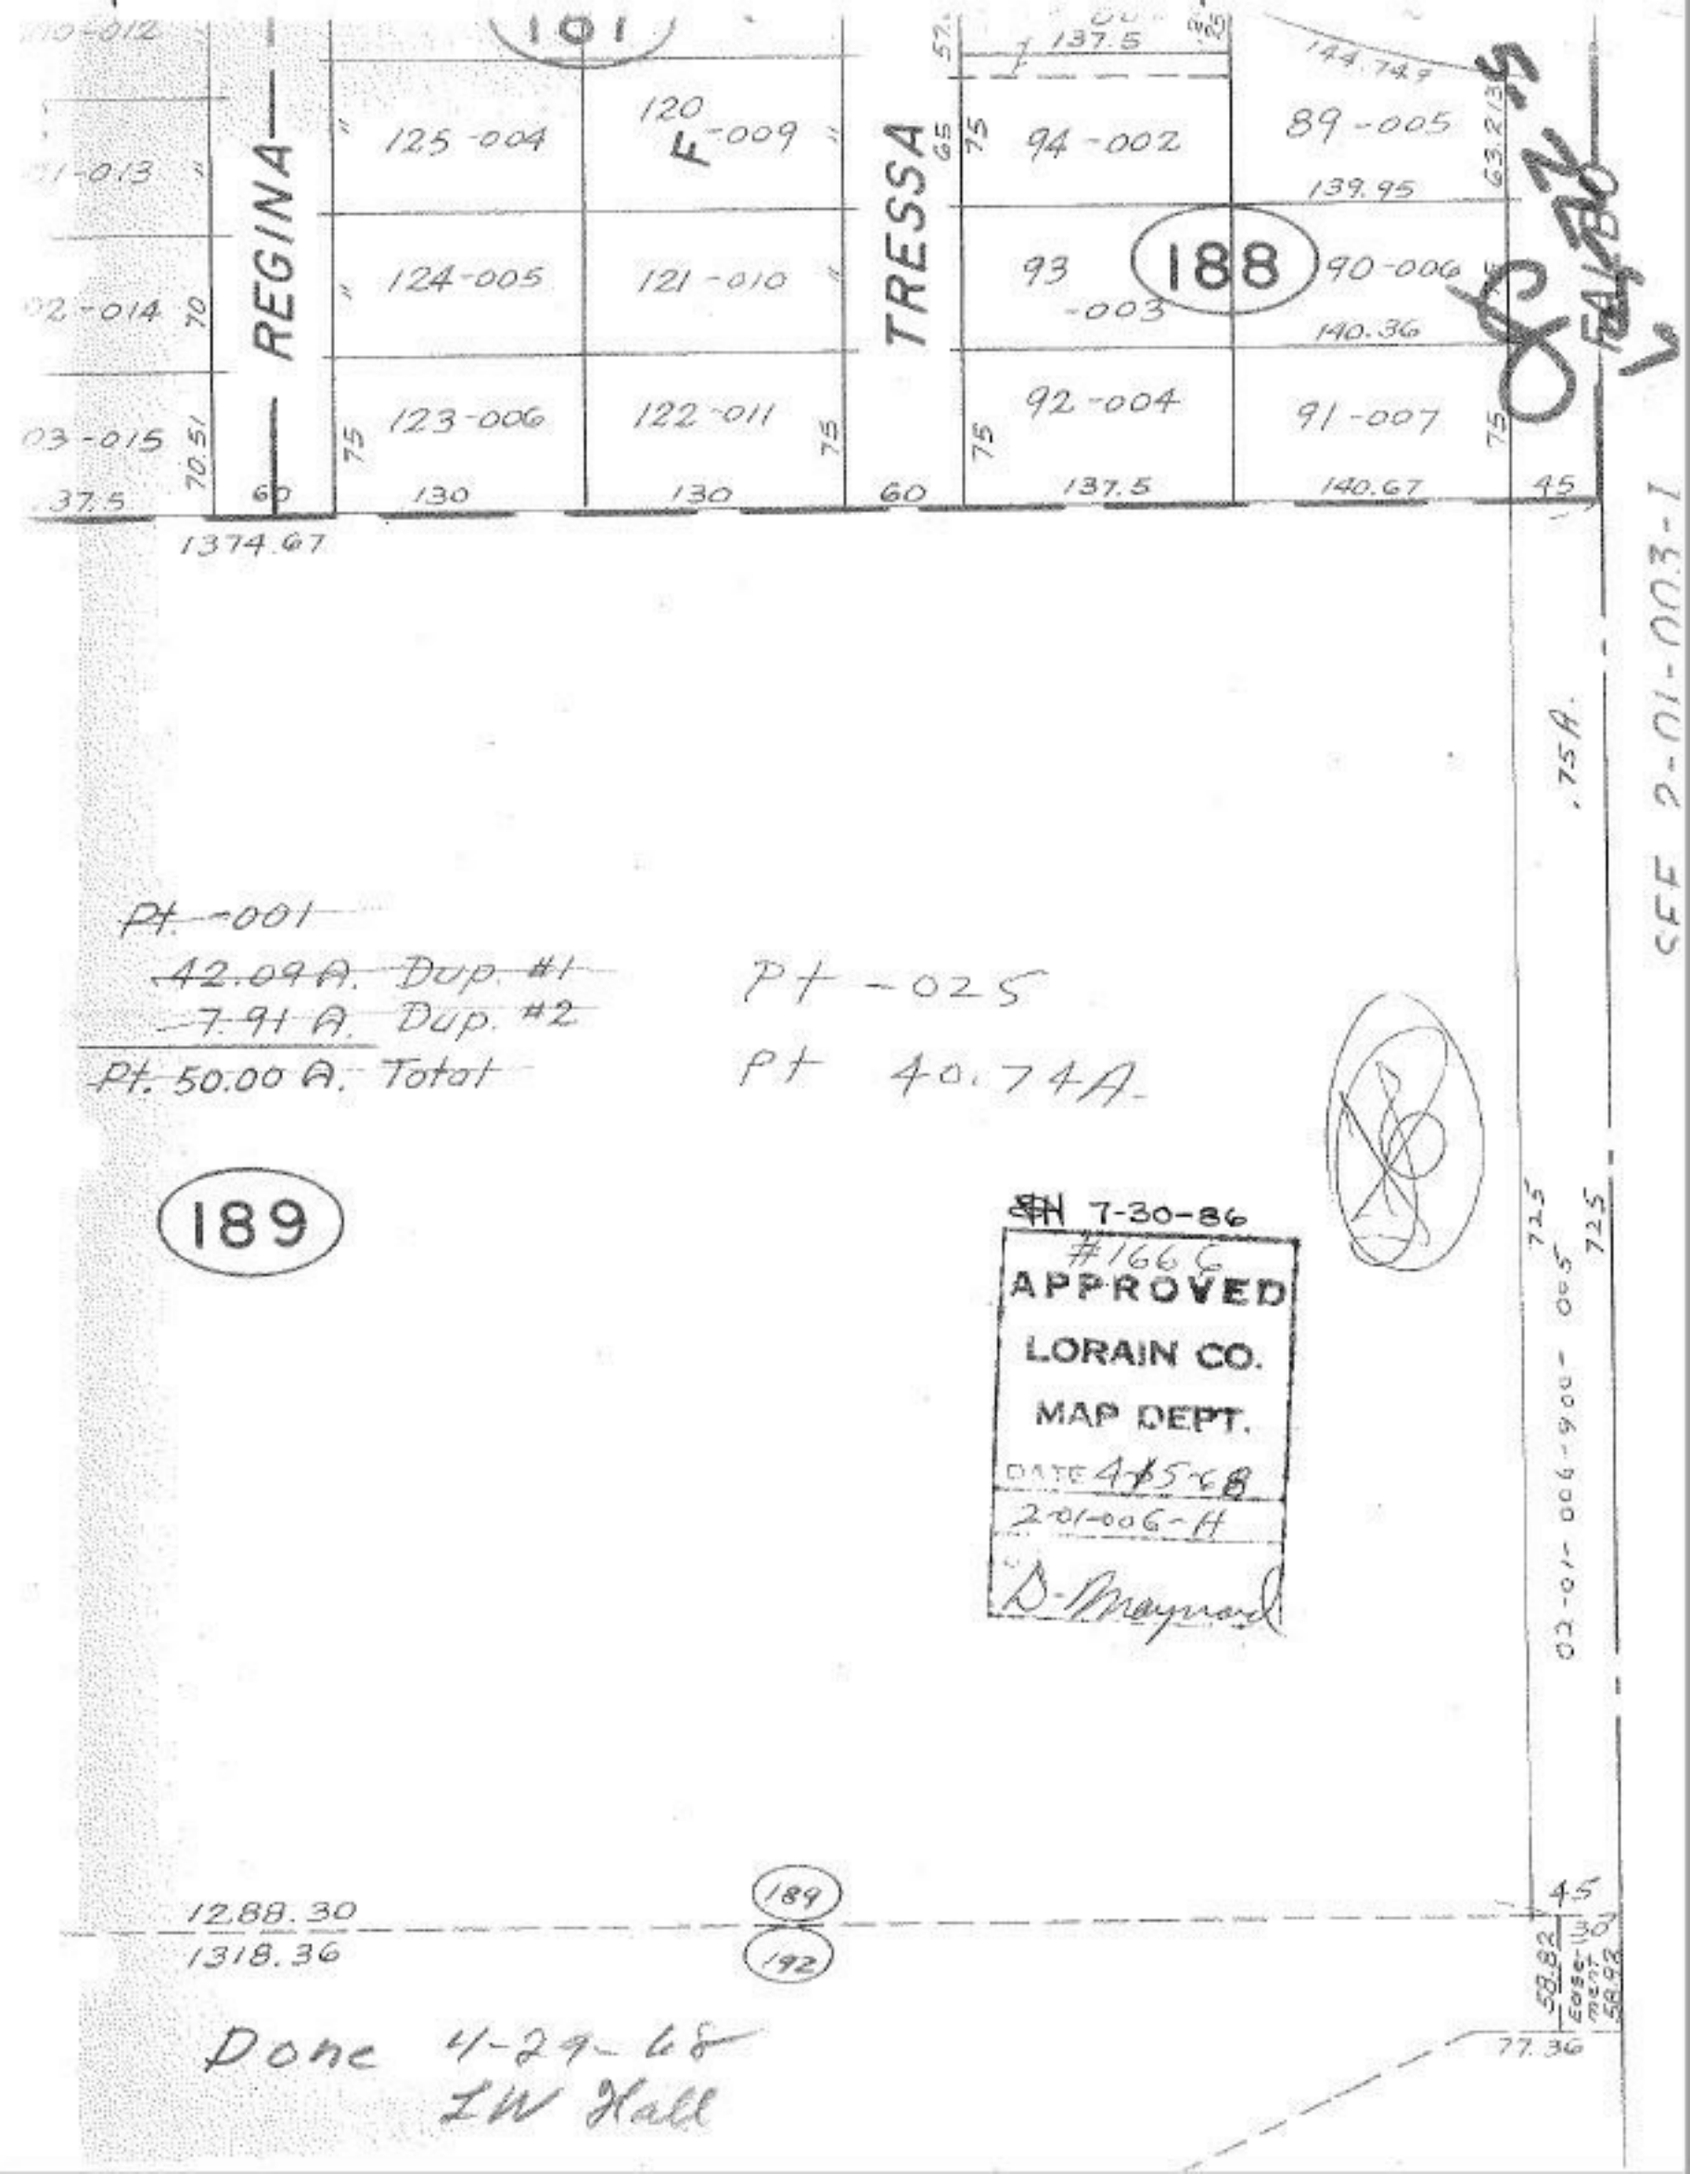
101
REGINA
TRESSA
125-004
120 F-009
124-005
121-010
123-006
122-011
94-002
89-005
93-003
188
90-006
92-004
91-007
137.5
139.95
140.36
140.67
144.74
1374.67
Pt-001
42.09 A. Dup. #1
7.91 A. Dup. #2
Pt. 50.00 A. Total
Pt-025
Pt 40.74A.
189
SH 7-30-86
#1666
APPROVED
LORAIN CO.
MAP DEPT.
DATE 4/5/88
2-01-006-H
D. Maynard
.75A.
02-01-006-900-005
12.88.30
1318.36
192
Done 4-29-68
IW Hall
SEE 2-01-003-1