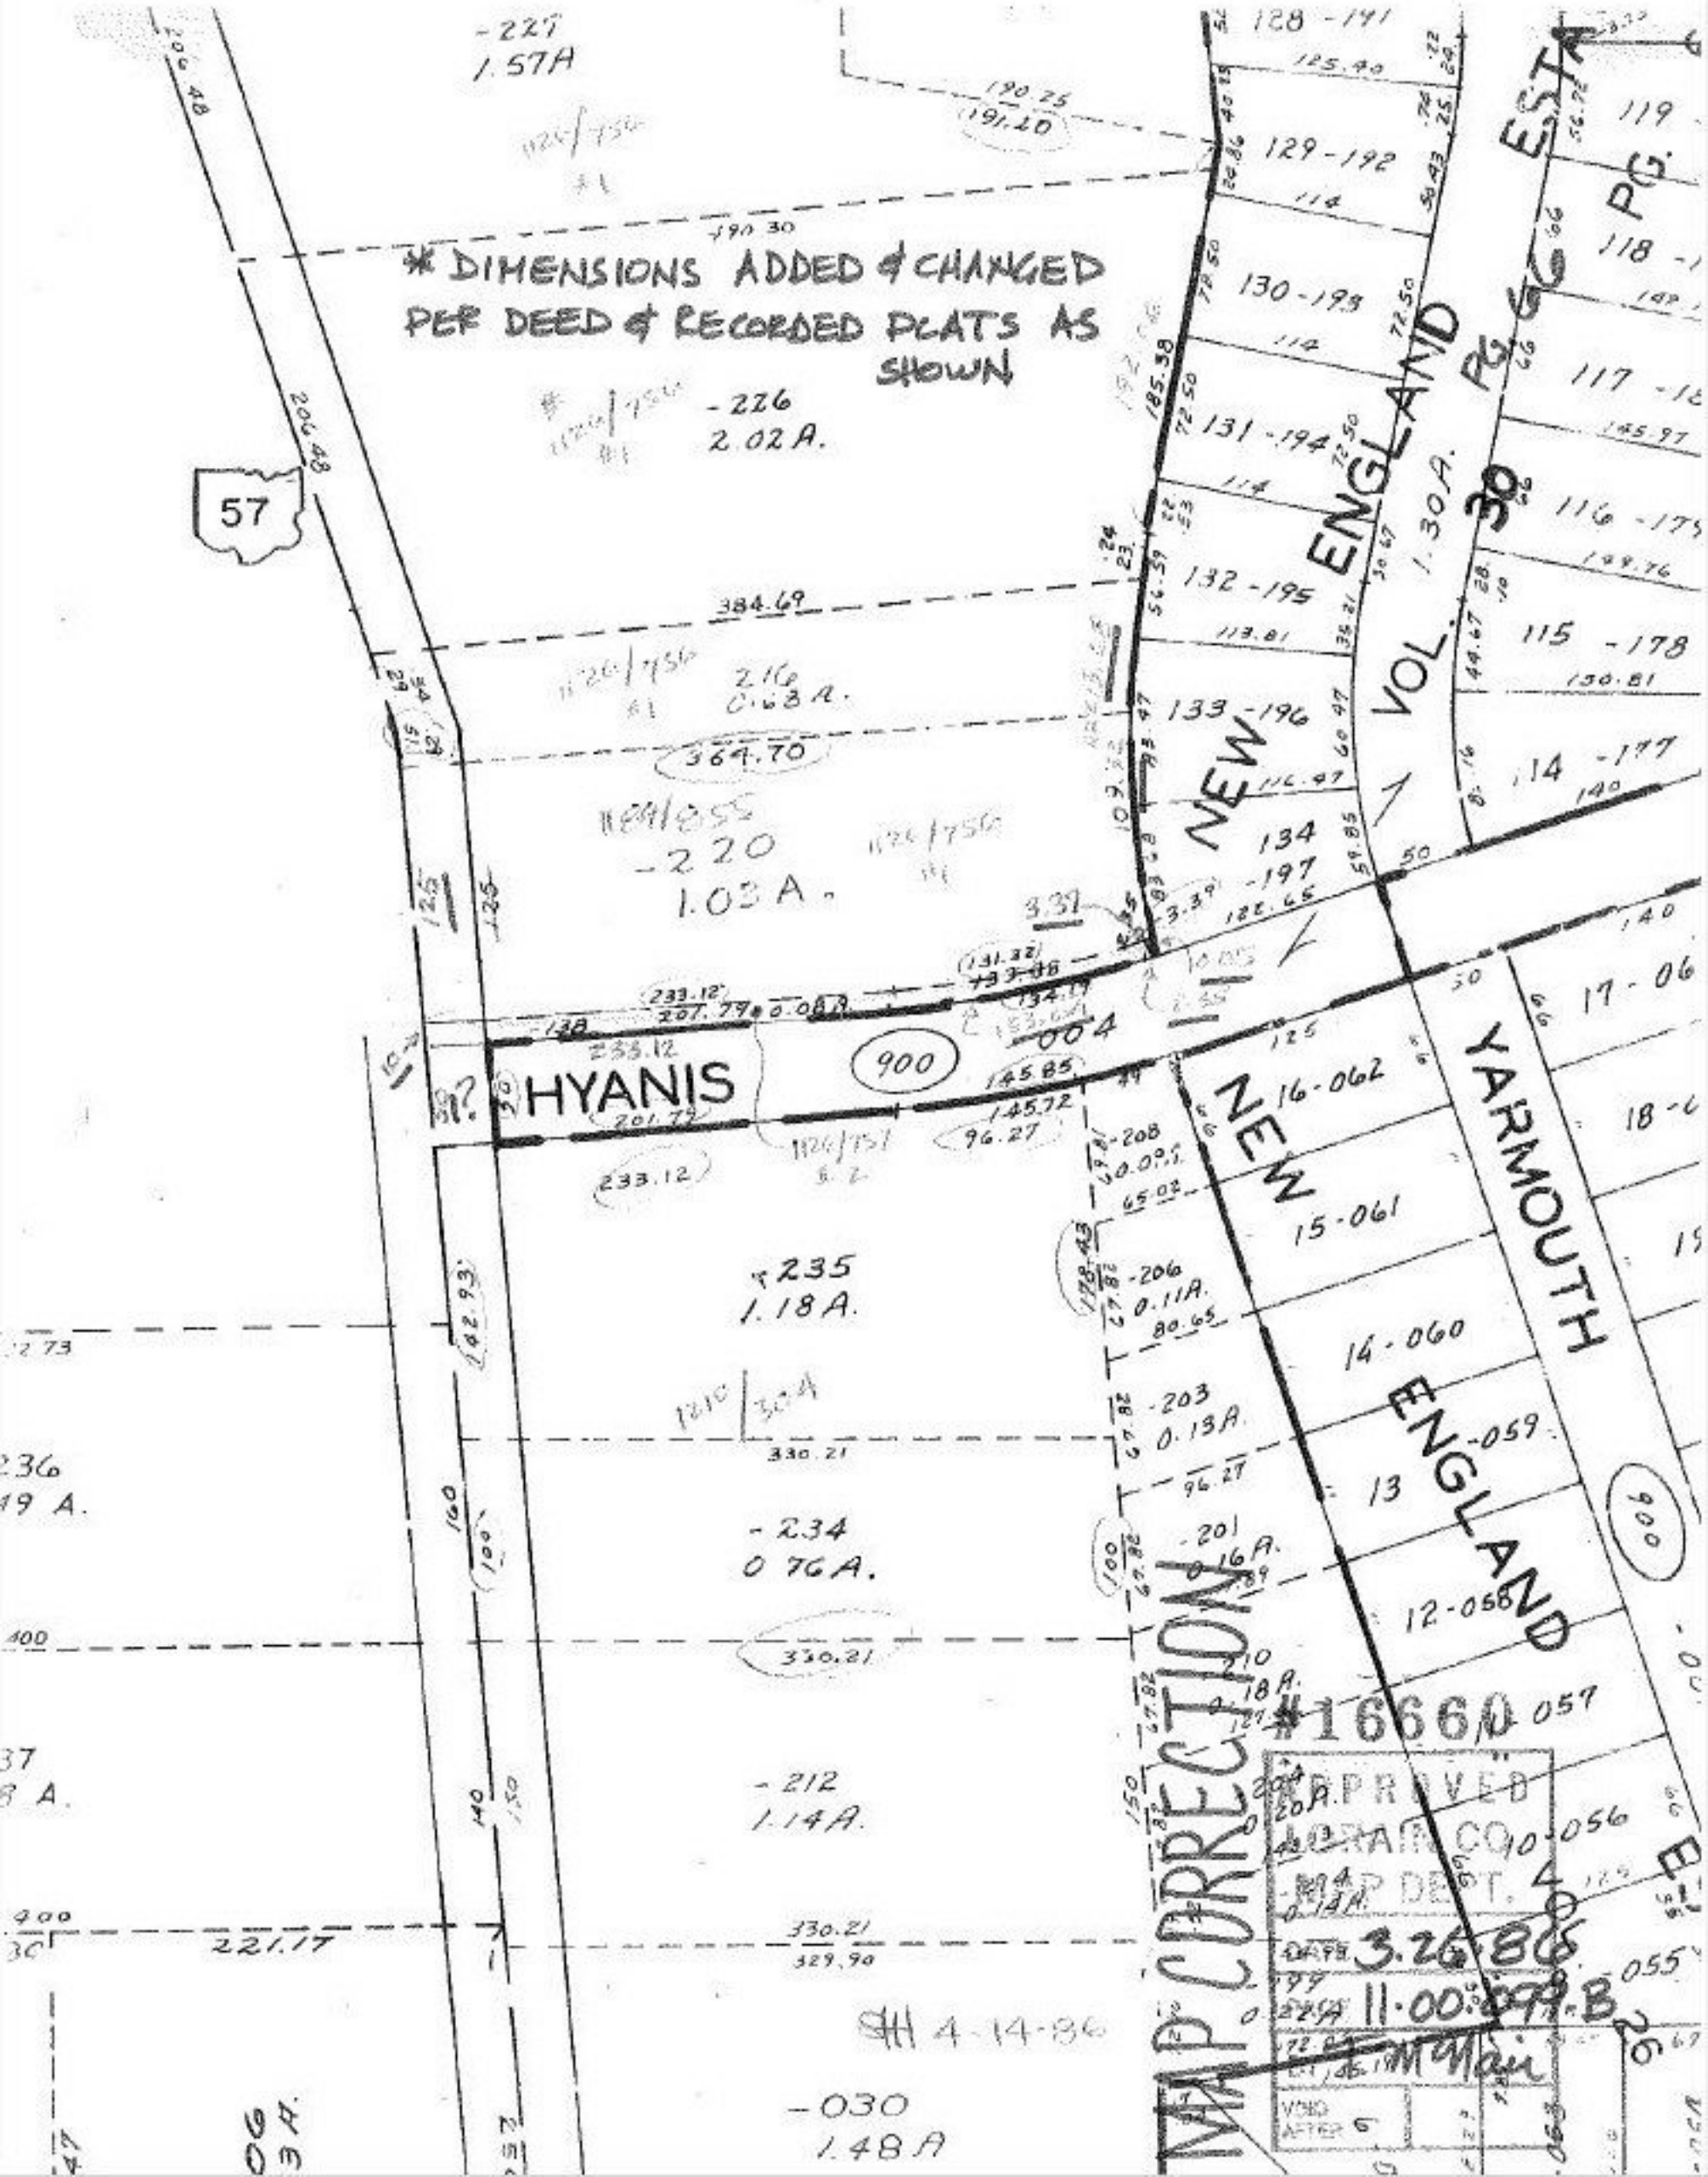

* DIMENSIONS ADDED & CHANGED PER DEED & RECORDED PLATS AS SHOWN
57
HYANIS
900
NEW ENGLAND
VOL. 30 PG. 66
YARMOUTH
ESTA
MAP CORRECTION
#16660
APPROVED
LORAIN CO.
MAP DEPT.
DATE 3.26.86
PAGE 11.00.099.B
VOID AFTER
-227
1.57A
-226
2.02A.
-220
1.03A.
-235
1.18A.
-234
0.76A.
-212
1.14A.
-030
1.48A
4-14-86