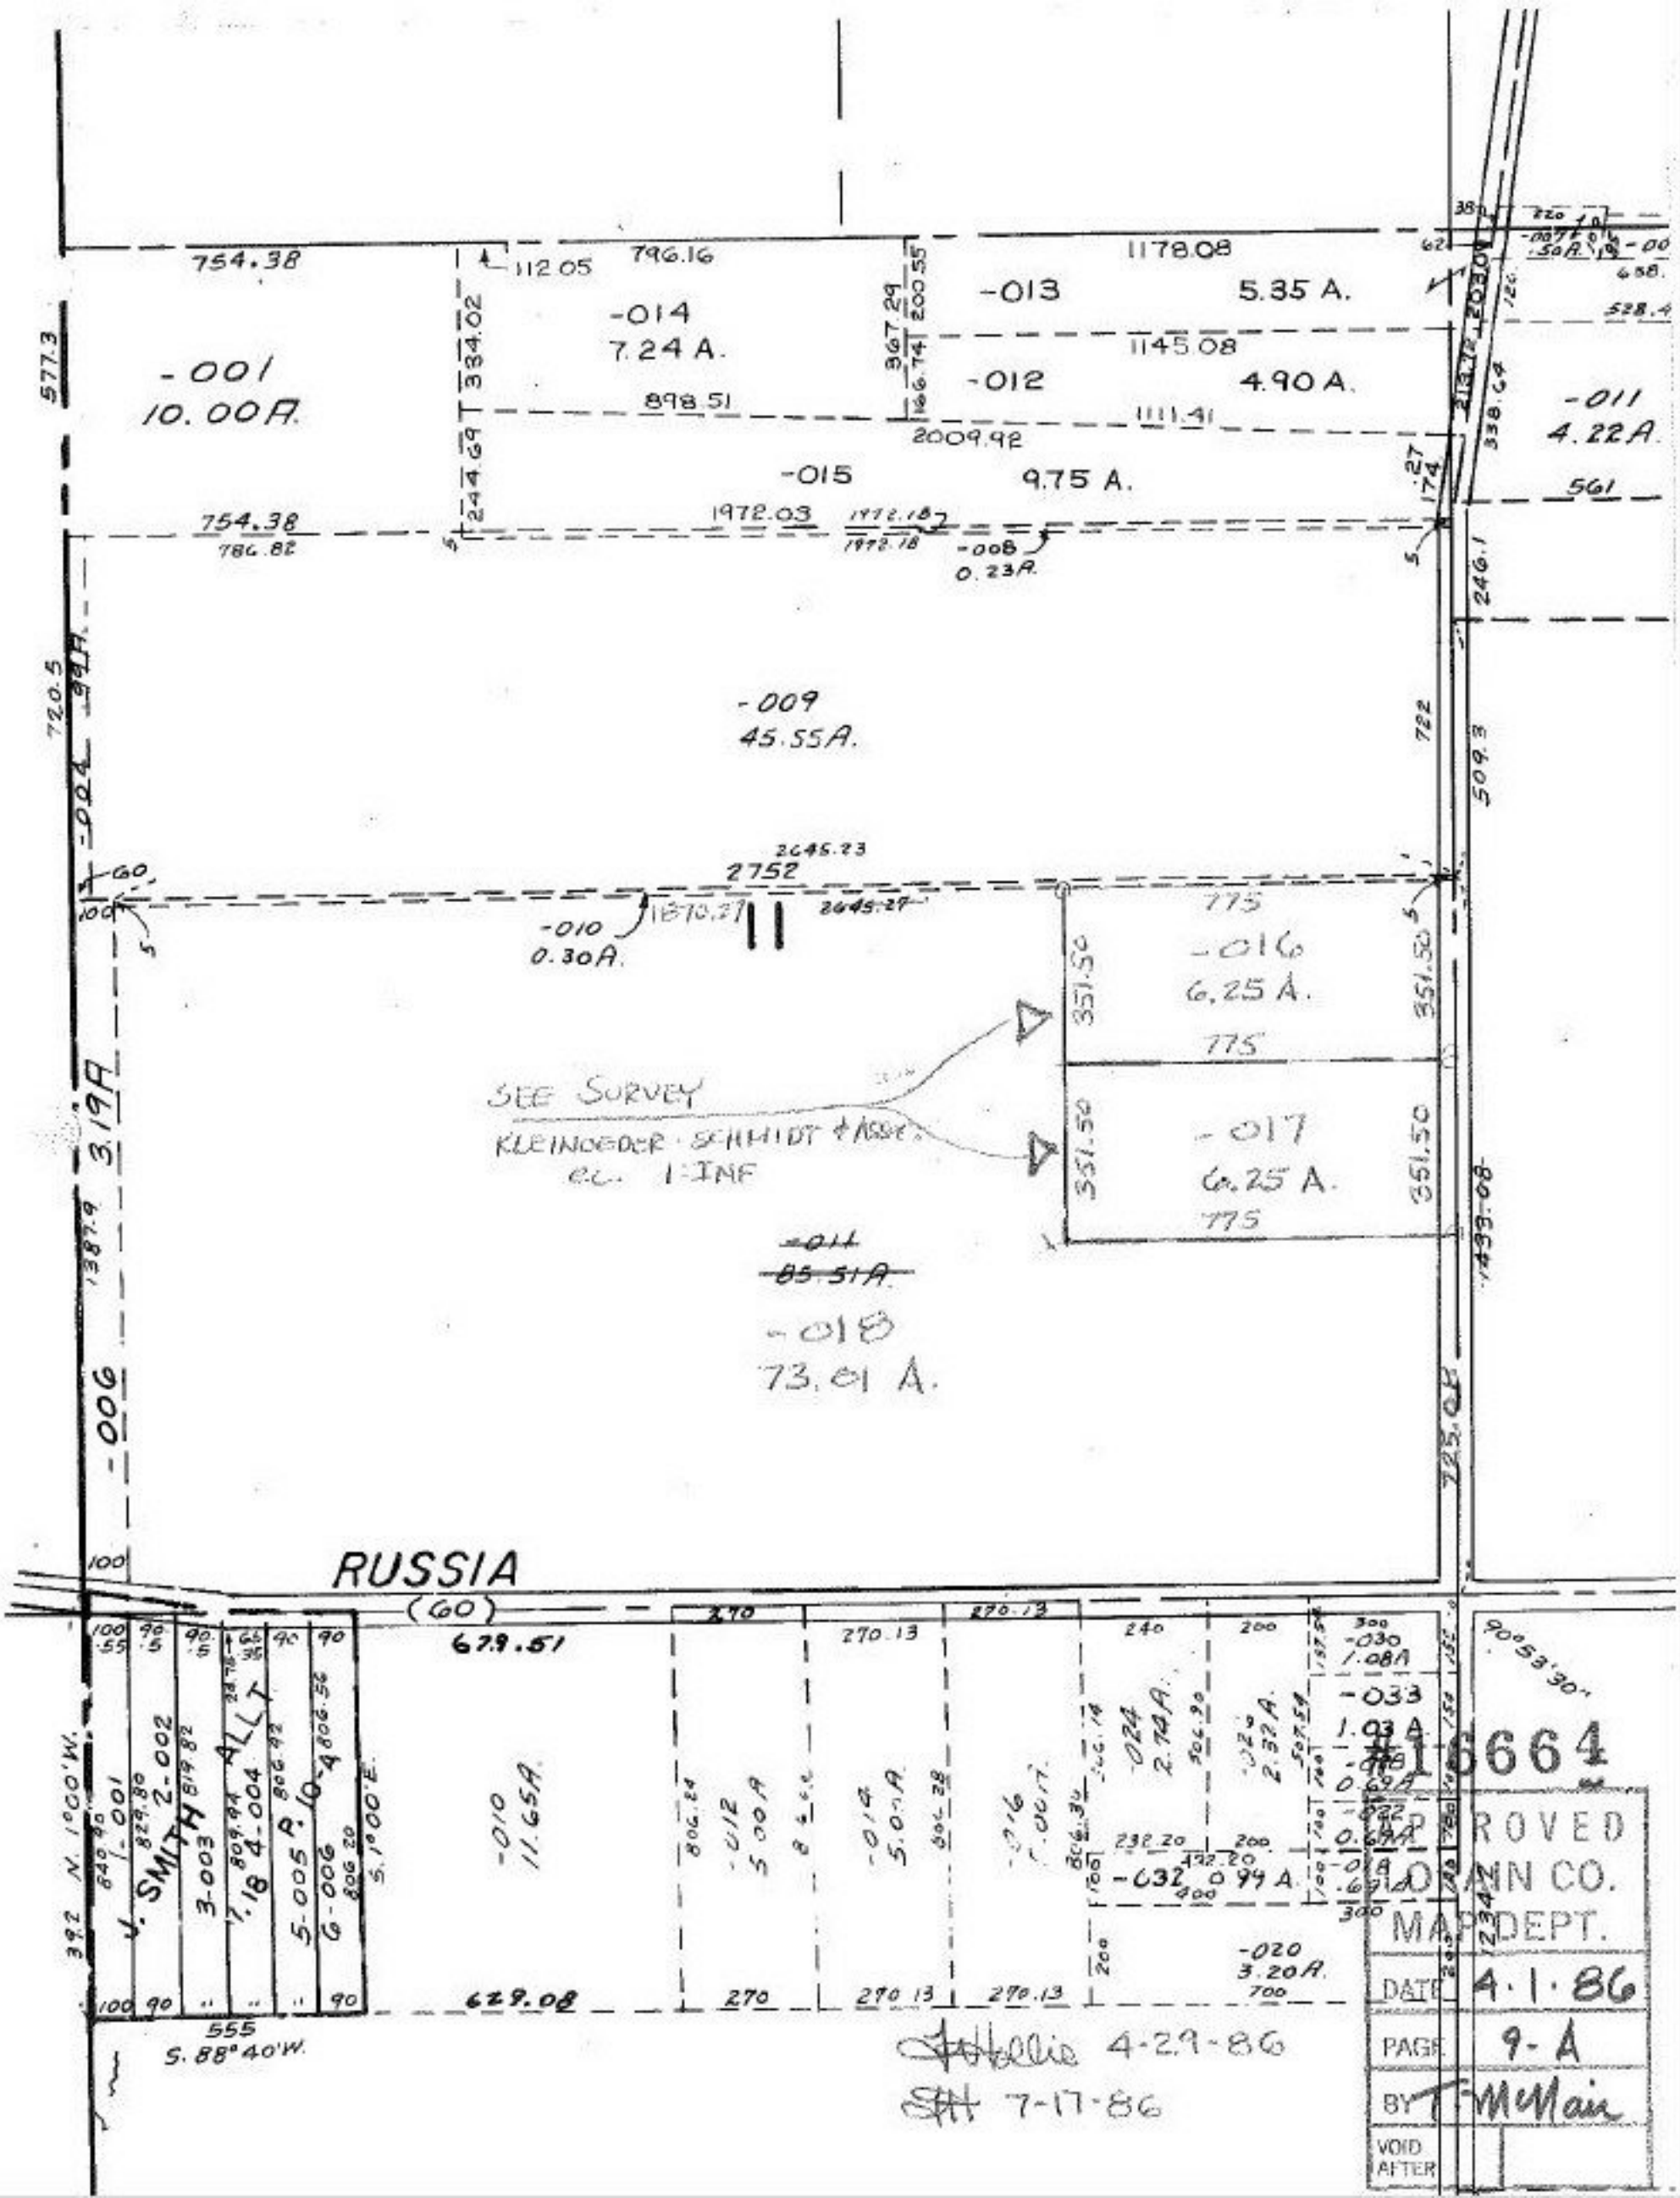

754.38
112.05
796.16
1178.08
-013
5.35 A.
-014
7.24 A.
334.02
367.29
200.55
166.74
1145.08
-012
4.90 A.
-001
10.00A.
898.51
1111.41
2009.92
-011
4.22A.
-015
9.75 A.
561
754.38
786.82
1972.03
1972.18
-008
0.23A.
246.1
-009
45.55A.
722
509.3
2645.23
2752
-010
0.30A.
1870.27
2645.27
775
-016
6.25 A.
351.50
775
SEE SURVEY
KLEINOEDER · SCHMIDT & ASSOC.
c.c. 1:INF
-017
6.25 A.
351.50
775
351.50
-011
85.51A.
-018
73.01 A.
-006
3.19A
1387.9
1433.08
725.08
RUSSIA
(60)
679.51
270
270.13
270.13
240
200
-030
1.08A
-033
1.03 A.
-010
11.65A.
-012
5.00A
-014
5.00A
-016
-024
2.74A.
-026
2.32A.
-032
0.99 A.
-020
3.20A.
629.08
270
270.13
270.13
555
S. 88°40'W.
J. SMITH ALLT
1-001
2-002
3-003
4-004
5-005
6-006
90°53'30"
#16664
APPROVED
LORAIN CO.
MAP DEPT.
DATE 4·1·86
PAGE 9-A
BY T. McMain
VOID AFTER
4-29-86
7-17-86