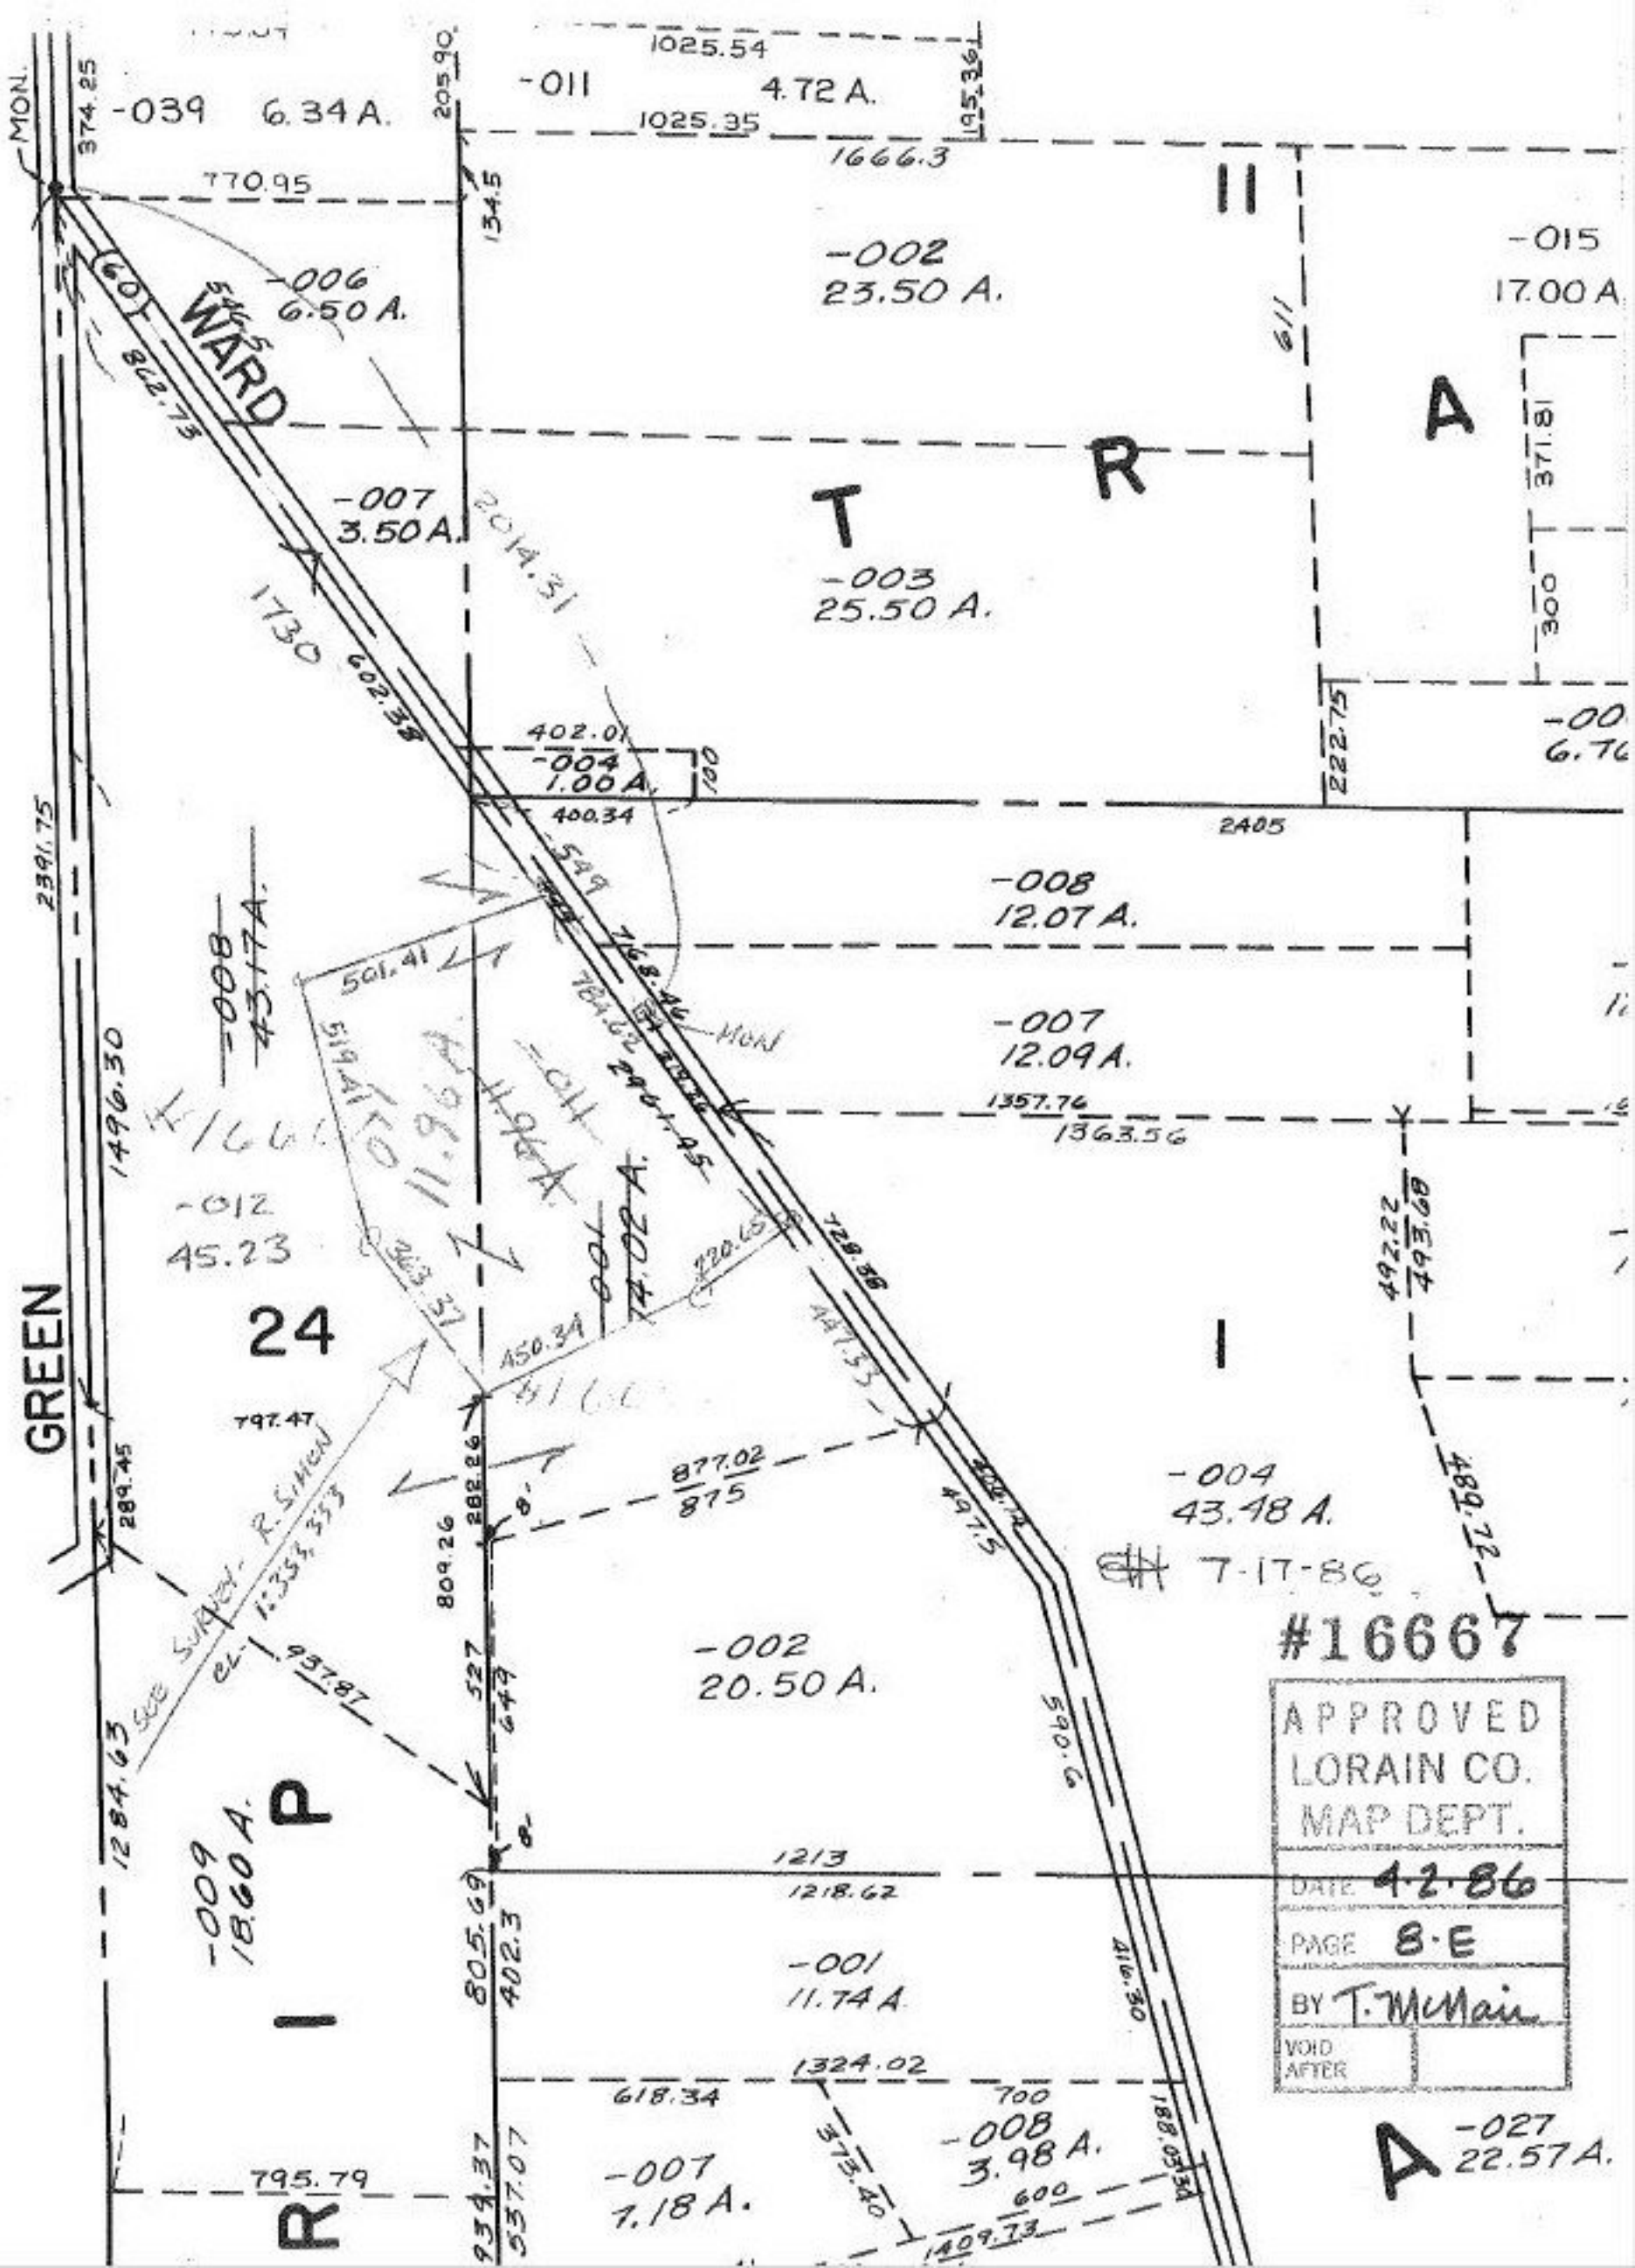

MON.
-039 6.34 A.
-011 4.72 A.
1025.54
1025.35
1666.3
770.95
-006 6.50 A.
WARD
-002 23.50 A.
-015 17.00 A.
-007 3.50 A.
-003 25.50 A.
T R A
-004 1.00 A.
402.01
400.34
2405
-008 12.07 A.
-007 12.09 A.
1357.76
1363.56
-008 43.17 A.
-012 45.23
24
GREEN
-001 74.02 A.
-004 43.48 A.
7-17-86
-002 20.50 A.
-009 18.60 A.
P
-001 11.74 A.
1213
1218.62
1324.02
618.34
-008 3.98 A.
-007 7.18 A.
795.79
-027 22.57 A.
A
#16667
APPROVED
LORAIN CO.
MAP DEPT.
DATE 4-2-86
PAGE 8-E
BY T. McMain
VOID AFTER