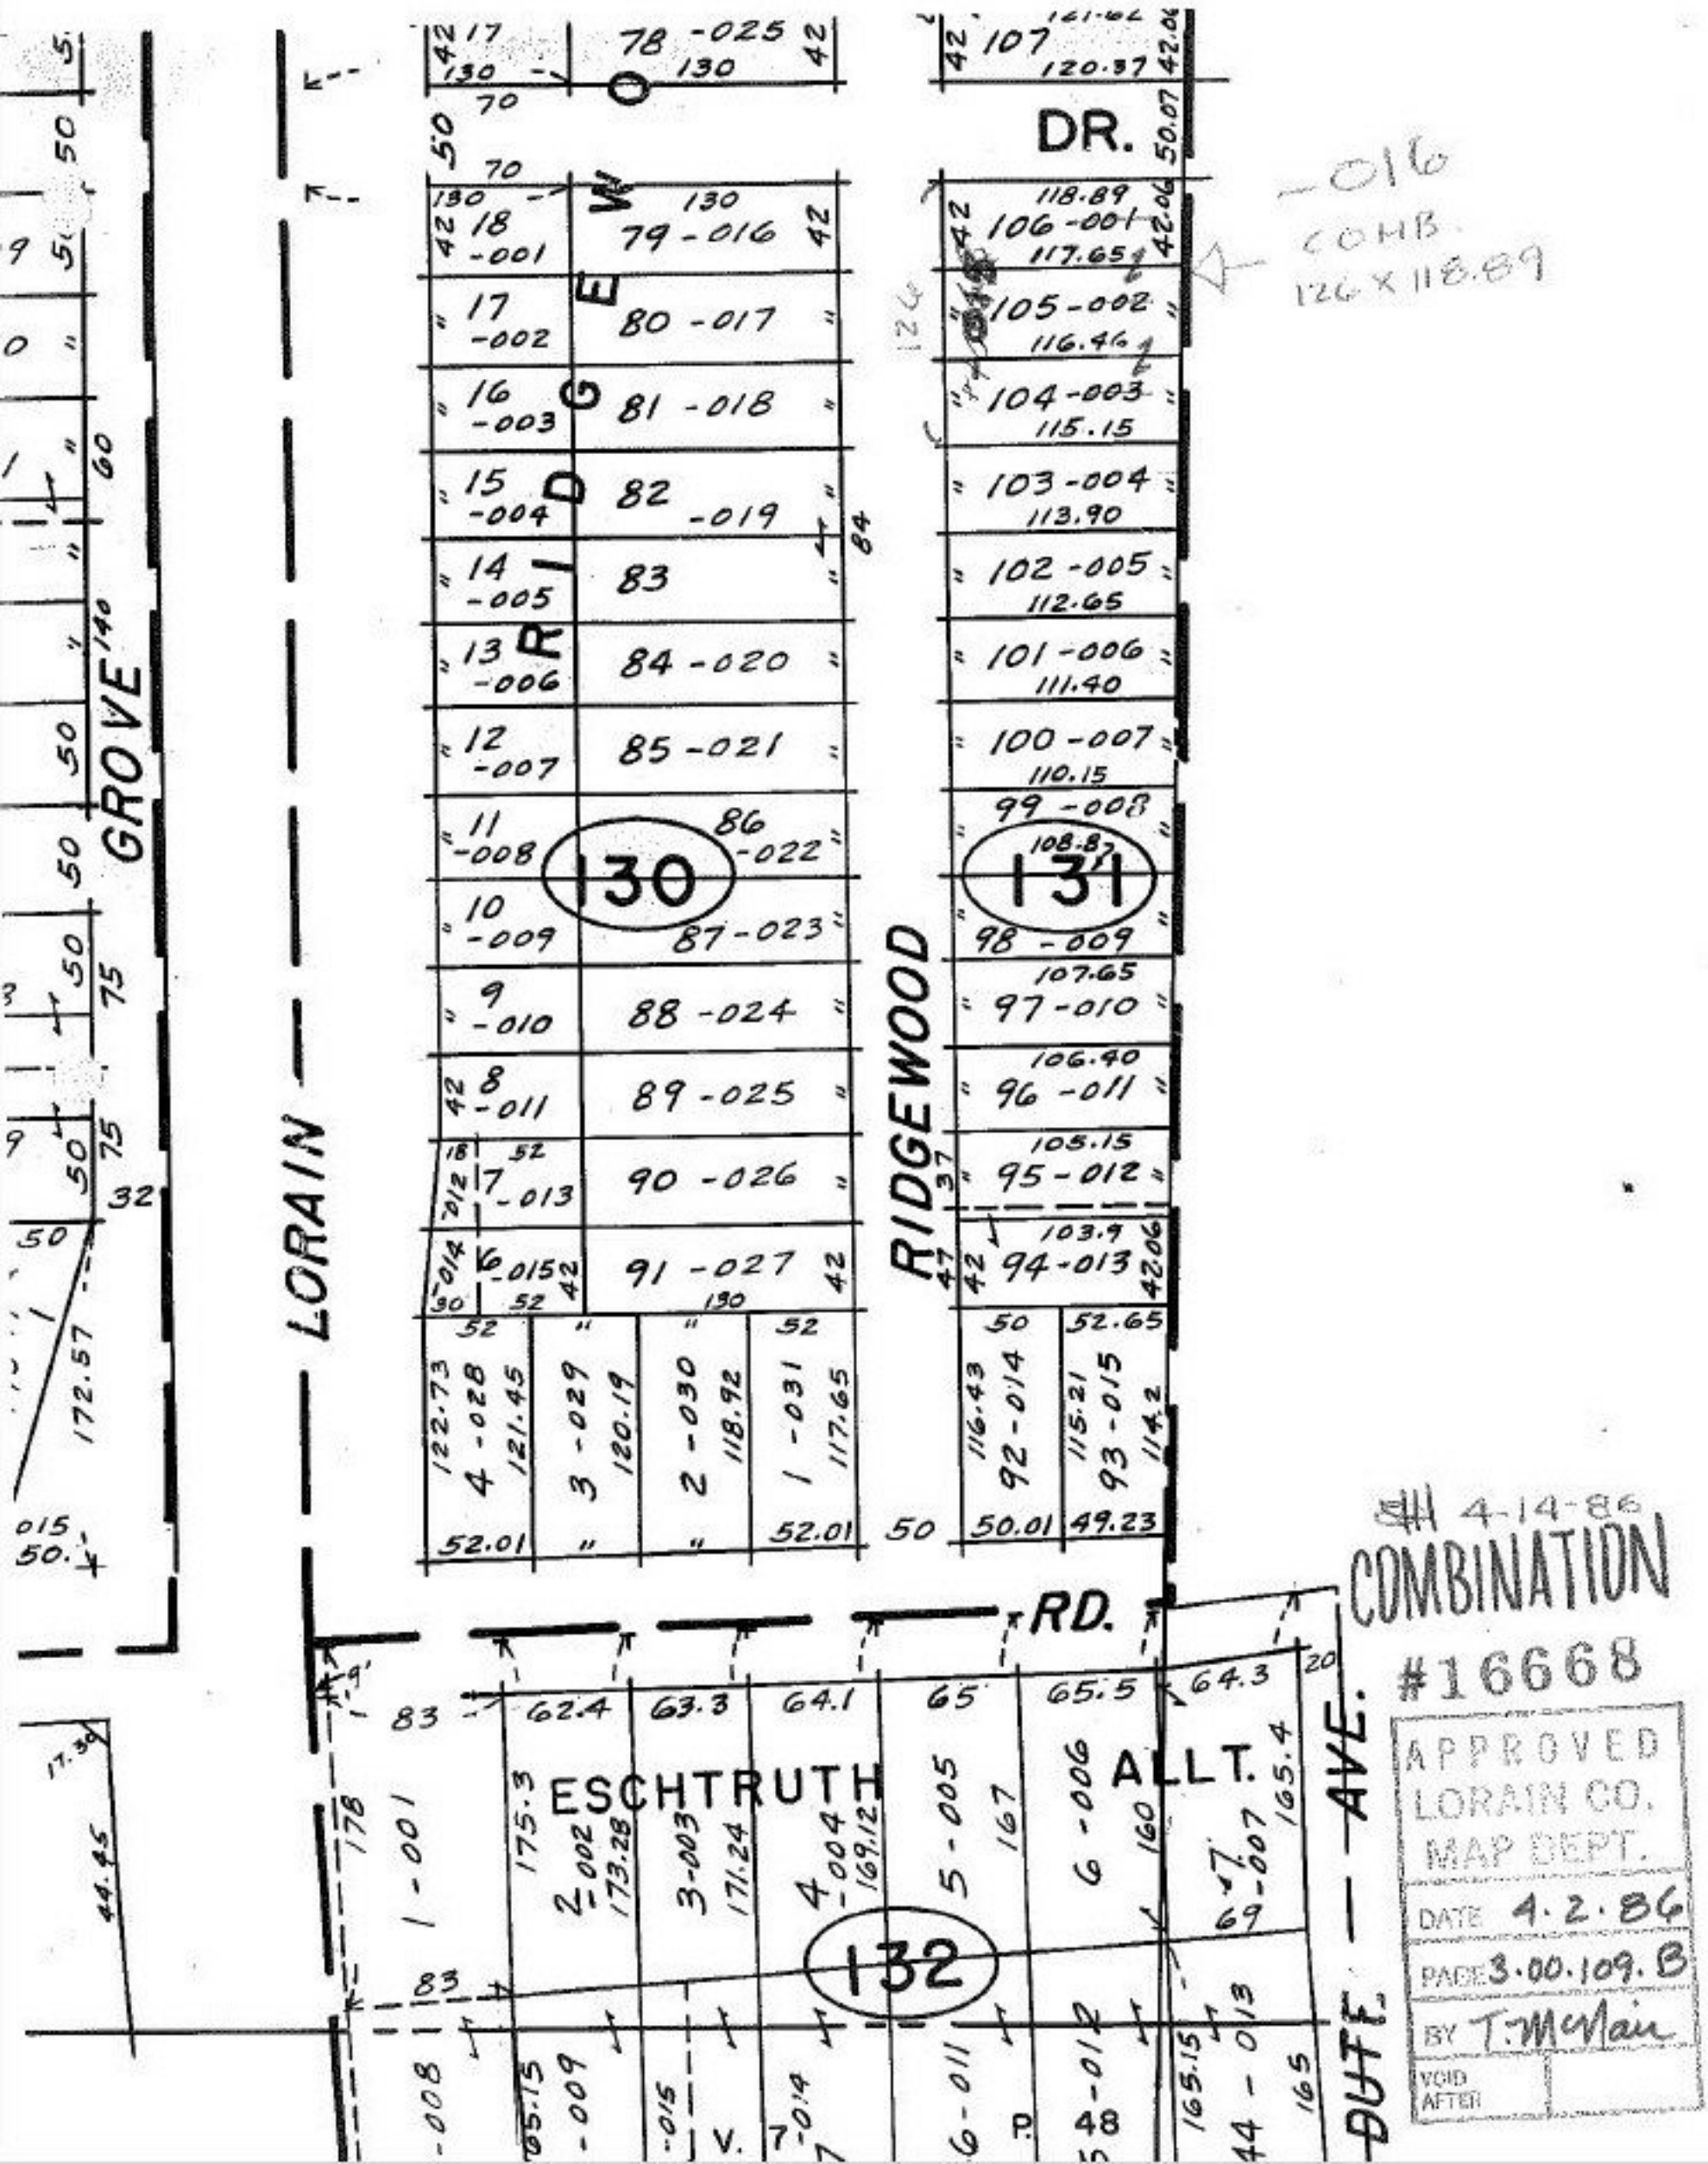
LORAIN
GROVE
RIDGEVIEW
RIDGEWOOD
DR.
RD.
AVE.
ESCHTRUTH ALLT.
130
131
132
-016
COMB.
126 X 118.89
4-14-86
COMBINATION
#16668
APPROVED
LORAIN CO.
MAP DEPT.
DATE 4.2.86
PAGE 3.00.109.B
BY T. McNair
VOID AFTER