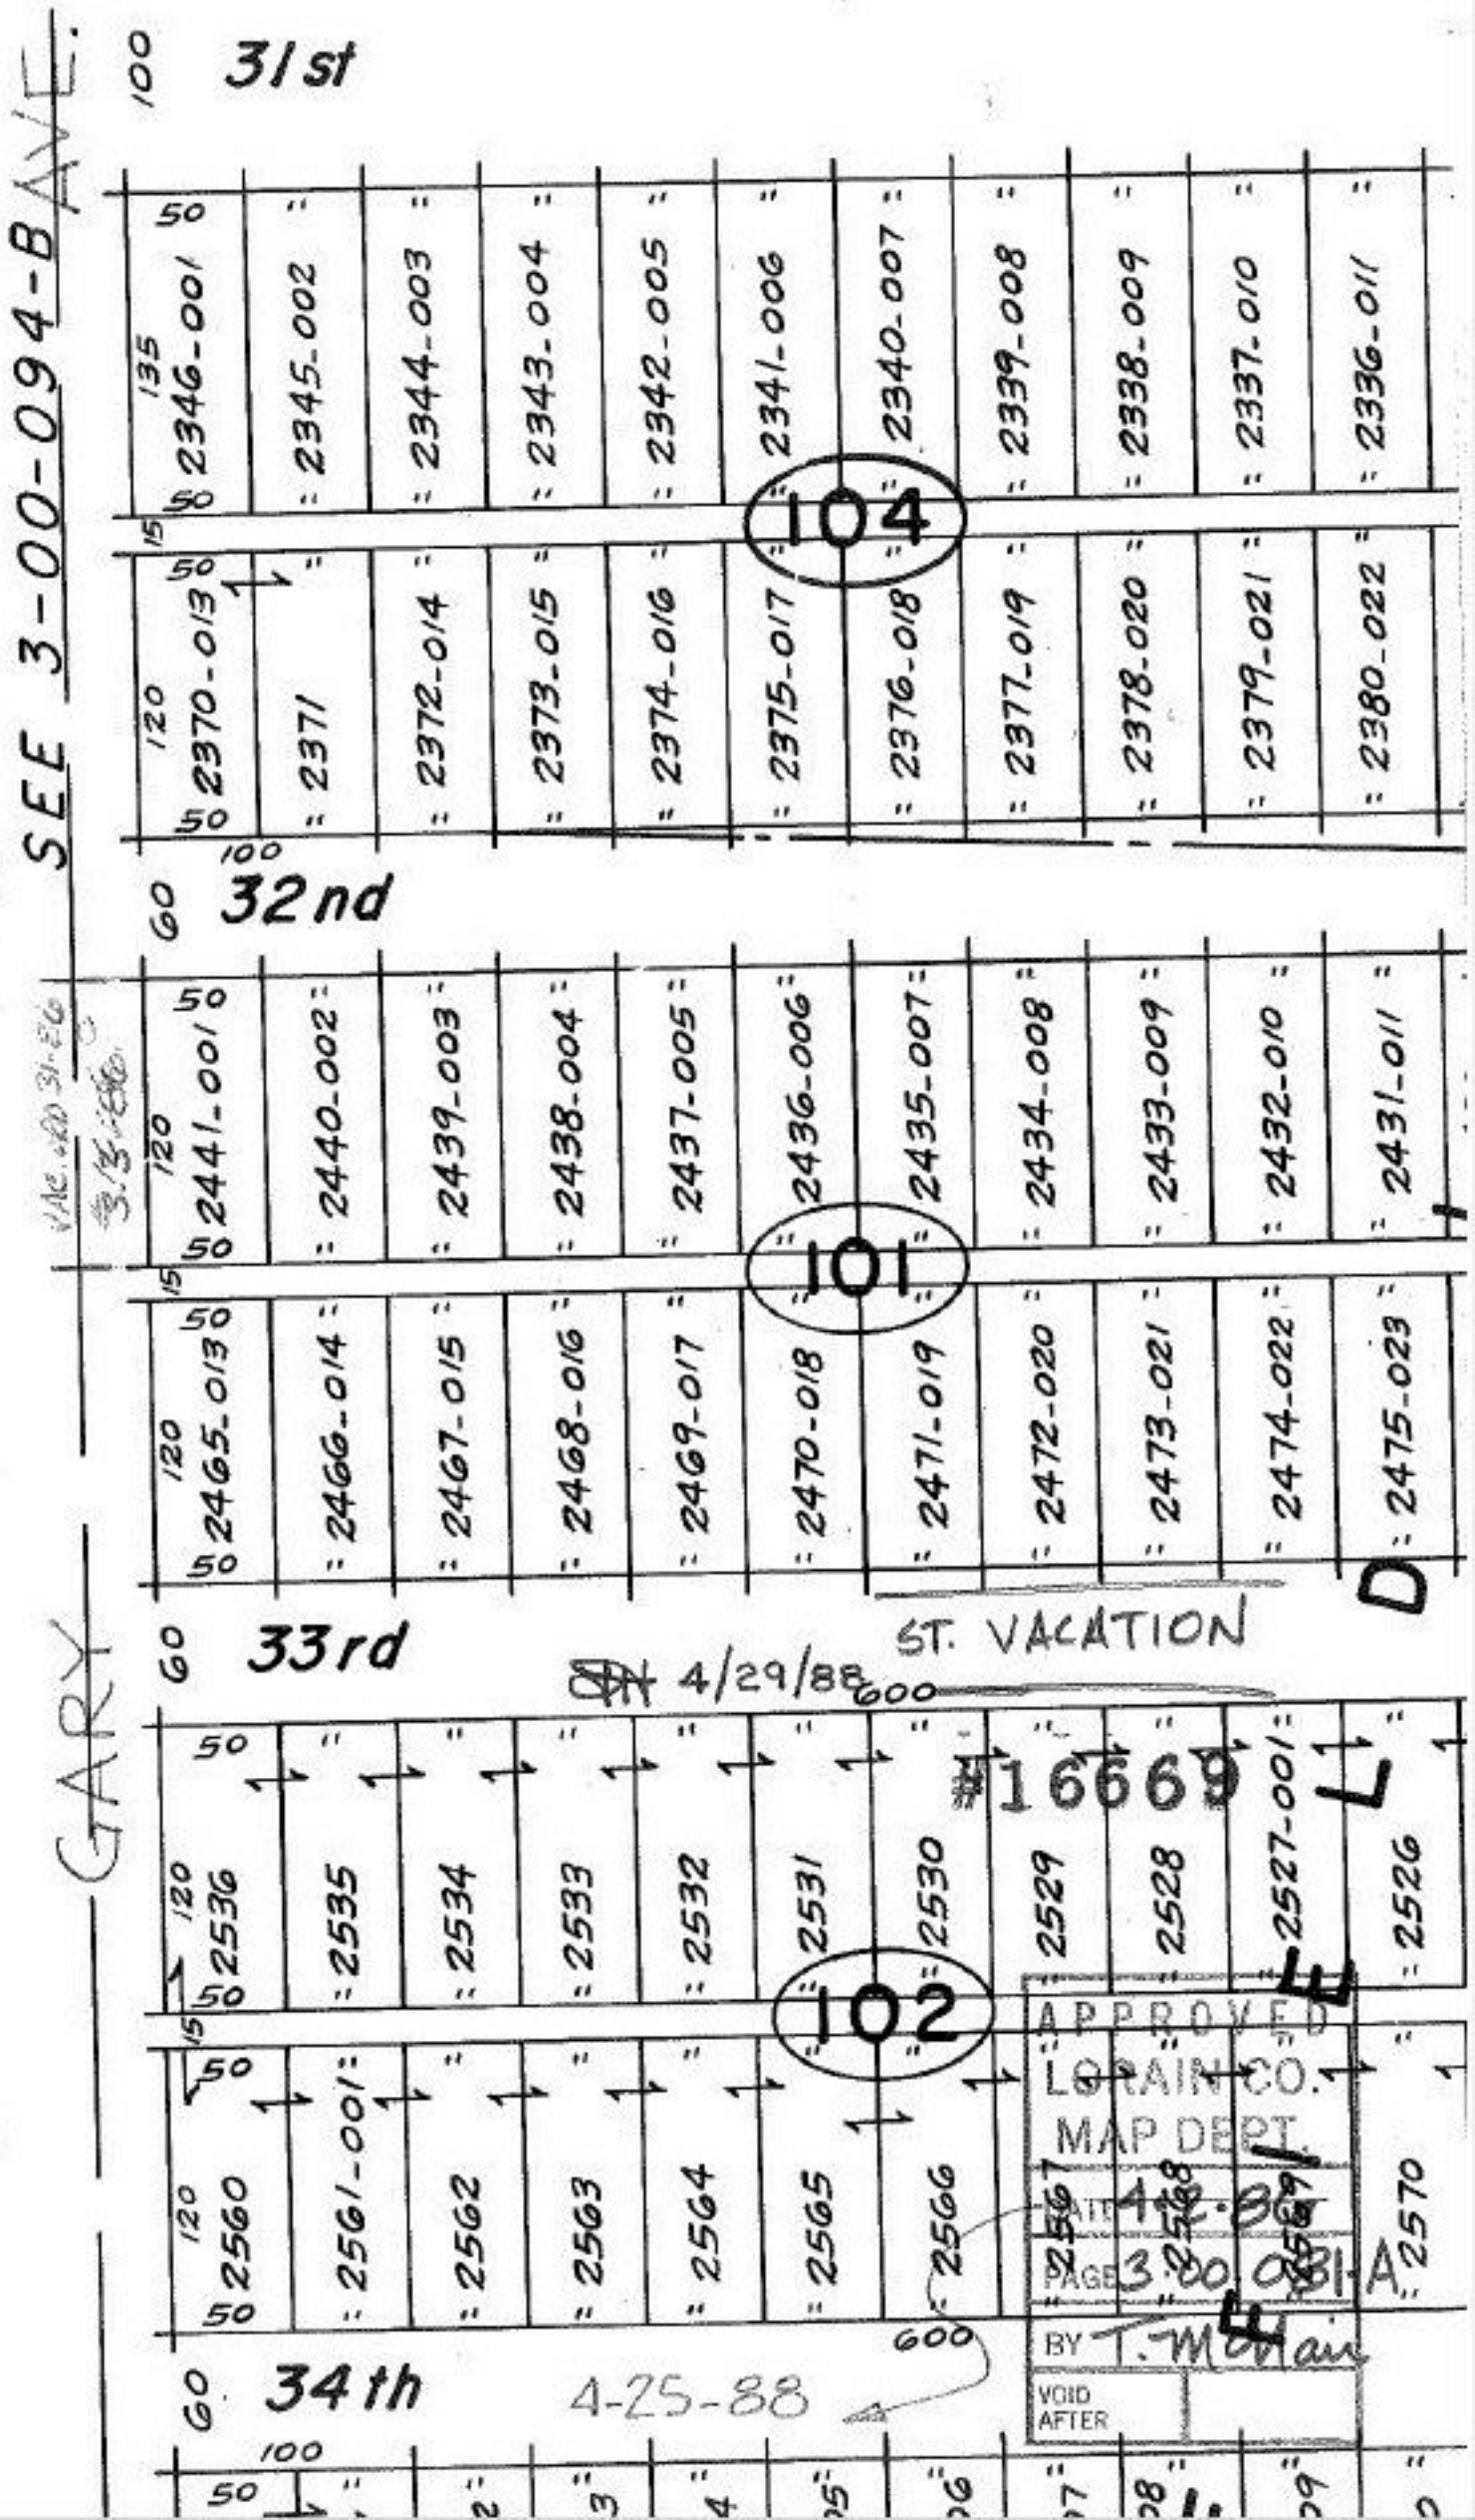

SEE 3-00-094-B AVE.
31st
32nd
33rd
34th
GARY
104
101
102
ST. VACATION
4/29/88
#16669
4-25-88
VAC. ORD. 31-86
3-3-86
APPROVED
LORAIN CO.
MAP DEPT.
DATE 4-2-86
PAGE 3-00-081-A
BY T. McMain
VOID AFTER