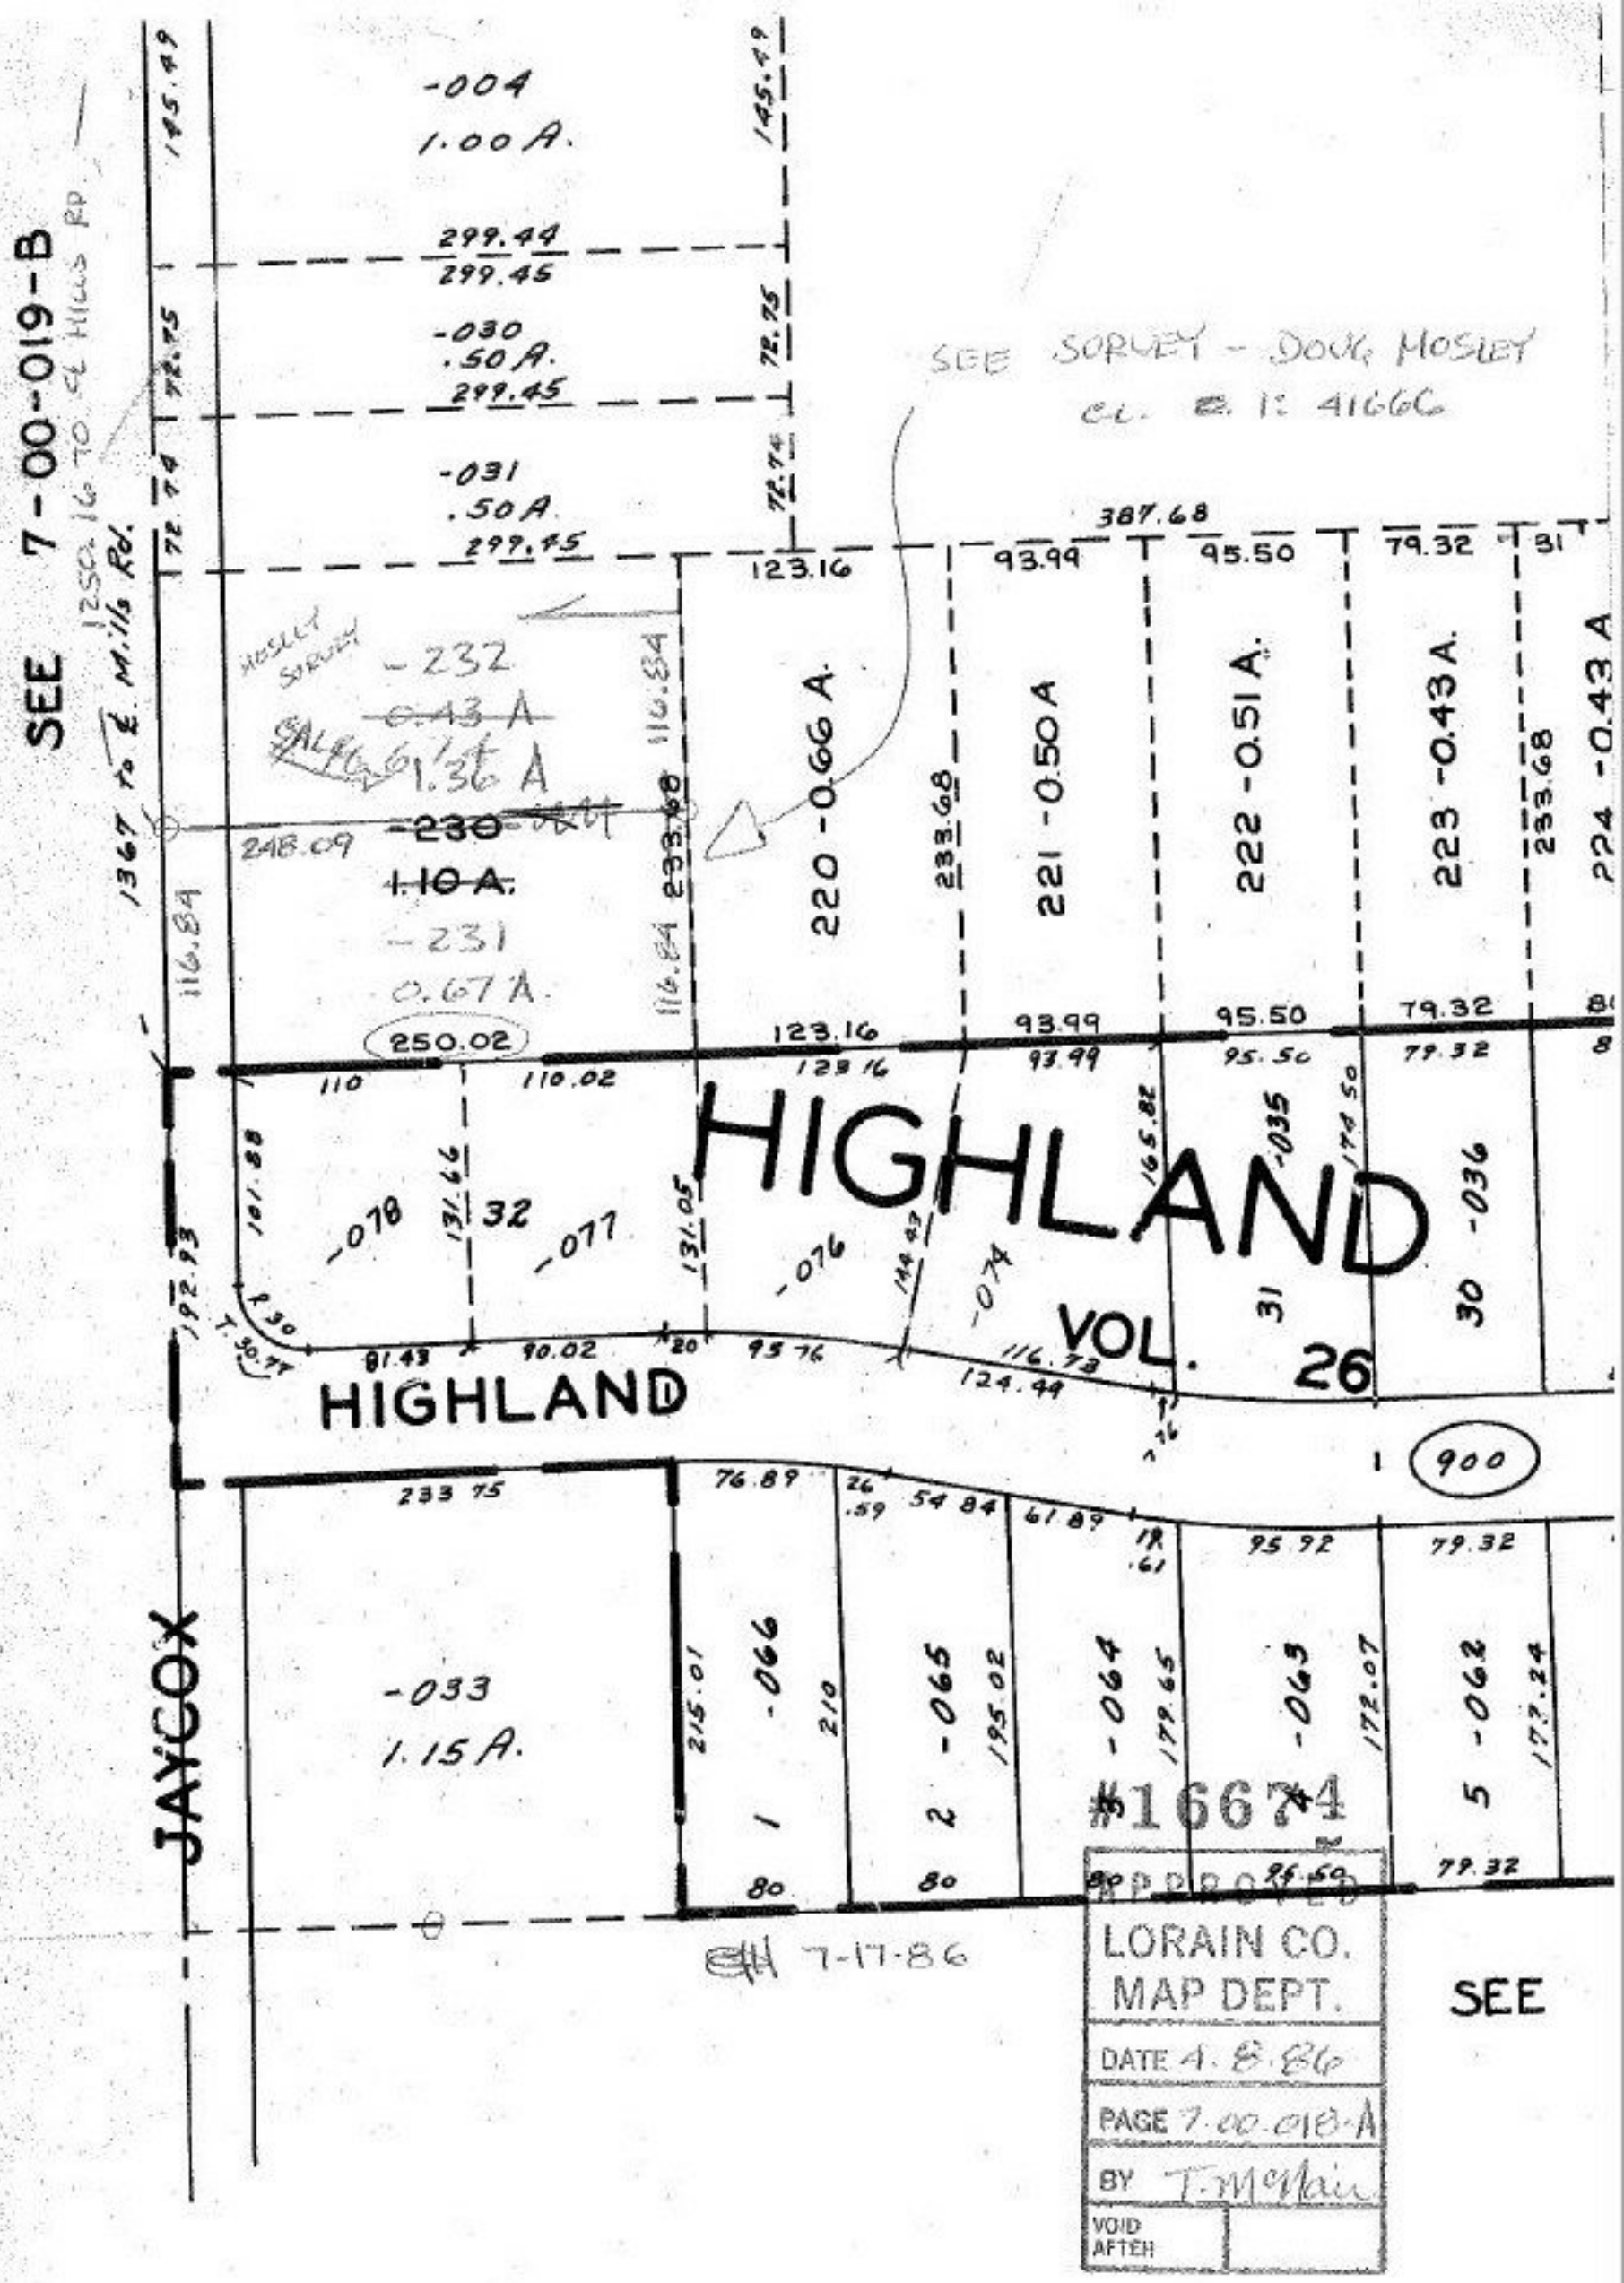

SEE 7-00-019-B
1250.16 TO ℄ HILLS RD
1367 TO ℄ Mills Rd.
-004
1.00 A.
299.44
299.45
-030
.50 A.
299.45
-031
.50 A.
299.45
SEE SURVEY - DOUG MOSLEY
CL. 2. 1: 41666
387.68
123.16
93.99
95.50
79.32
MOSLEY SURVEY
-232
~~0.43 A~~
1.36 A
-230
~~1.10 A.~~
-231
0.67 A.
248.09
116.84
233.68
220 -0.66 A.
221 -0.50 A
222 -0.51 A.
223 -0.43 A.
224 -0.43 A
250.02
110
110.02
HIGHLAND
VOL. 26
-078
32
-077
-076
-074
-035
31
-036
30
81.43
90.02
95.76
116.73
124.44
900
233.75
76.89
54.84
61.89
95.92
79.32
JAYCOX
-033
1.15 A.
-066
1
-065
2
-064
3
-063
4
-062
5
215.01
210
195.02
179.65
172.07
177.24
80
7-17-86
SEE
#16674
APPROVED
LORAIN CO.
MAP DEPT.
DATE 4.8.86
PAGE 7.00.018-A
BY T. McNair
VOID AFTER