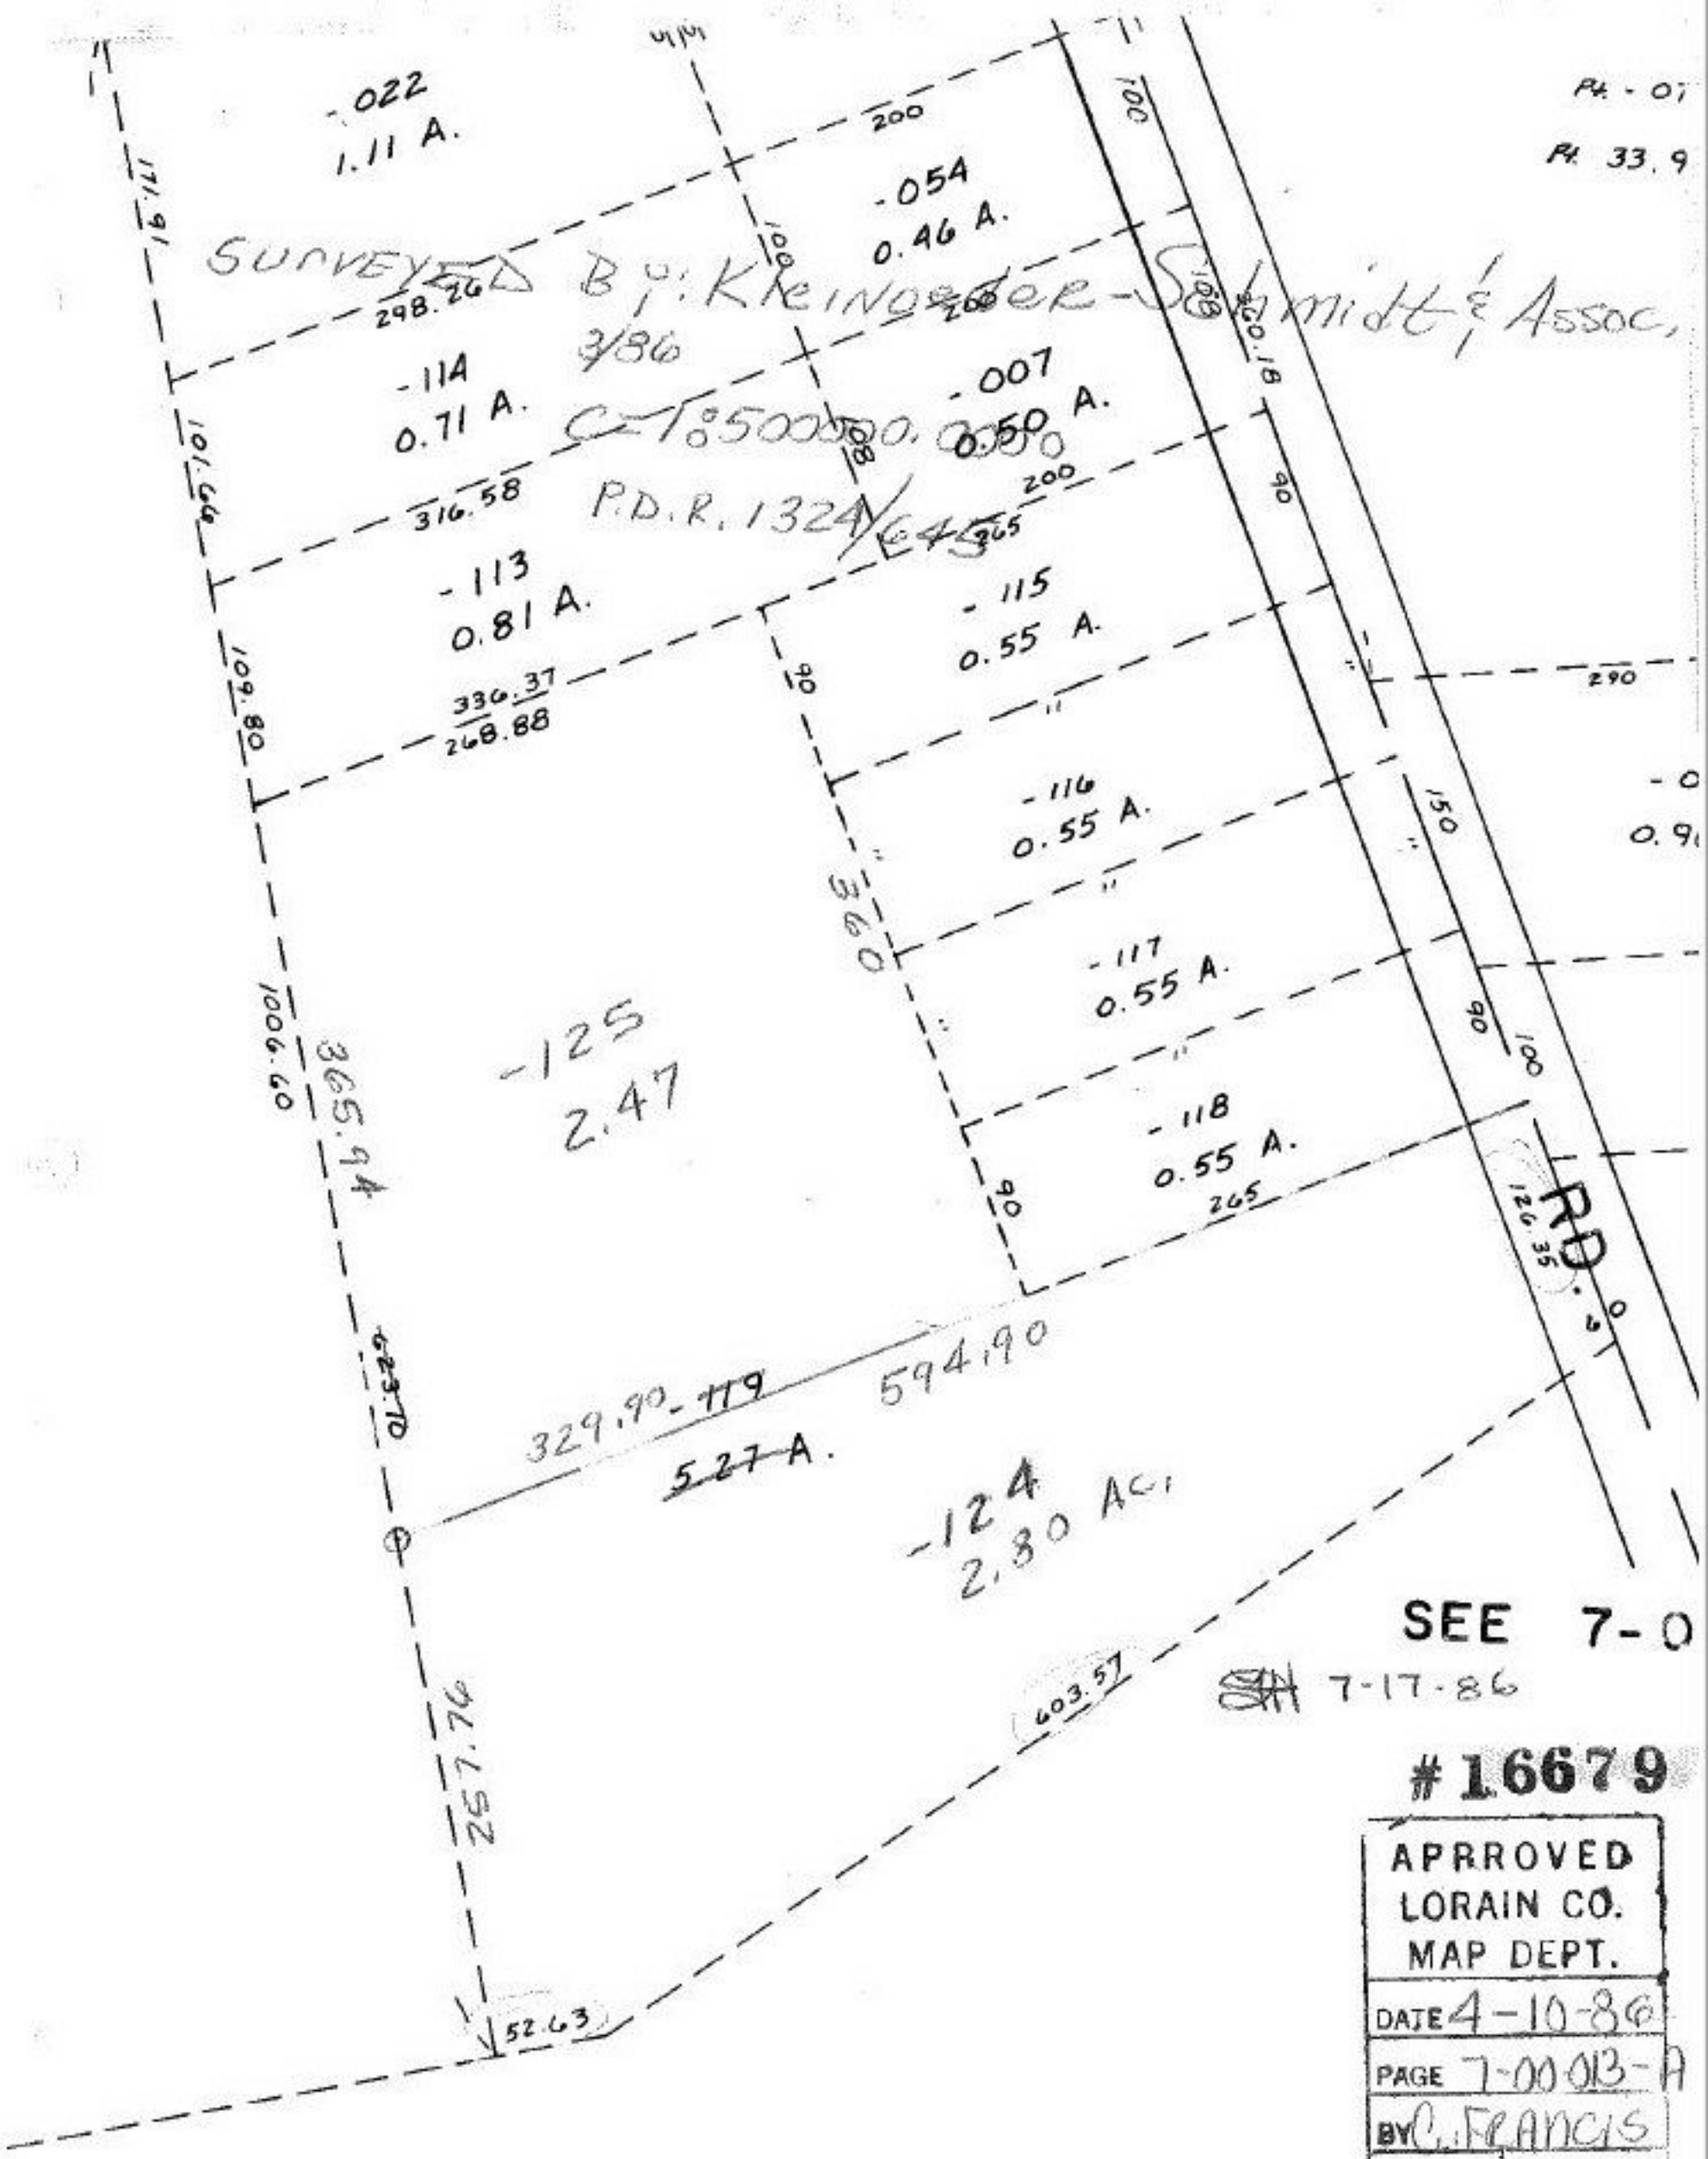

-022
1.11 A.
-054
0.46 A.
SURVEYED BY: Kleinoeder-Schmidt & Assoc.
3/86
C=1:500000.0000
P.D.R. 1324/645
-114
0.71 A.
-007
0.50 A.
-113
0.81 A.
-115
0.55 A.
-116
0.55 A.
-117
0.55 A.
-118
0.55 A.
-125
2.47
-124
2.80 Ac.
-119
5.27 A.
329.90
594.90
365.94
257.76
603.57
52.63
171.91
101.66
109.80
1006.60
298.26
316.58
336.37
268.88
200
265
290
150
90
100
RD.
126.35
SEE 7-0
7-17-86
#16679
APRROVED
LORAIN CO.
MAP DEPT.
DATE 4-10-86
PAGE 7-00013-A
BY C. FRANCIS
VOID
AFTER