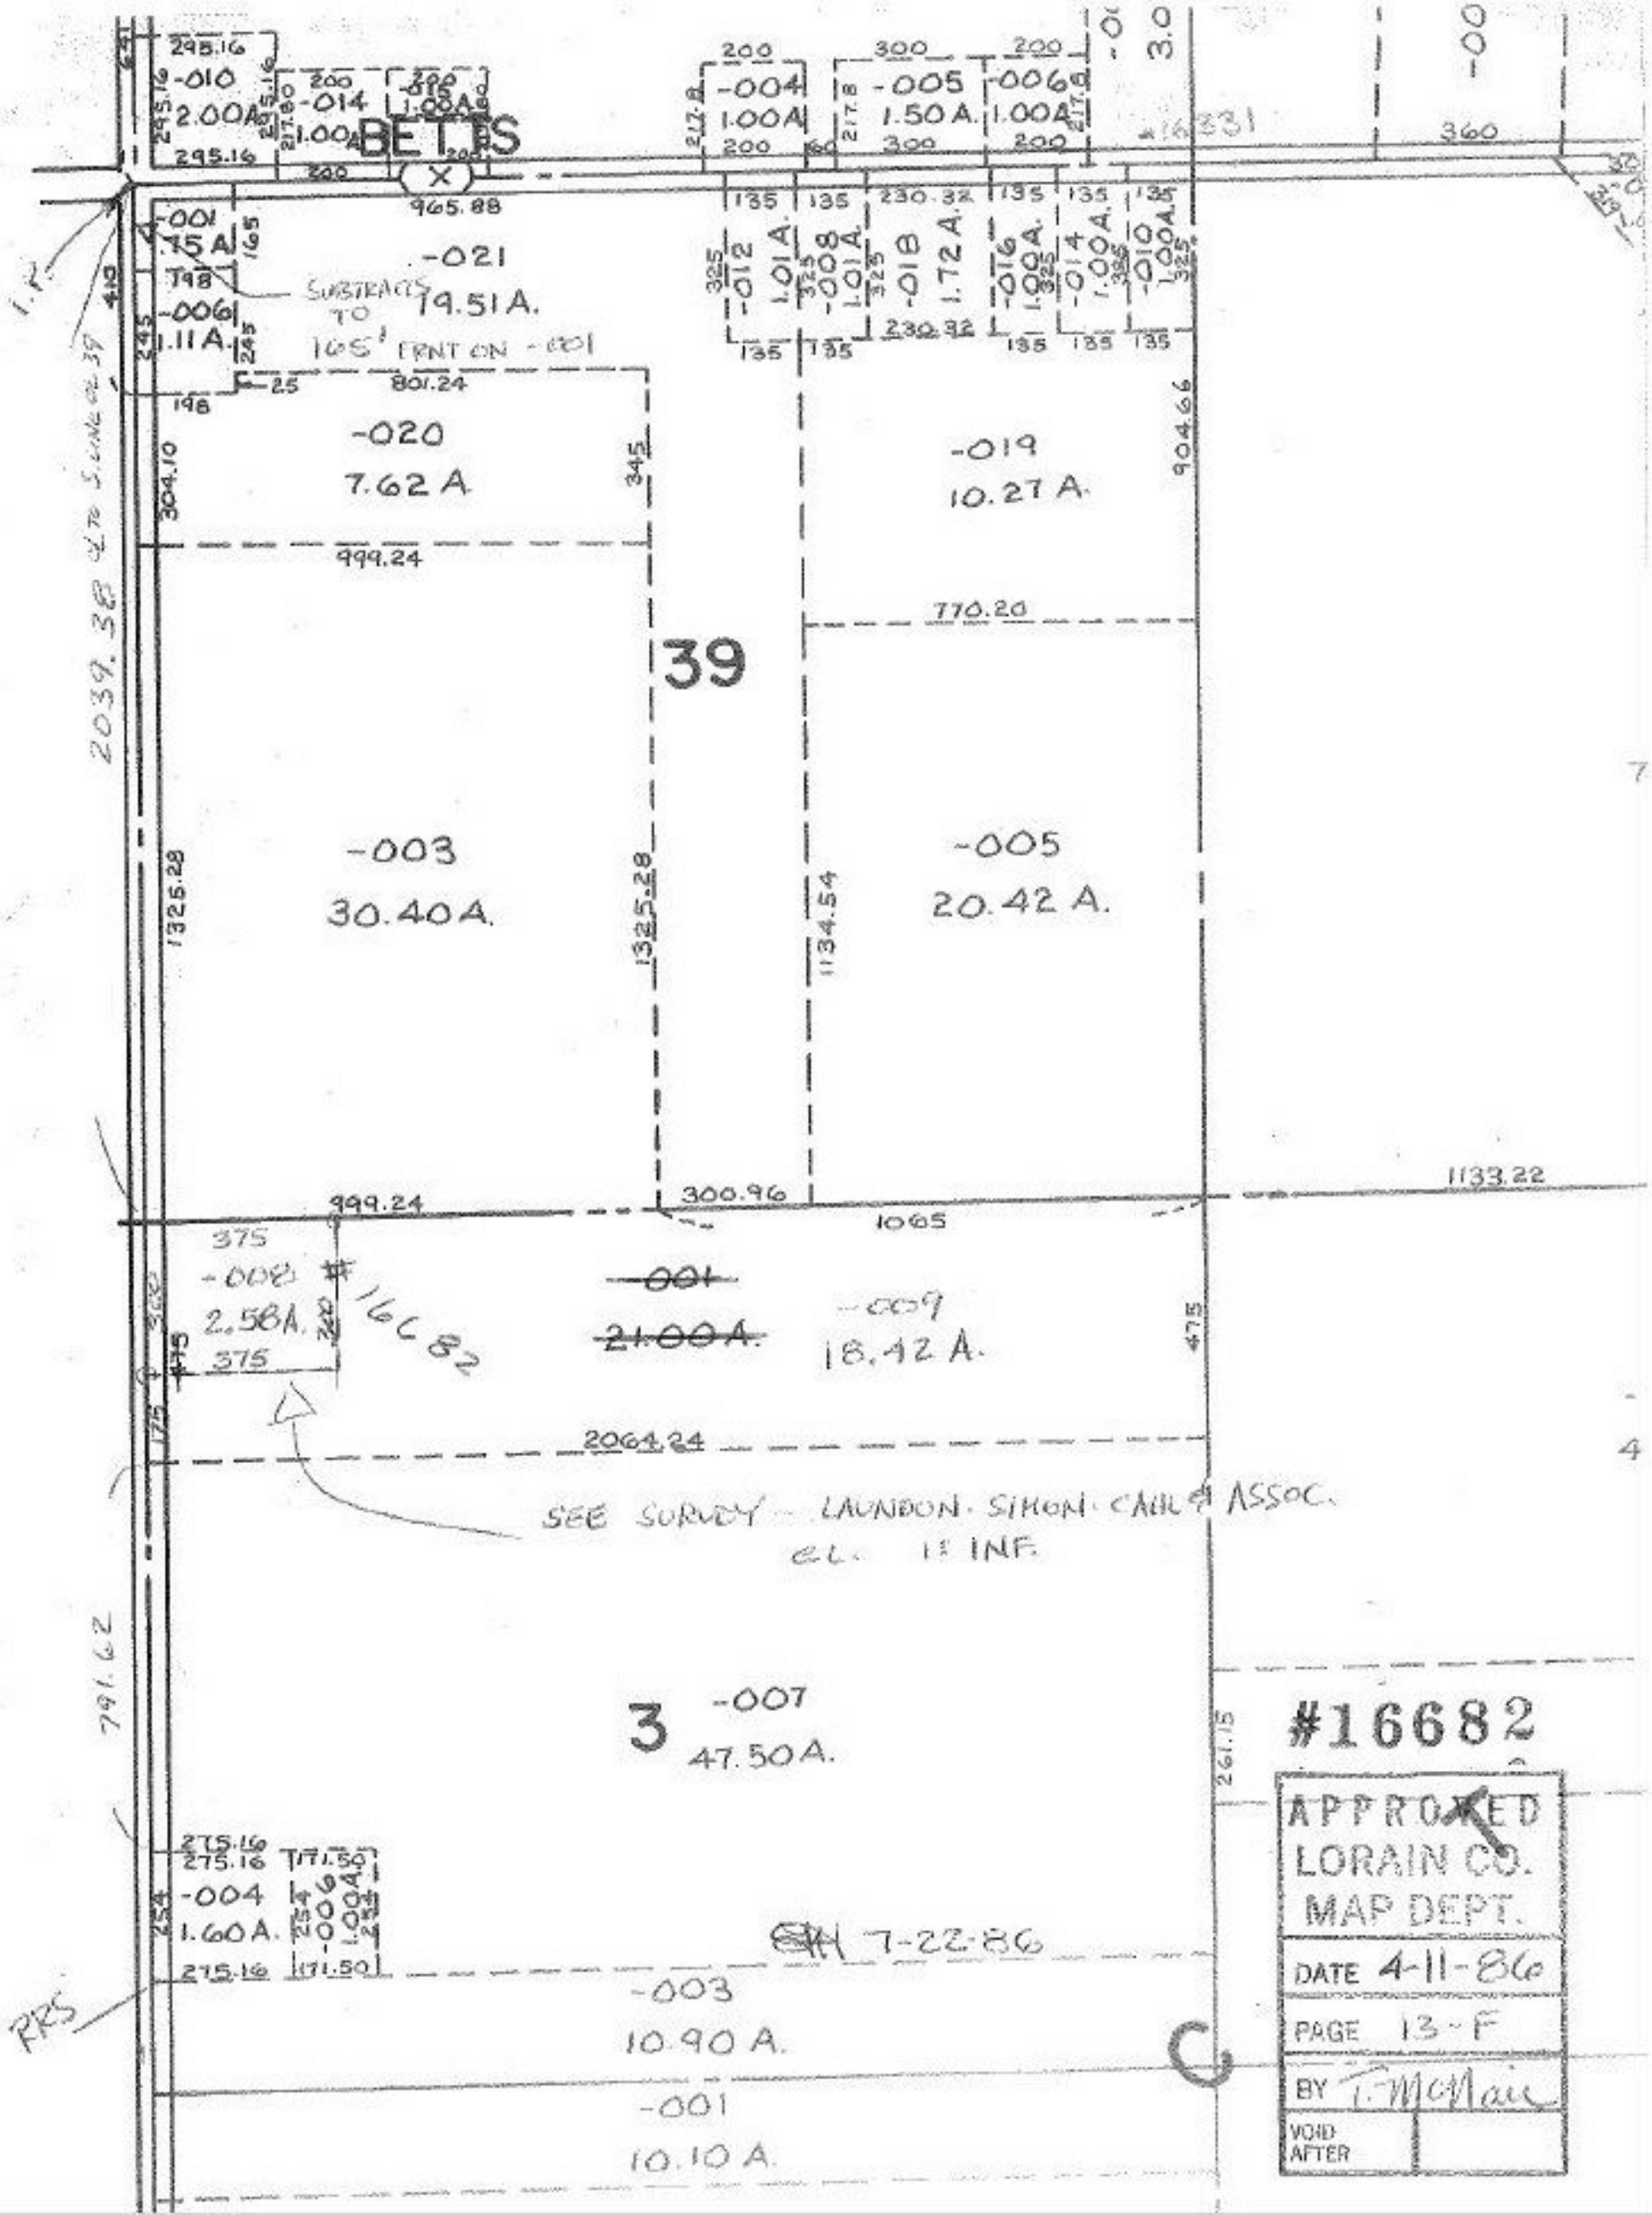
BETTS
-010
2.00A
-014
1.00A
-015
1.00A
-004
1.00A
-005
1.50A.
-006
1.00A
-001
.75A
-006
1.11A.
-021
19.51A.
SUBTRACTS TO 165' FRNT ON -001
-012
1.01A.
-008
1.01A.
-018
1.72A.
-016
1.00A.
-014
1.00A.
-010
1.00A.
-020
7.62A
-019
10.27A.
39
-003
30.40A.
-005
20.42A.
-008
2.58A.
#16682
-001
21.00A.
-009
18.42A.
SEE SURVEY - LAUNDON. SIMON. CAHL & ASSOC.
EL. 1' INF.
3
-007
47.50A.
-004
1.60A.
-006
1.00A
-003
10.90A.
-001
10.10A.
7-22-86
2039.38 ℄ TO S. LINE OF 39
791.62
RRS
#16682
APPROVED
LORAIN CO.
MAP DEPT.
DATE 4-11-86
PAGE 13-F
BY T. McNair
VOID AFTER