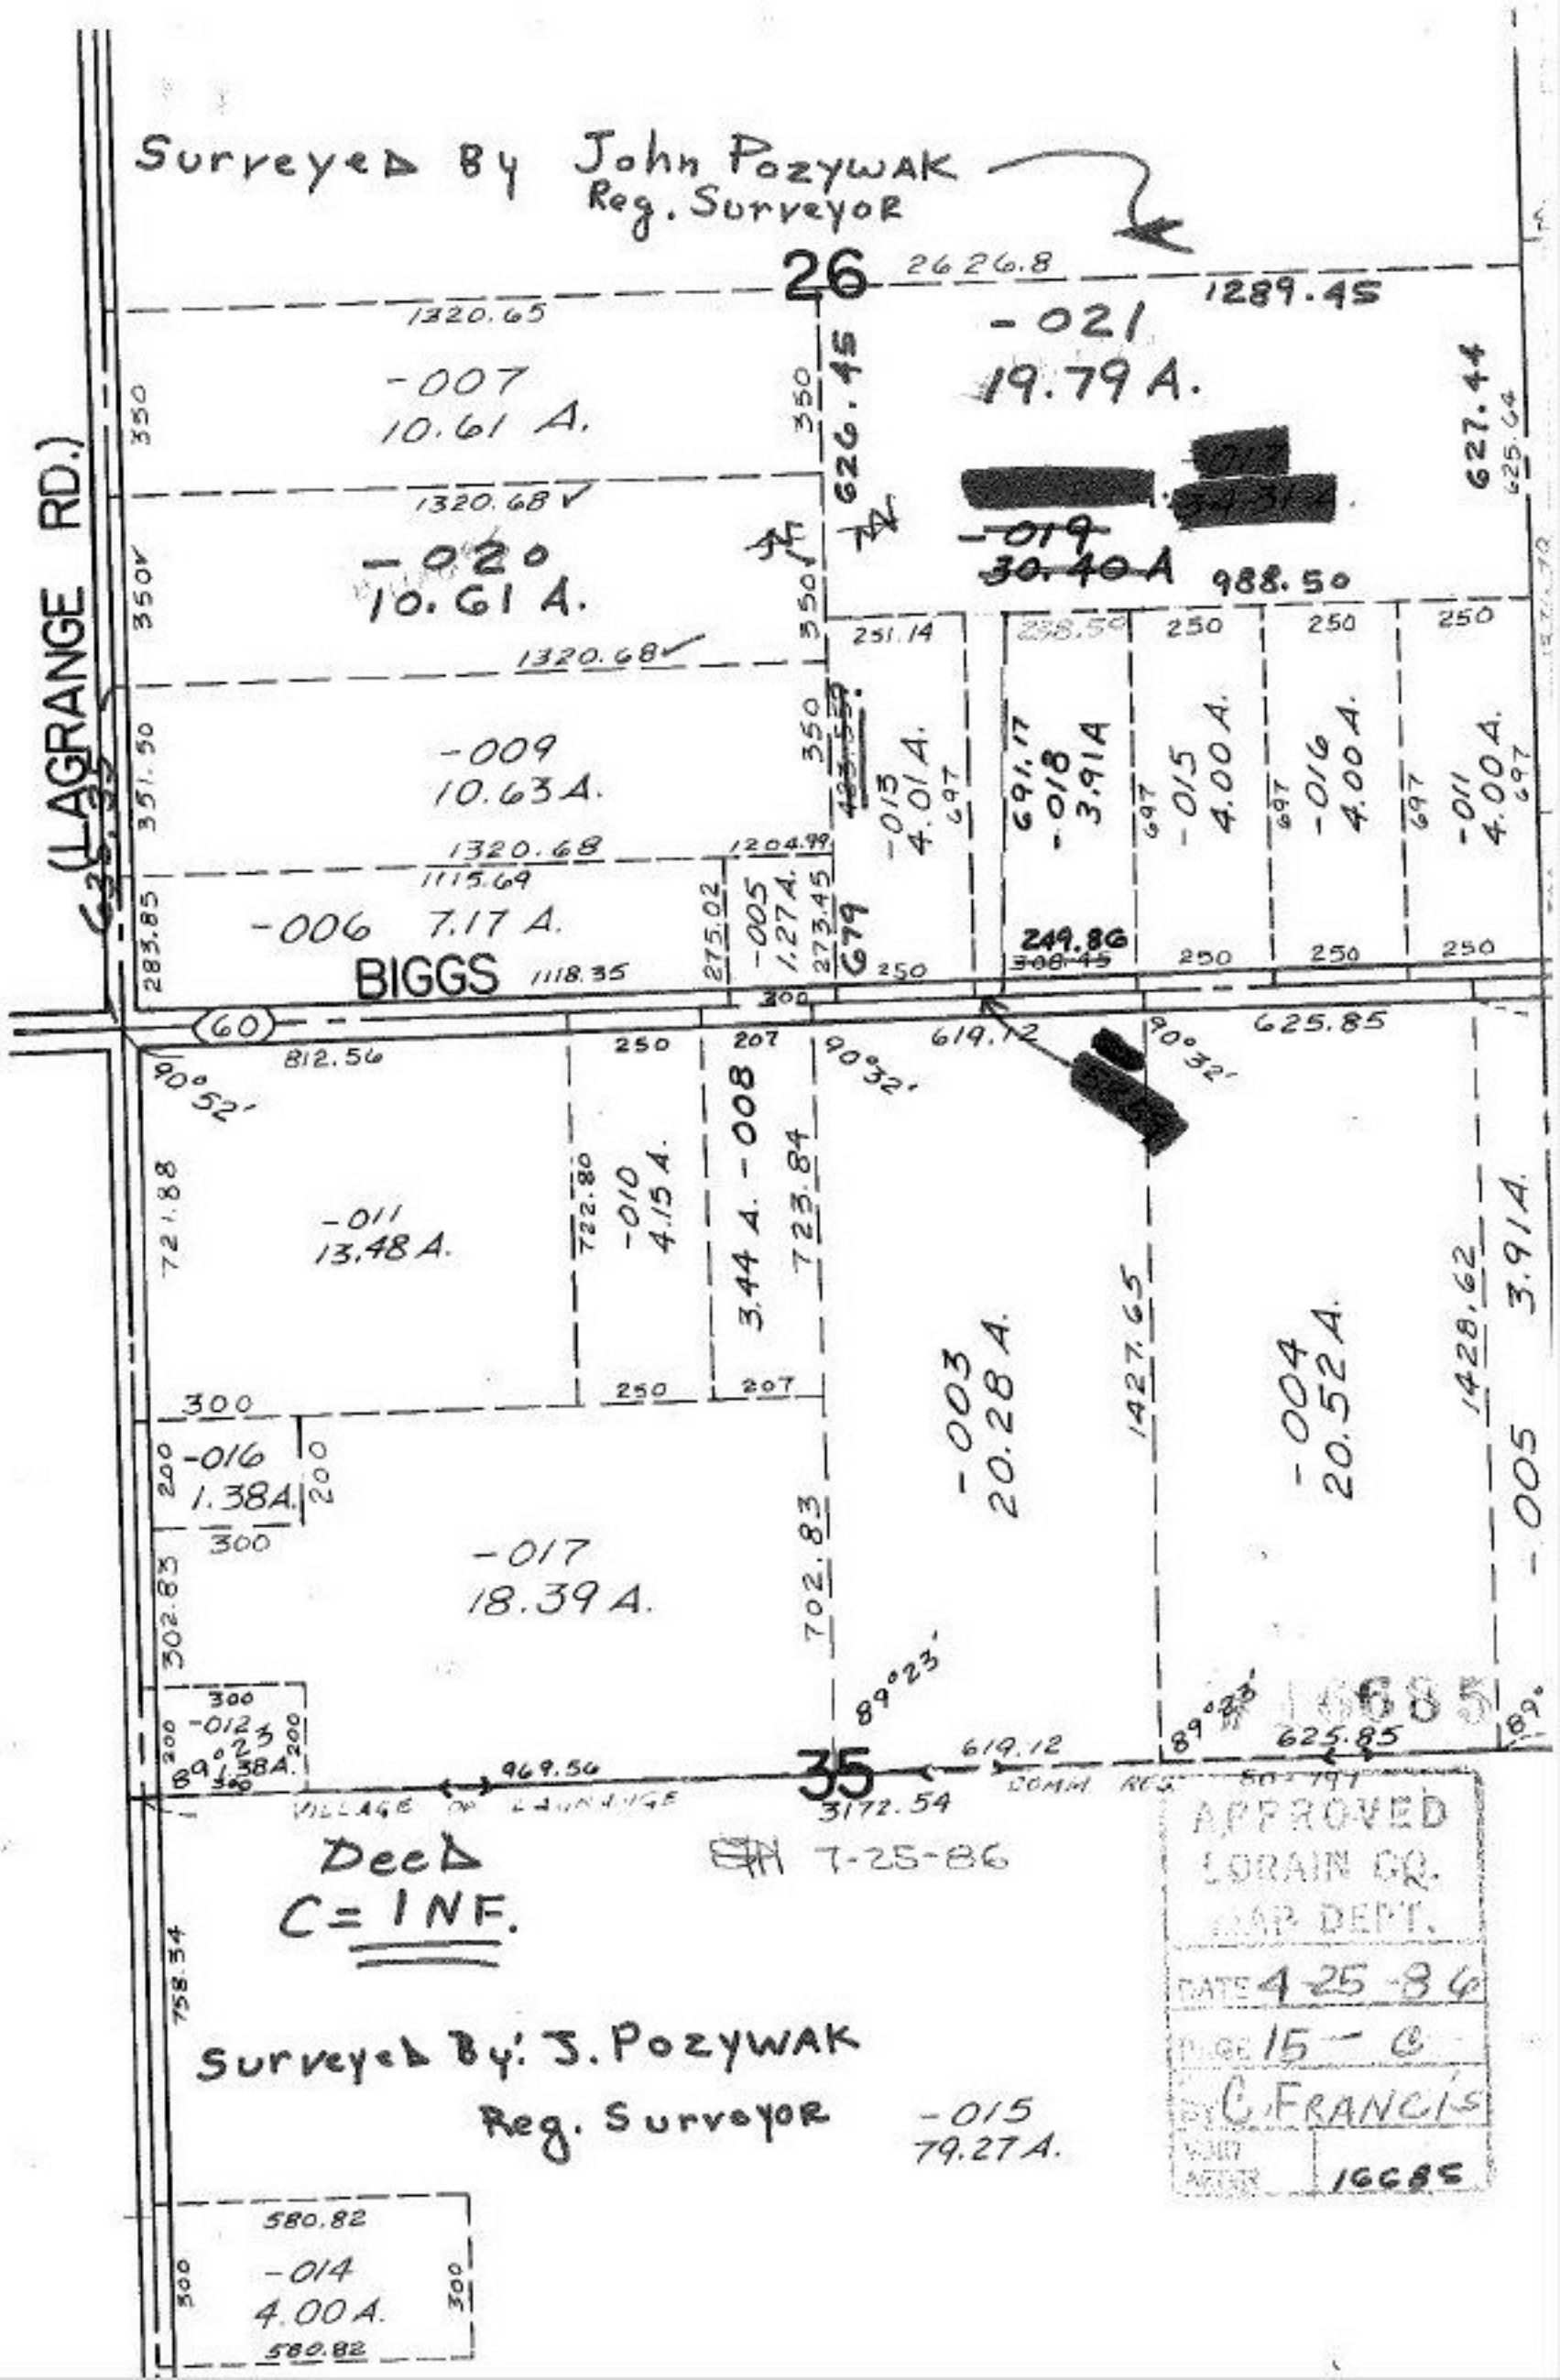

Surveyed By John Pozywak
Reg. Surveyor
26
2626.8
1289.45
1320.65
-007
10.61 A.
-021
19.79 A.
626.45
627.44
625.64
1320.68
-020
10.61 A.
-019
30.40 A
988.50
1320.68
-009
10.63 A.
251.14
-013
4.01 A.
691.17
-018
3.91 A
-015
4.00 A.
-016
4.00 A.
-011
4.00 A.
1320.68
1204.99
1115.69
-006 7.17 A.
-005
1.27 A.
273.45
679
249.86
BIGGS
1118.35
(LAGRANGE RD.)
(60)
812.56
619.12
625.85
90°52'
90°32'
-011
13.48 A.
722.80
-010
4.15 A.
3.44 A. -008
723.84
-003
20.28 A.
1427.65
-004
20.52 A.
1428.62
3.91 A.
-005
-016
1.38 A.
-017
18.39 A.
702.83
302.83
-012
1.38 A.
89°23'
969.56
35
619.12
625.85
3172.54
VILLAGE OF LAGRANGE
COMM. RES.
Deed
C= INF.
7-25-86
Surveyed By: J. Pozywak
Reg. Surveyor
-015
79.27 A.
580.82
-014
4.00 A.
580.82
758.34
APPROVED
LORAIN CO.
MAP DEPT.
DATE 4-25-86
PAGE 15 - C
BY C. FRANCIS
16685