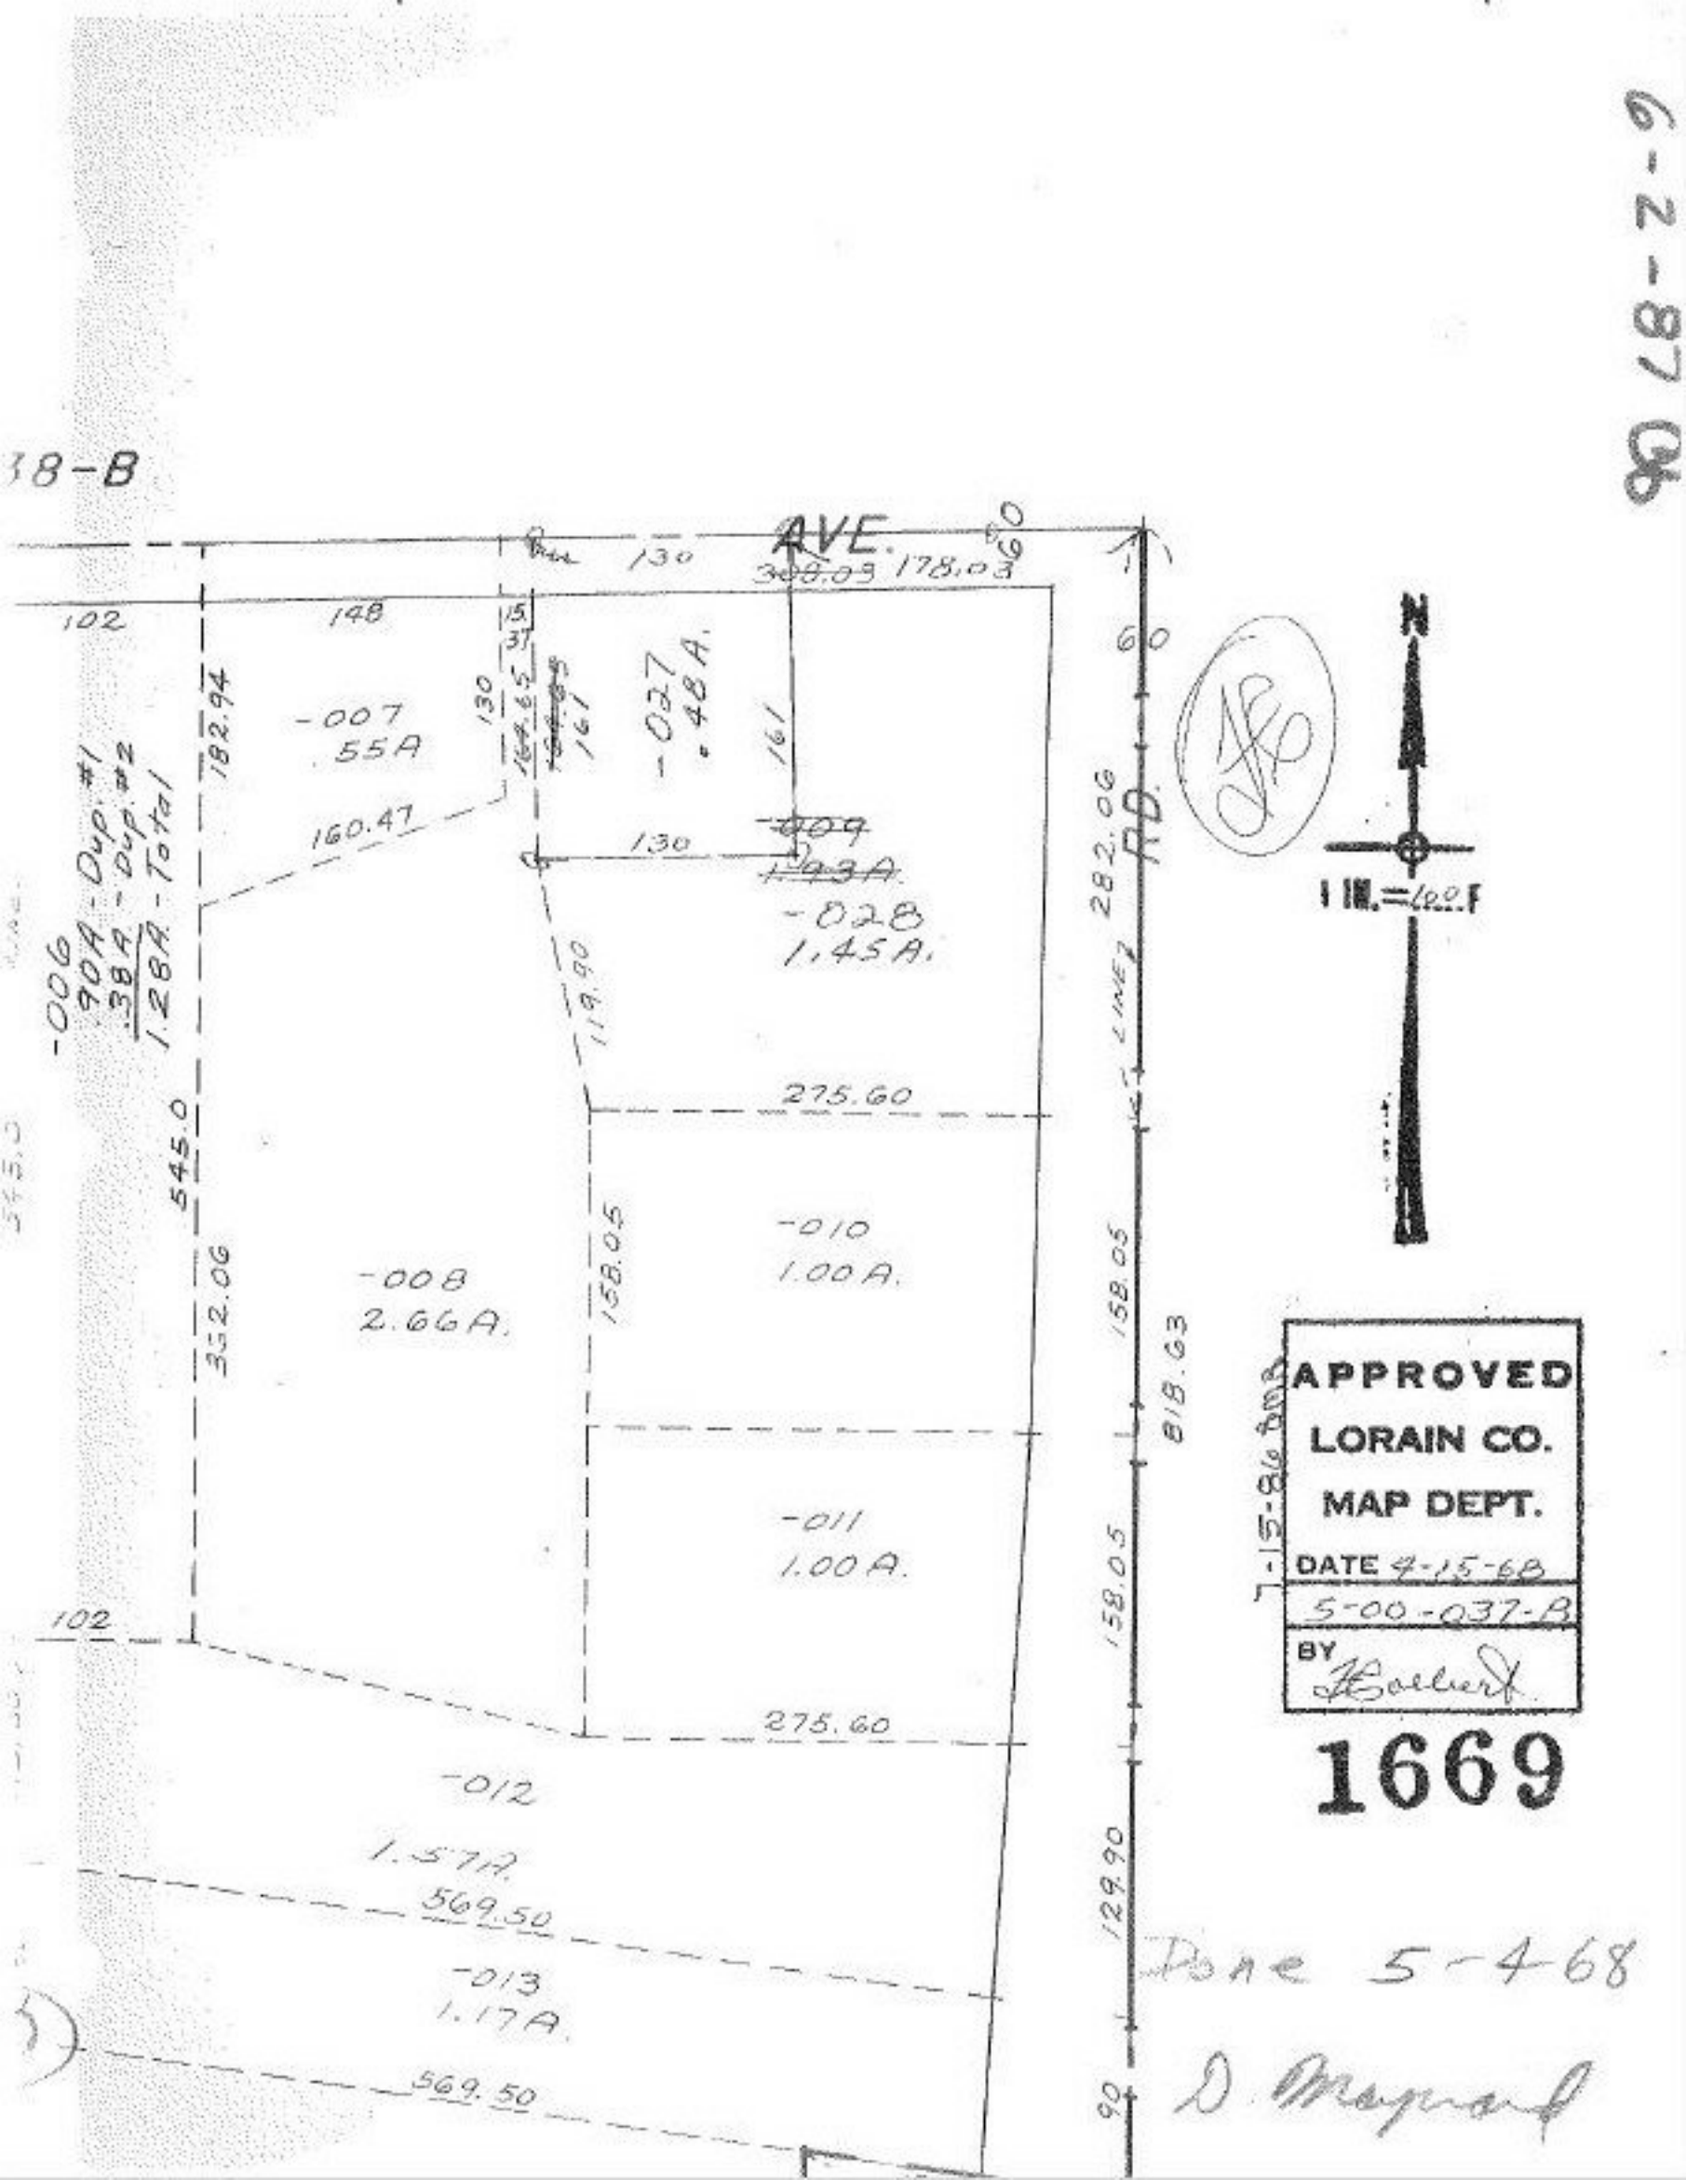
38-B
AVE.
130
178.03
102
148
182.94
-007
.55A
130
-027
.48A.
161
160.47
130
-028
1.45A.
-006
.904 - Dup. #1
.382 - Dup. #2
1.286A. - Total
119.90
275.60
545.0
352.06
-008
2.66A.
158.05
-010
1.00A.
158.05
-011
1.00A.
102
275.60
-012
1.57A.
569.50
-013
1.17A.
569.50
282.06
RD.
818.63
129.90
90
N
1 IN. = 100 F
APPROVED
LORAIN CO.
MAP DEPT.
DATE 4-15-68
5-00-037-B
BY
1669
Date 5-4-68