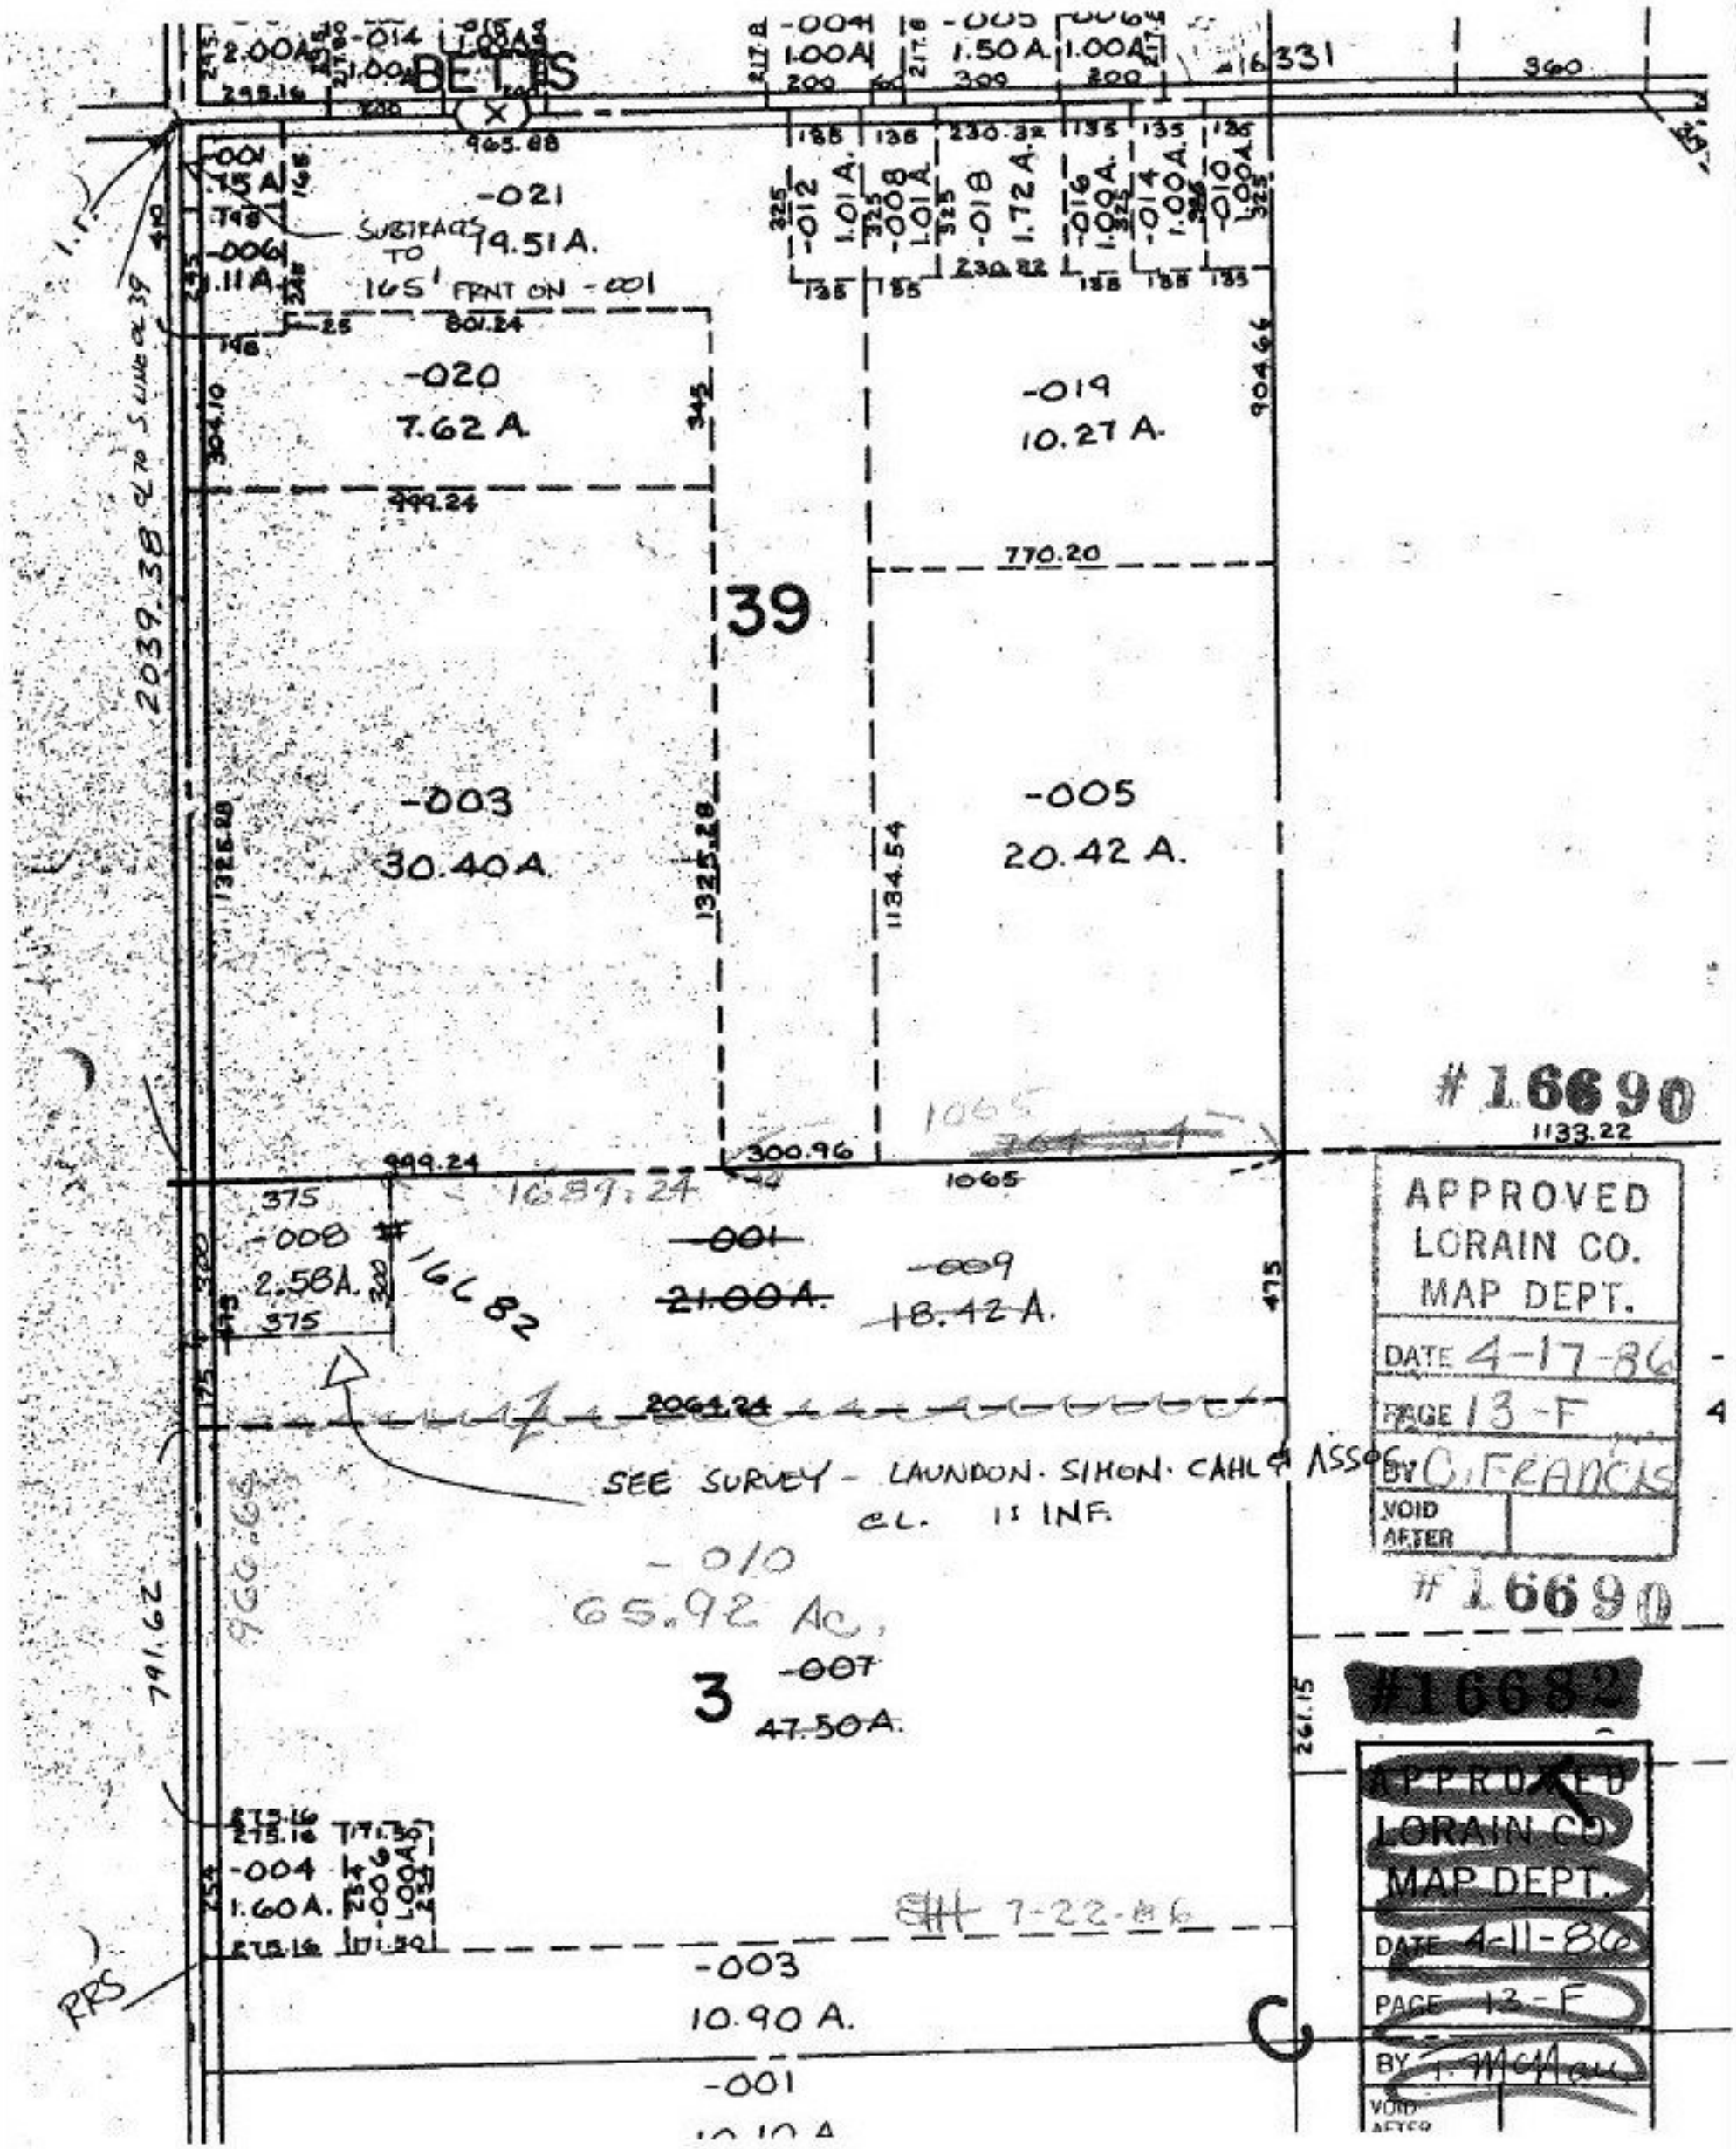
BETTS
-004
1.00A
-005
1.50 A.
1.00A
16331
360
965.88
-001
.15 A
-006
1.11 A
-021
19.51 A.
SUBTRACTS TO 165' FRNT ON -001
-012
1.01 A.
-008
1.01 A.
-018
1.72 A.
-016
1.00 A.
-014
1.00 A.
-010
1.00 A.
801.24
-020
7.62 A.
-019
10.27 A.
904.66
999.24
770.20
39
2039.38 CL TO S. LINE OL 39
-003
30.40 A.
-005
20.42 A.
1325.28
1134.54
#16690
1133.22
1065
300.96
999.24
1689.24
375
-008
2.58 A.
375
#16682
-001
21.00 A.
-009
18.42 A.
475
2064.24
SEE SURVEY - LAUNDON · SIMON · CAHL & ASSOC.
CL. IS INF.
-010
65.92 Ac.
3
-007
47.50 A.
791.62
966.66
261.15
275.16
-004
1.60 A.
-006
1.00 A.
7-22-86
-003
10.90 A.
-001
RRS
APPROVED
LORAIN CO.
MAP DEPT.
DATE 4-17-86
PAGE 13-F
BY C. FRANCIS
VOID AFTER
#16690
#16682
APPROVED
LORAIN CO.
MAP DEPT.
DATE 4-11-86
PAGE 13-F
BY T. McMau
VOID AFTER