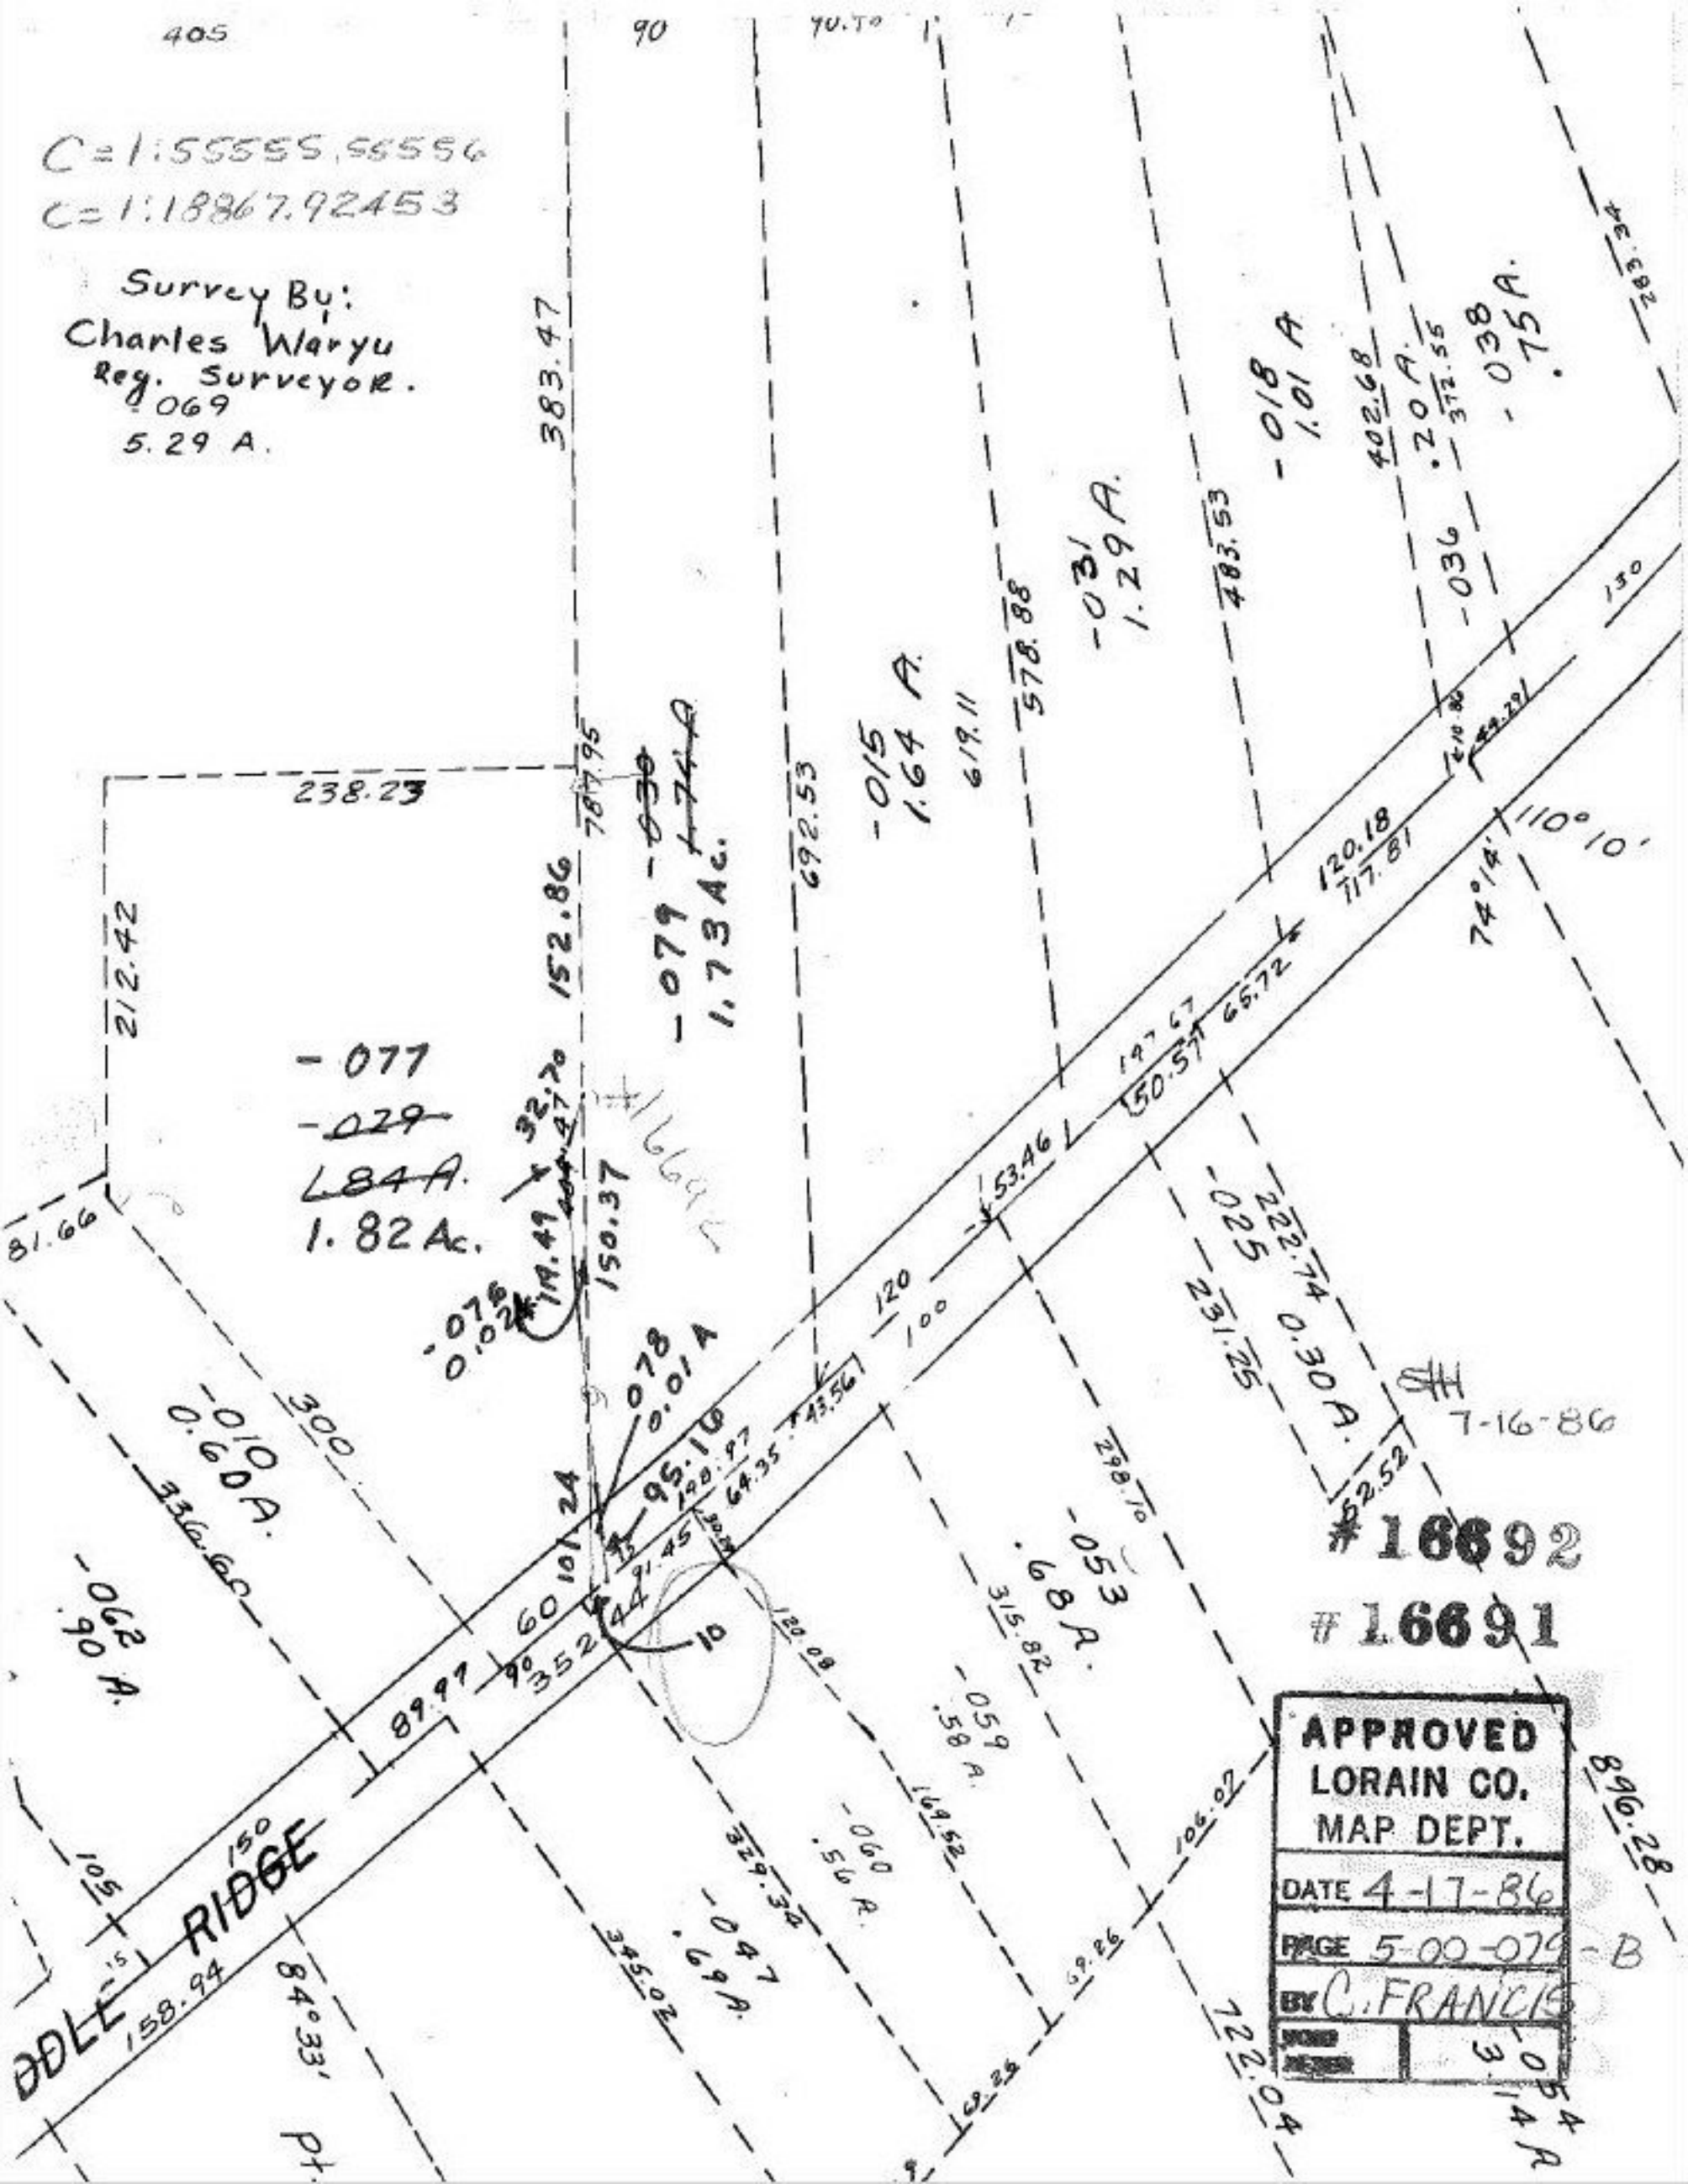
C=1:55555.55556
C=1:18867.92453
Survey By:
Charles Waryu
Reg. Surveyor.
.069
5.29 A.
#16692
#16691
7-16-86
APPROVED
LORAIN CO.
MAP DEPT.
DATE 4-17-86
PAGE 5-00-079-B
BY C. FRANCIS
RIDGE
DDLE
-077
-029
1.84 A.
1.82 Ac.
-079
1.73 Ac.
-015
1.64 A.
-031
1.29 A.
-018
1.01 A
-038
.75 A.
-010
0.60 A.
-062
.90 A.
-053
.68 A.
-059
.58 A.
-060
.56 A.
-047
.69 A.
-025
0.30 A.
-054
3.14 A
383.47
238.23
212.42
152.86
150.37
81.66
300
336.60
89.97
352.44
95.16
101.24
120.18
117.81
110°10'
74°14'
84°33'
158.94
105
150
120
100
53.46
65.72
50.57
222.74
231.25
52.52
298.10
315.82
169.52
329.34
345.02
106.02
69.26
722.04
896.28
283.34
402.68
372.55
483.53
578.88
619.11
692.53
787.95