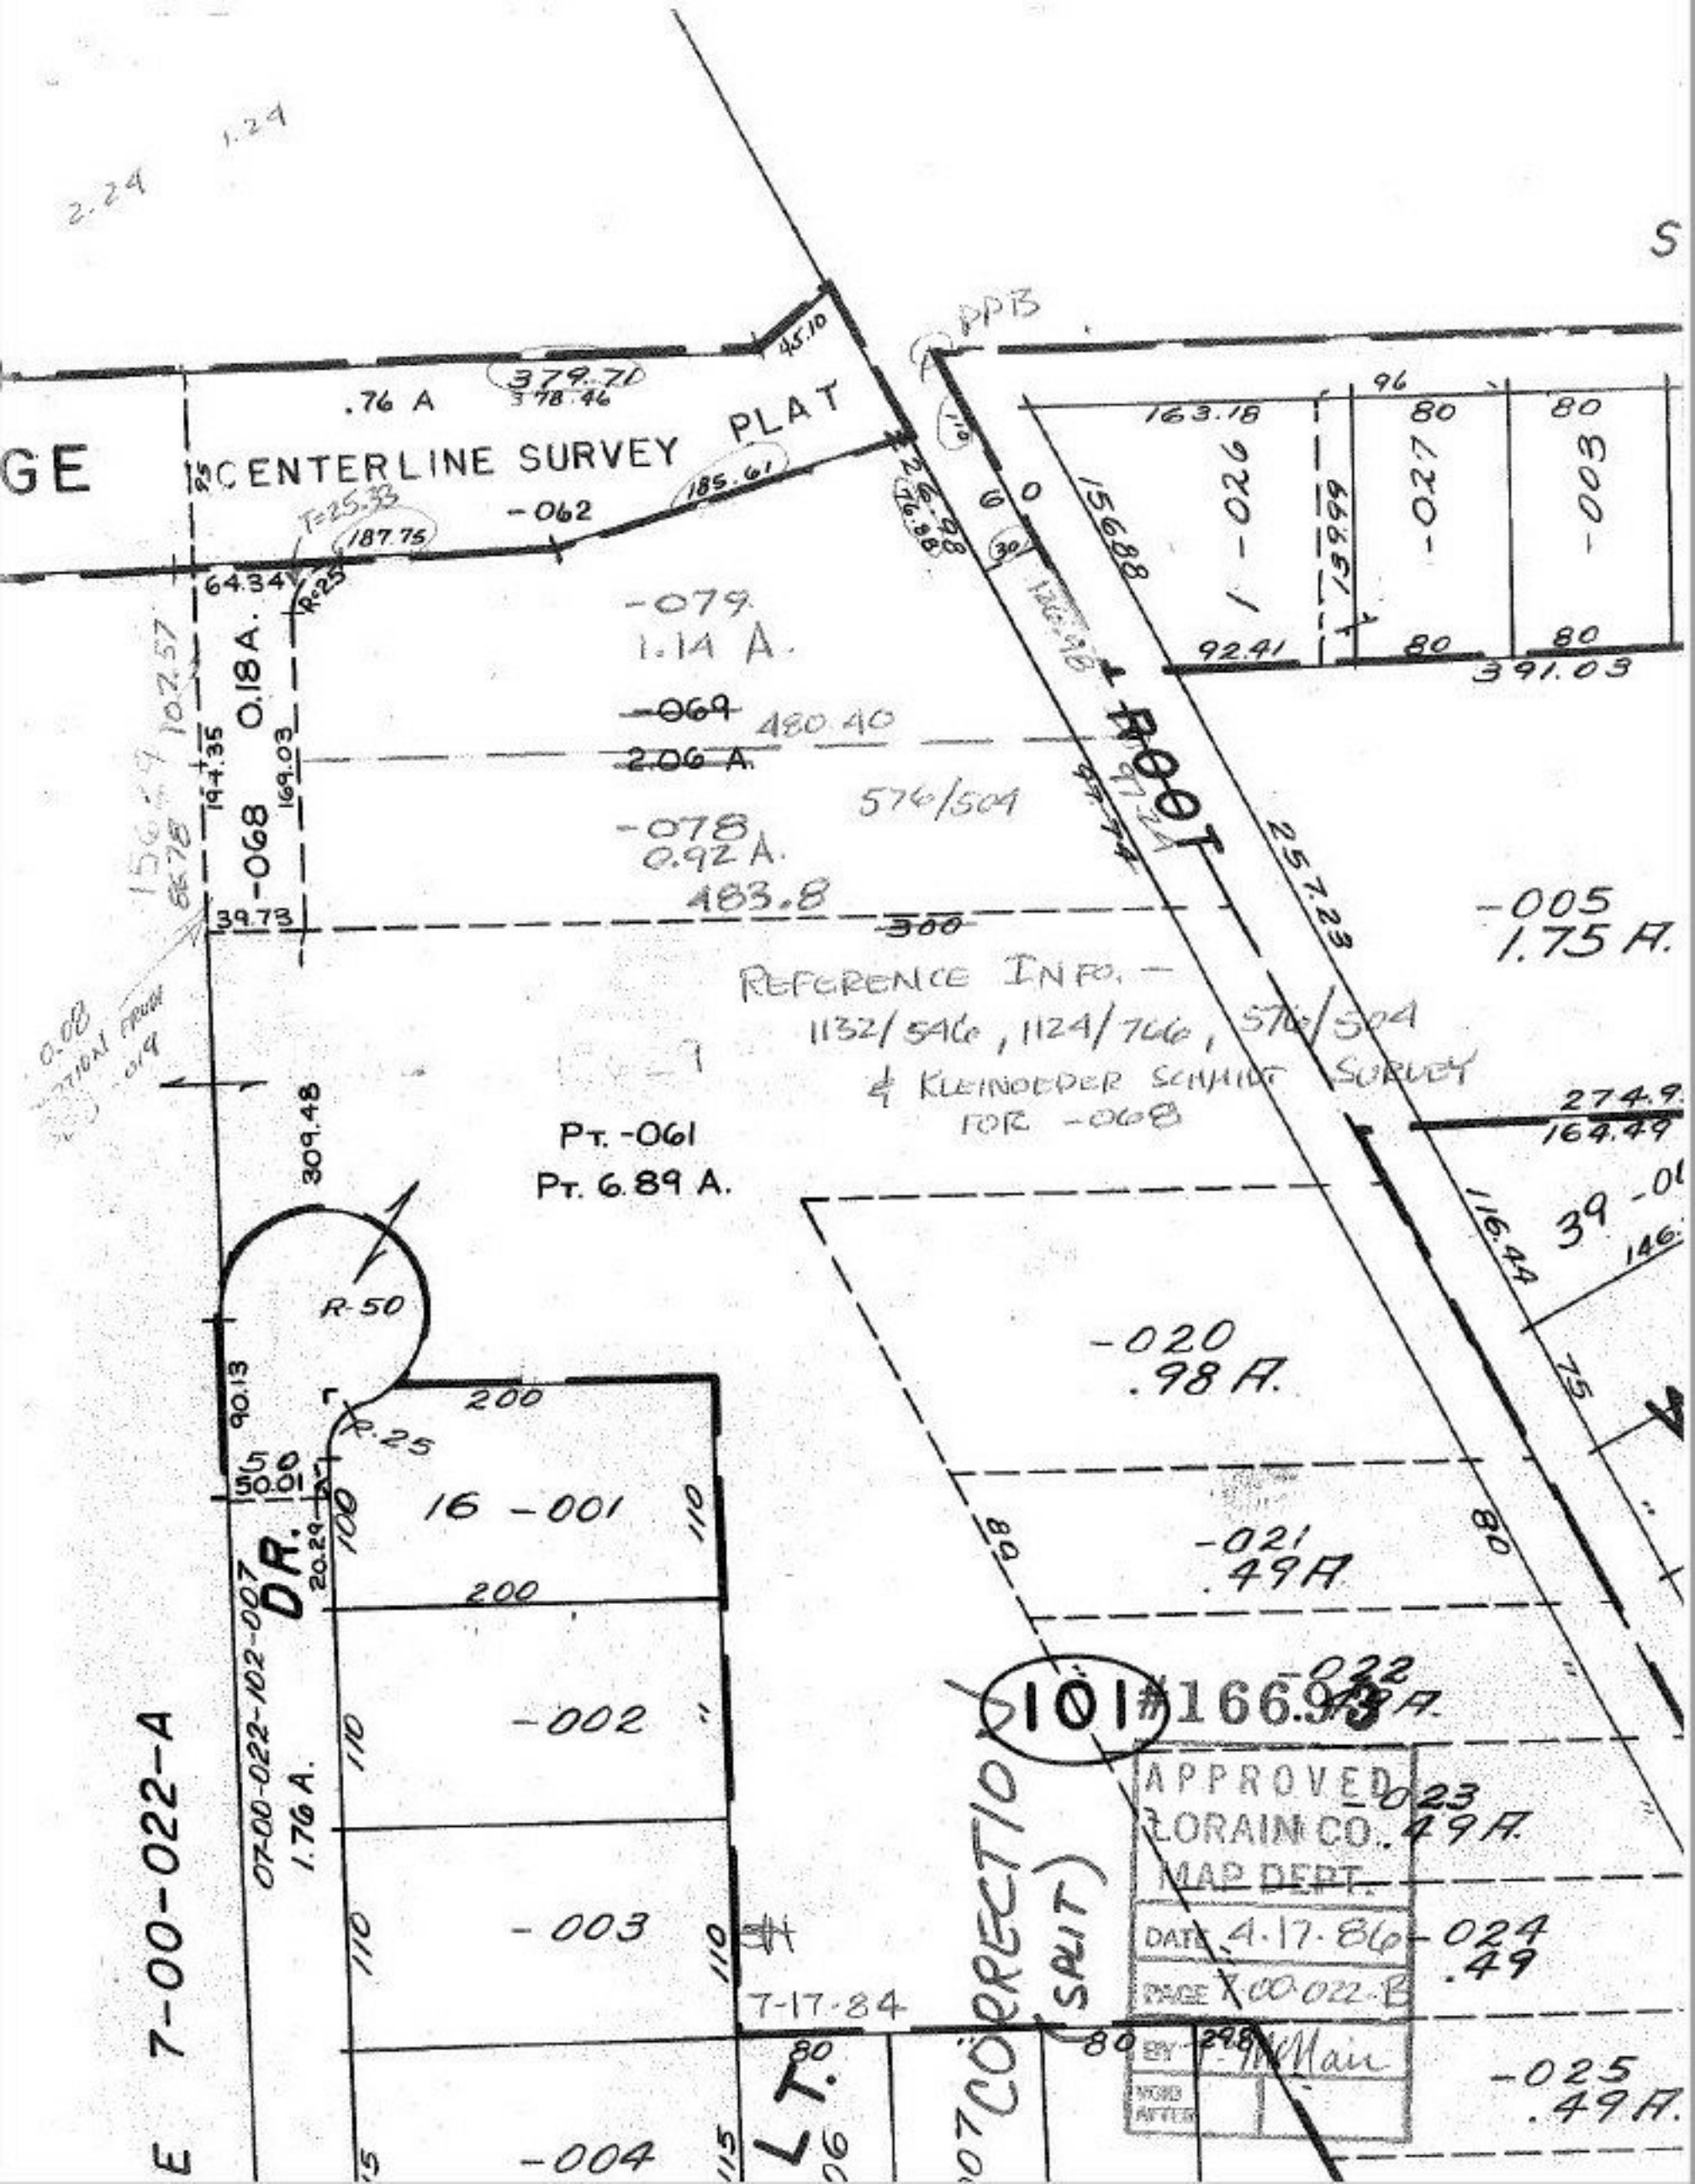

GE
CENTERLINE SURVEY PLAT
.76 A
379.71
378.46
45.10
185.61
187.75
-062
T=25.33
64.34
R=25
-079
1.14 A.
-069
480.40
2.06 A.
576/504
-078
0.92 A.
483.8
-300
0.18 A.
-068
194.35
169.03
39.73
REFERENCE INFO. -
1132/546, 1124/766, 576/504
& KLEINOEDER SCHMIDT SURVEY
FOR -068
PT. -061
PT. 6.89 A.
309.48
R-50
R-25
90.13
50.01
20.29
16 -001
200
-002
-003
-004
DR.
07-00-022-102-007
1.76 A.
7-00-022-A
7-17-84
LT.
CORRECTION
(SPLIT)
101
#166.93
APPROVED
LORAIN CO.
MAP DEPT.
DATE 4-17-86
PAGE 7-00-022-B
BY
VOID AFTER
-005
1.75 A.
-020
.98 A.
-021
.49 A.
-022
-023
.49 A.
-024
.49
-025
.49 A.
-026
-027
-003
163.18
92.41
391.03
80
96
139.99
156.88
257.23
116.44
274.9
164.49
39 -0
146.
75