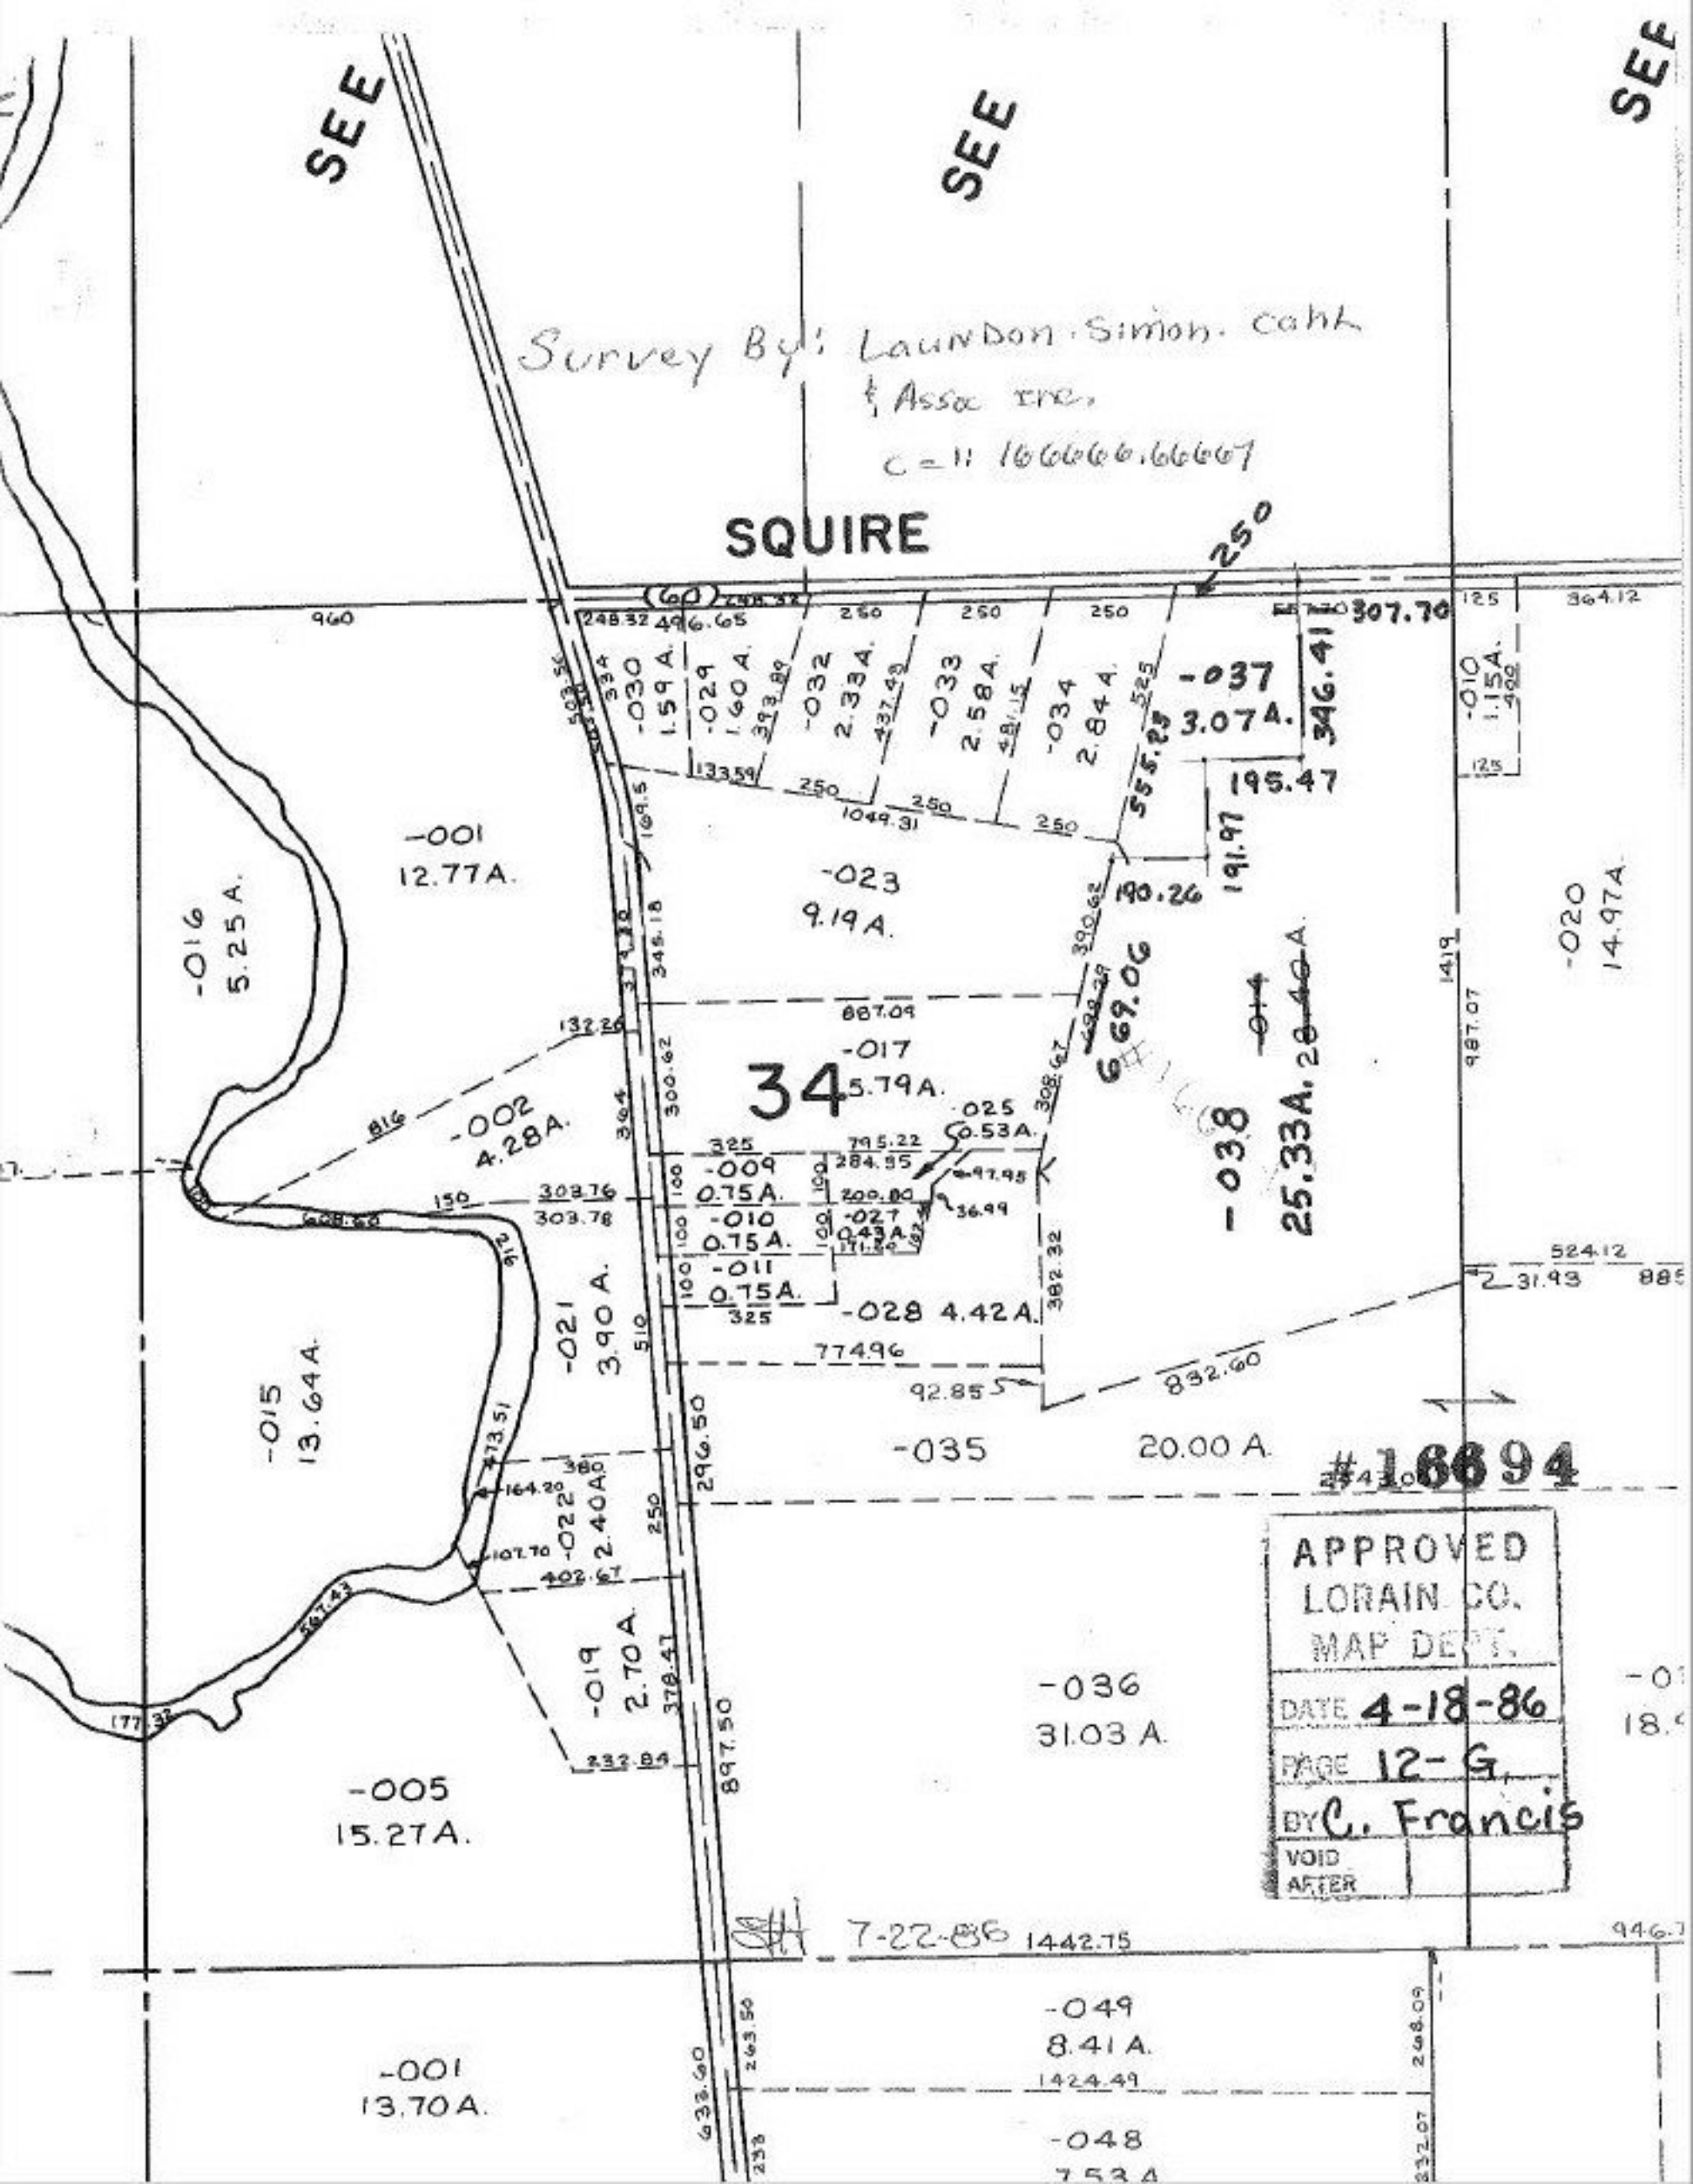
SEE
SEE
SEE
Survey By: Laundon Simon Cahl
& Assoc Inc.
C=11 166666.66667
SQUIRE
250
(60)
960
248.32
496.65
250
250
250
307.70
125
364.12
-030
1.59 A.
-029
1.60 A.
-032
2.33 A.
-033
2.58 A.
-034
2.84 A.
-037
3.07 A.
346.41
195.47
191.97
190.26
555.25
-010
1.15 A.
133.59
1049.31
-001
12.77 A.
-023
9.19 A.
-016
5.25 A.
-020
14.97 A.
669.06
-038
25.33 A.
887.09
-017
5.79 A.
34
-002
4.28 A.
-025
0.53 A.
-009
0.75 A.
-010
0.75 A.
-011
0.75 A.
-027
0.43 A.
-028 4.42 A.
-021
3.90 A.
-015
13.64 A.
-035
20.00 A.
#16694
-022
2.40 A.
-019
2.70 A.
-036
31.03 A.
-005
15.27 A.
7-22-86
1442.75
-049
8.41 A.
-001
13.70 A.
1424.49
-048
APPROVED
LORAIN CO.
MAP DEPT.
DATE 4-18-86
PAGE 12-G
BY C. Francis
VOID
AFTER