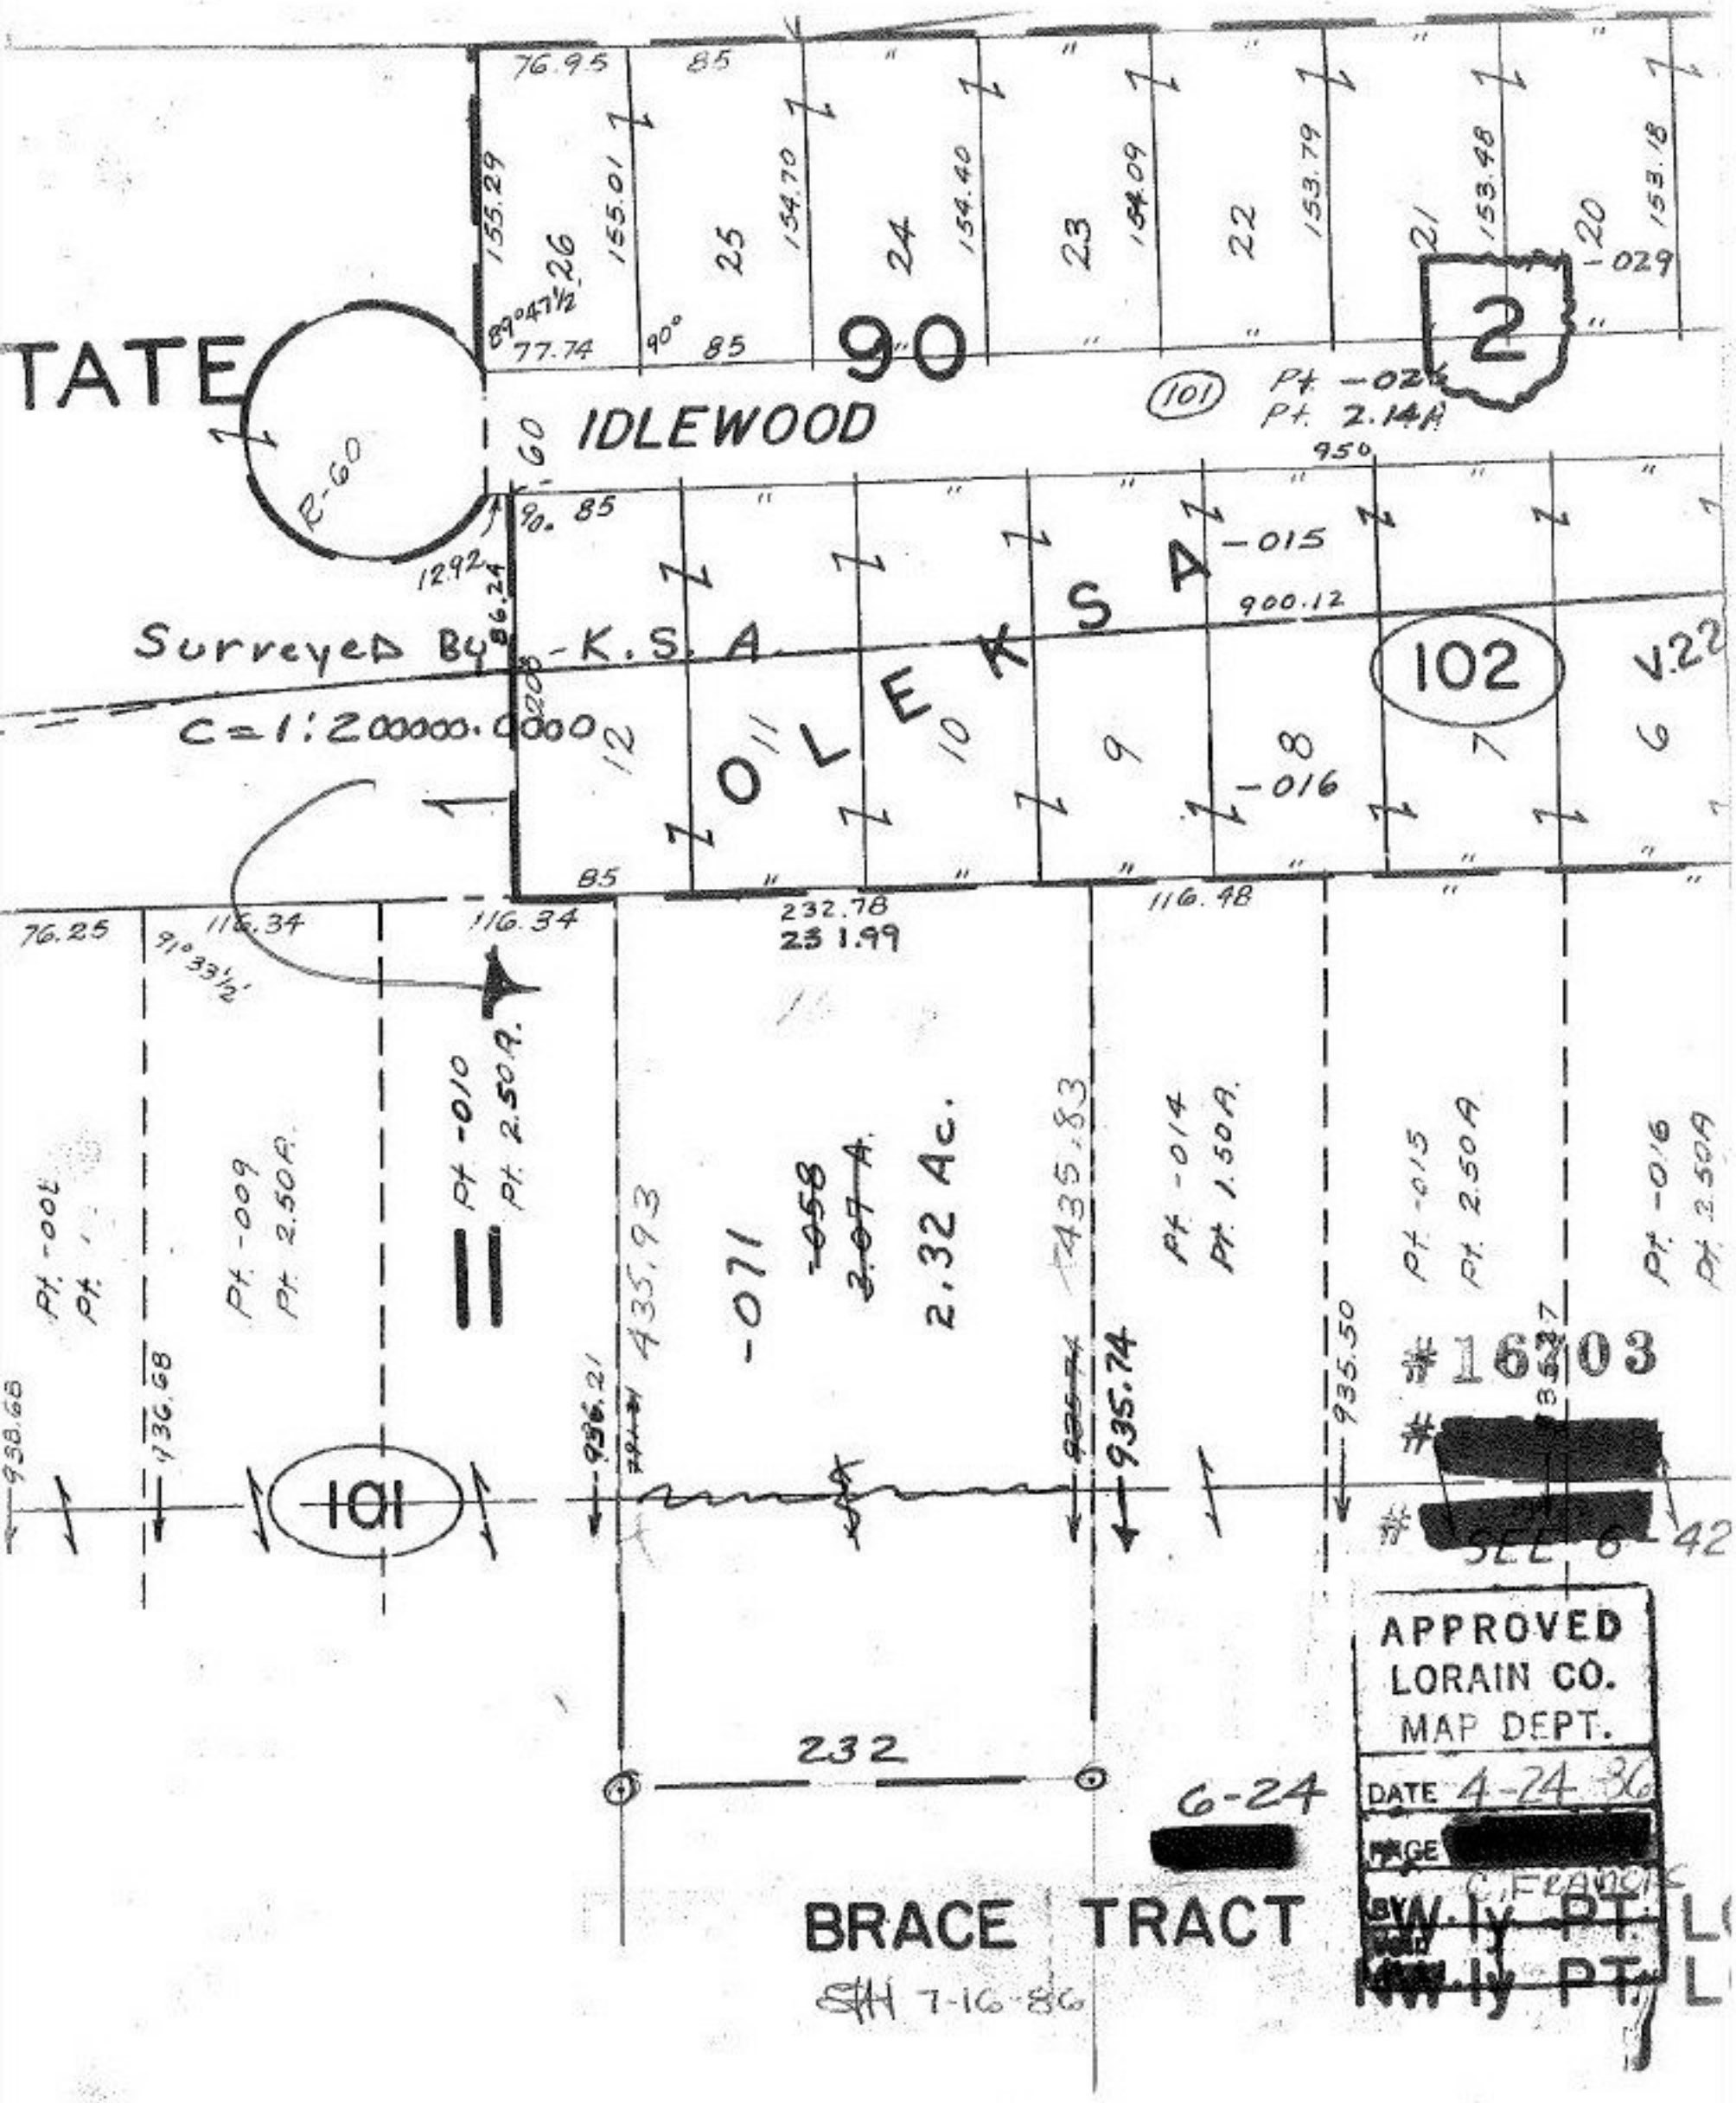

TATE
IDLEWOOD
90
2
101
Pt. -026
Pt. 2.14A
R-60
Surveyed By -K.S.A.
C=1:200000.0000
OLEKSA
102
V.22
-015
-016
-029
-071
2.32 Ac.
Pt. -010
Pt. 2.50A.
Pt. -009
Pt. 2.50A.
Pt. -014
Pt. 1.50A.
Pt. -015
Pt. 2.50A
Pt. -016
Pt. 2.50A
101
232
6-24
[redacted]
BRACE TRACT
SH 7-16-86
#16703
#[redacted]
#[redacted]
SEE 6-42
APPROVED
LORAIN CO.
MAP DEPT.
DATE 4-24-86
PAGE [redacted]
BY C. FRANCIS
W-ly PT. L
NW-ly PT. L