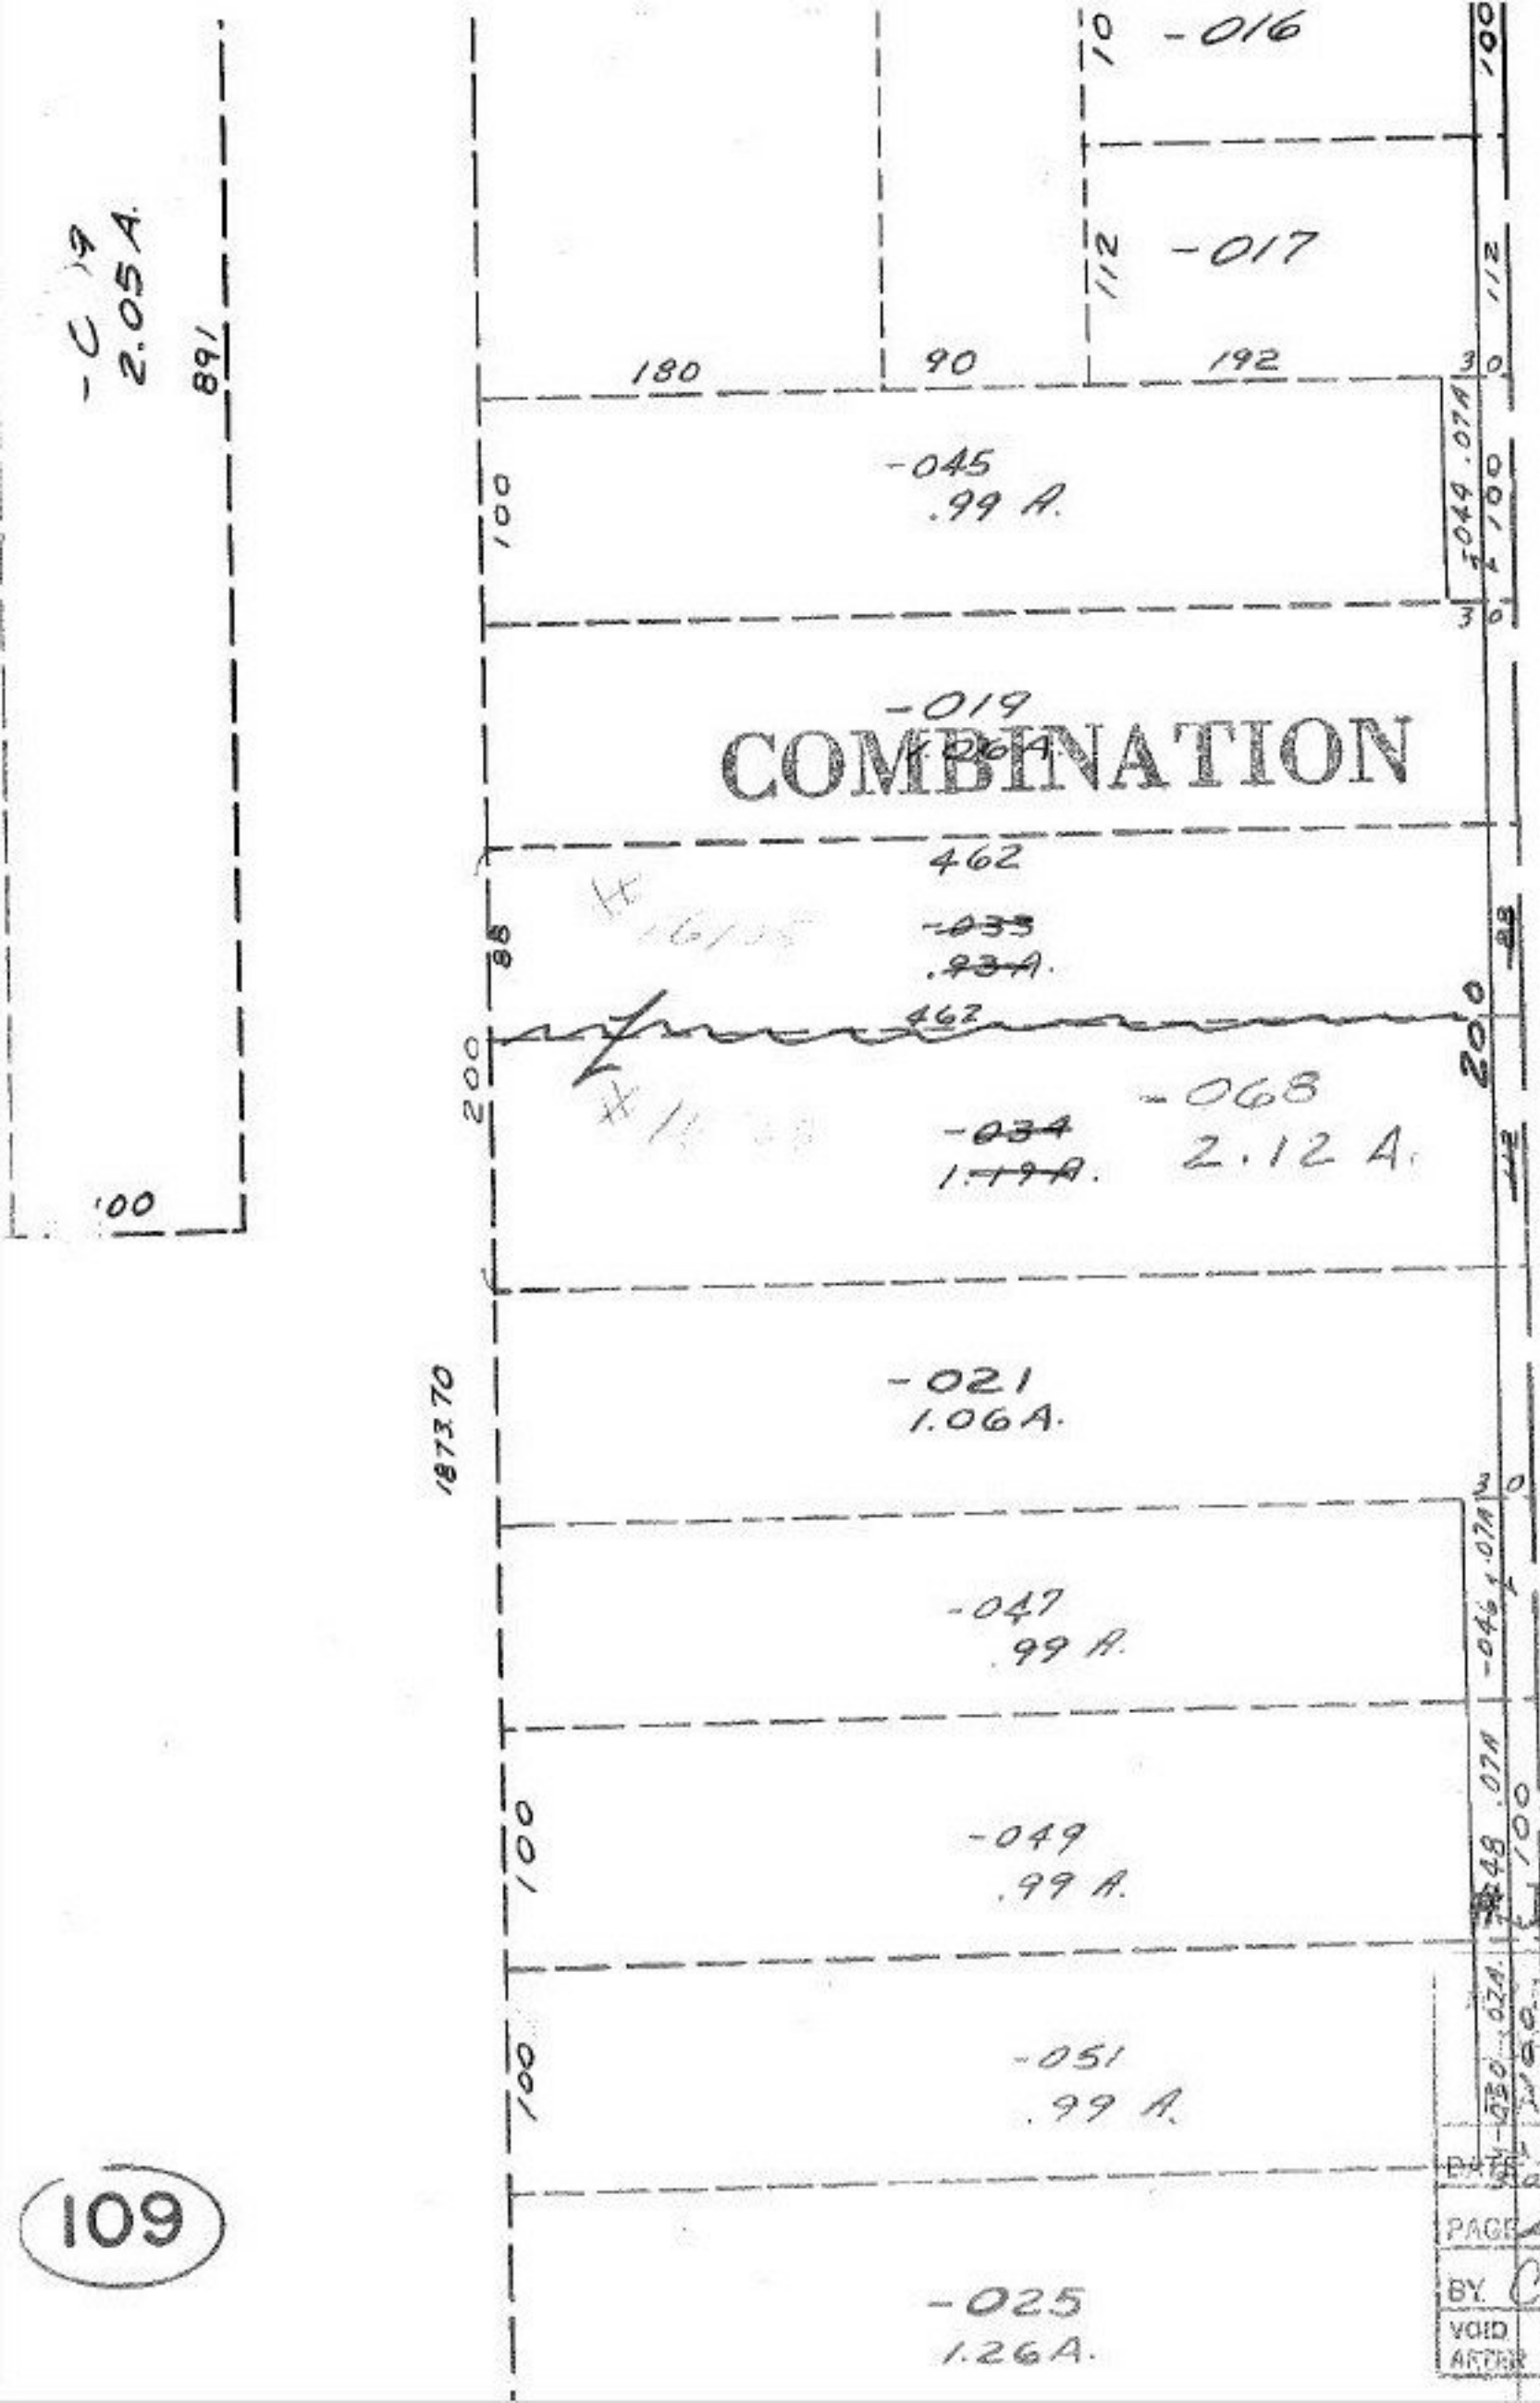
-016
-017
180
90
192
-045
.99 A.
-019
COMBINATION
462
-033
.93 A.
462
-068
2.12 A.
-034
1.19 A.
-021
1.06 A.
-047
.99 A.
-049
.99 A.
-051
.99 A.
-025
1.26 A.
891
2.05 A.
1873.70
100
200
88
112
30
7-14-86
16705
APPROVED
DRAIN CO.
MAP DEPT.
DATE 4-25-86
PAGE 4-03-026, F
BY C. FRANCIS
VOID AFTER 16705

109