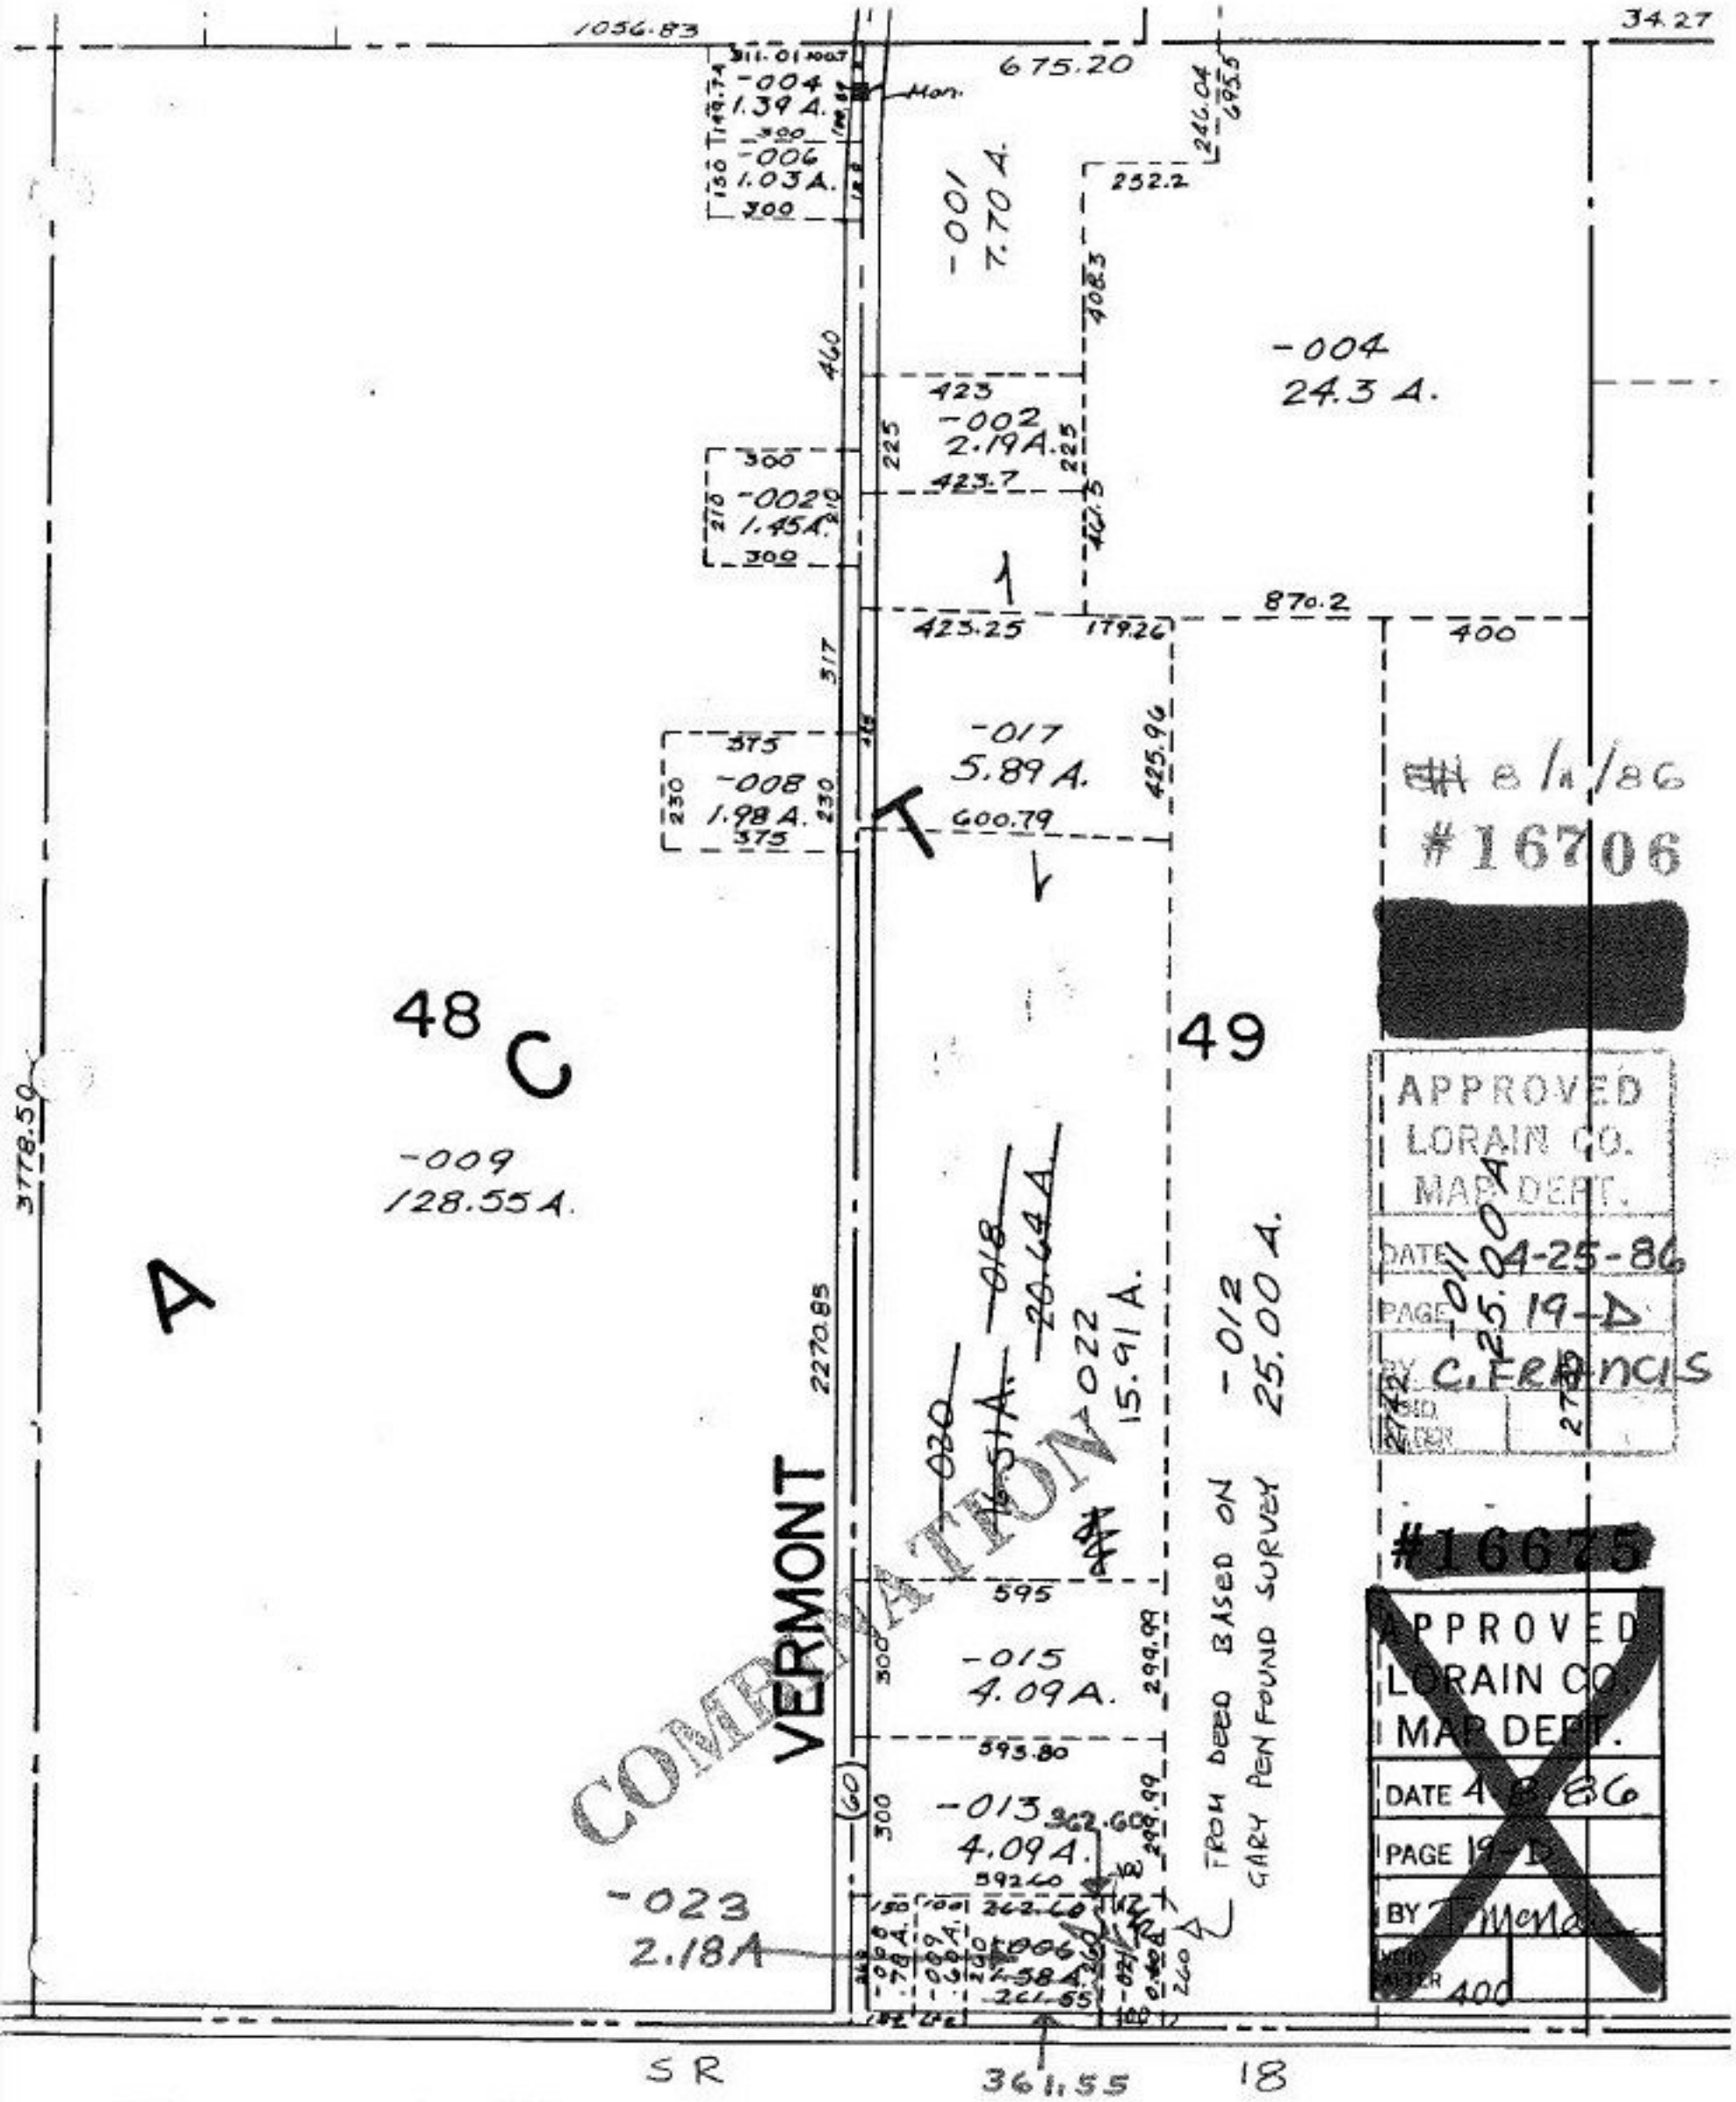

COMBINATION

8/1/86
#16706
[redacted]
APPROVED
LORAIN CO.
MAP DEPT.
DATE 4-25-86
PAGE 19-D
BY C. FRANCIS
VOID AFTER

#16675
APPROVED
LORAIN CO.
MAP DEPT.
DATE 4-8-86
PAGE 19-D
BY T. McNa
VOID AFTER 400

19-04-049-000-