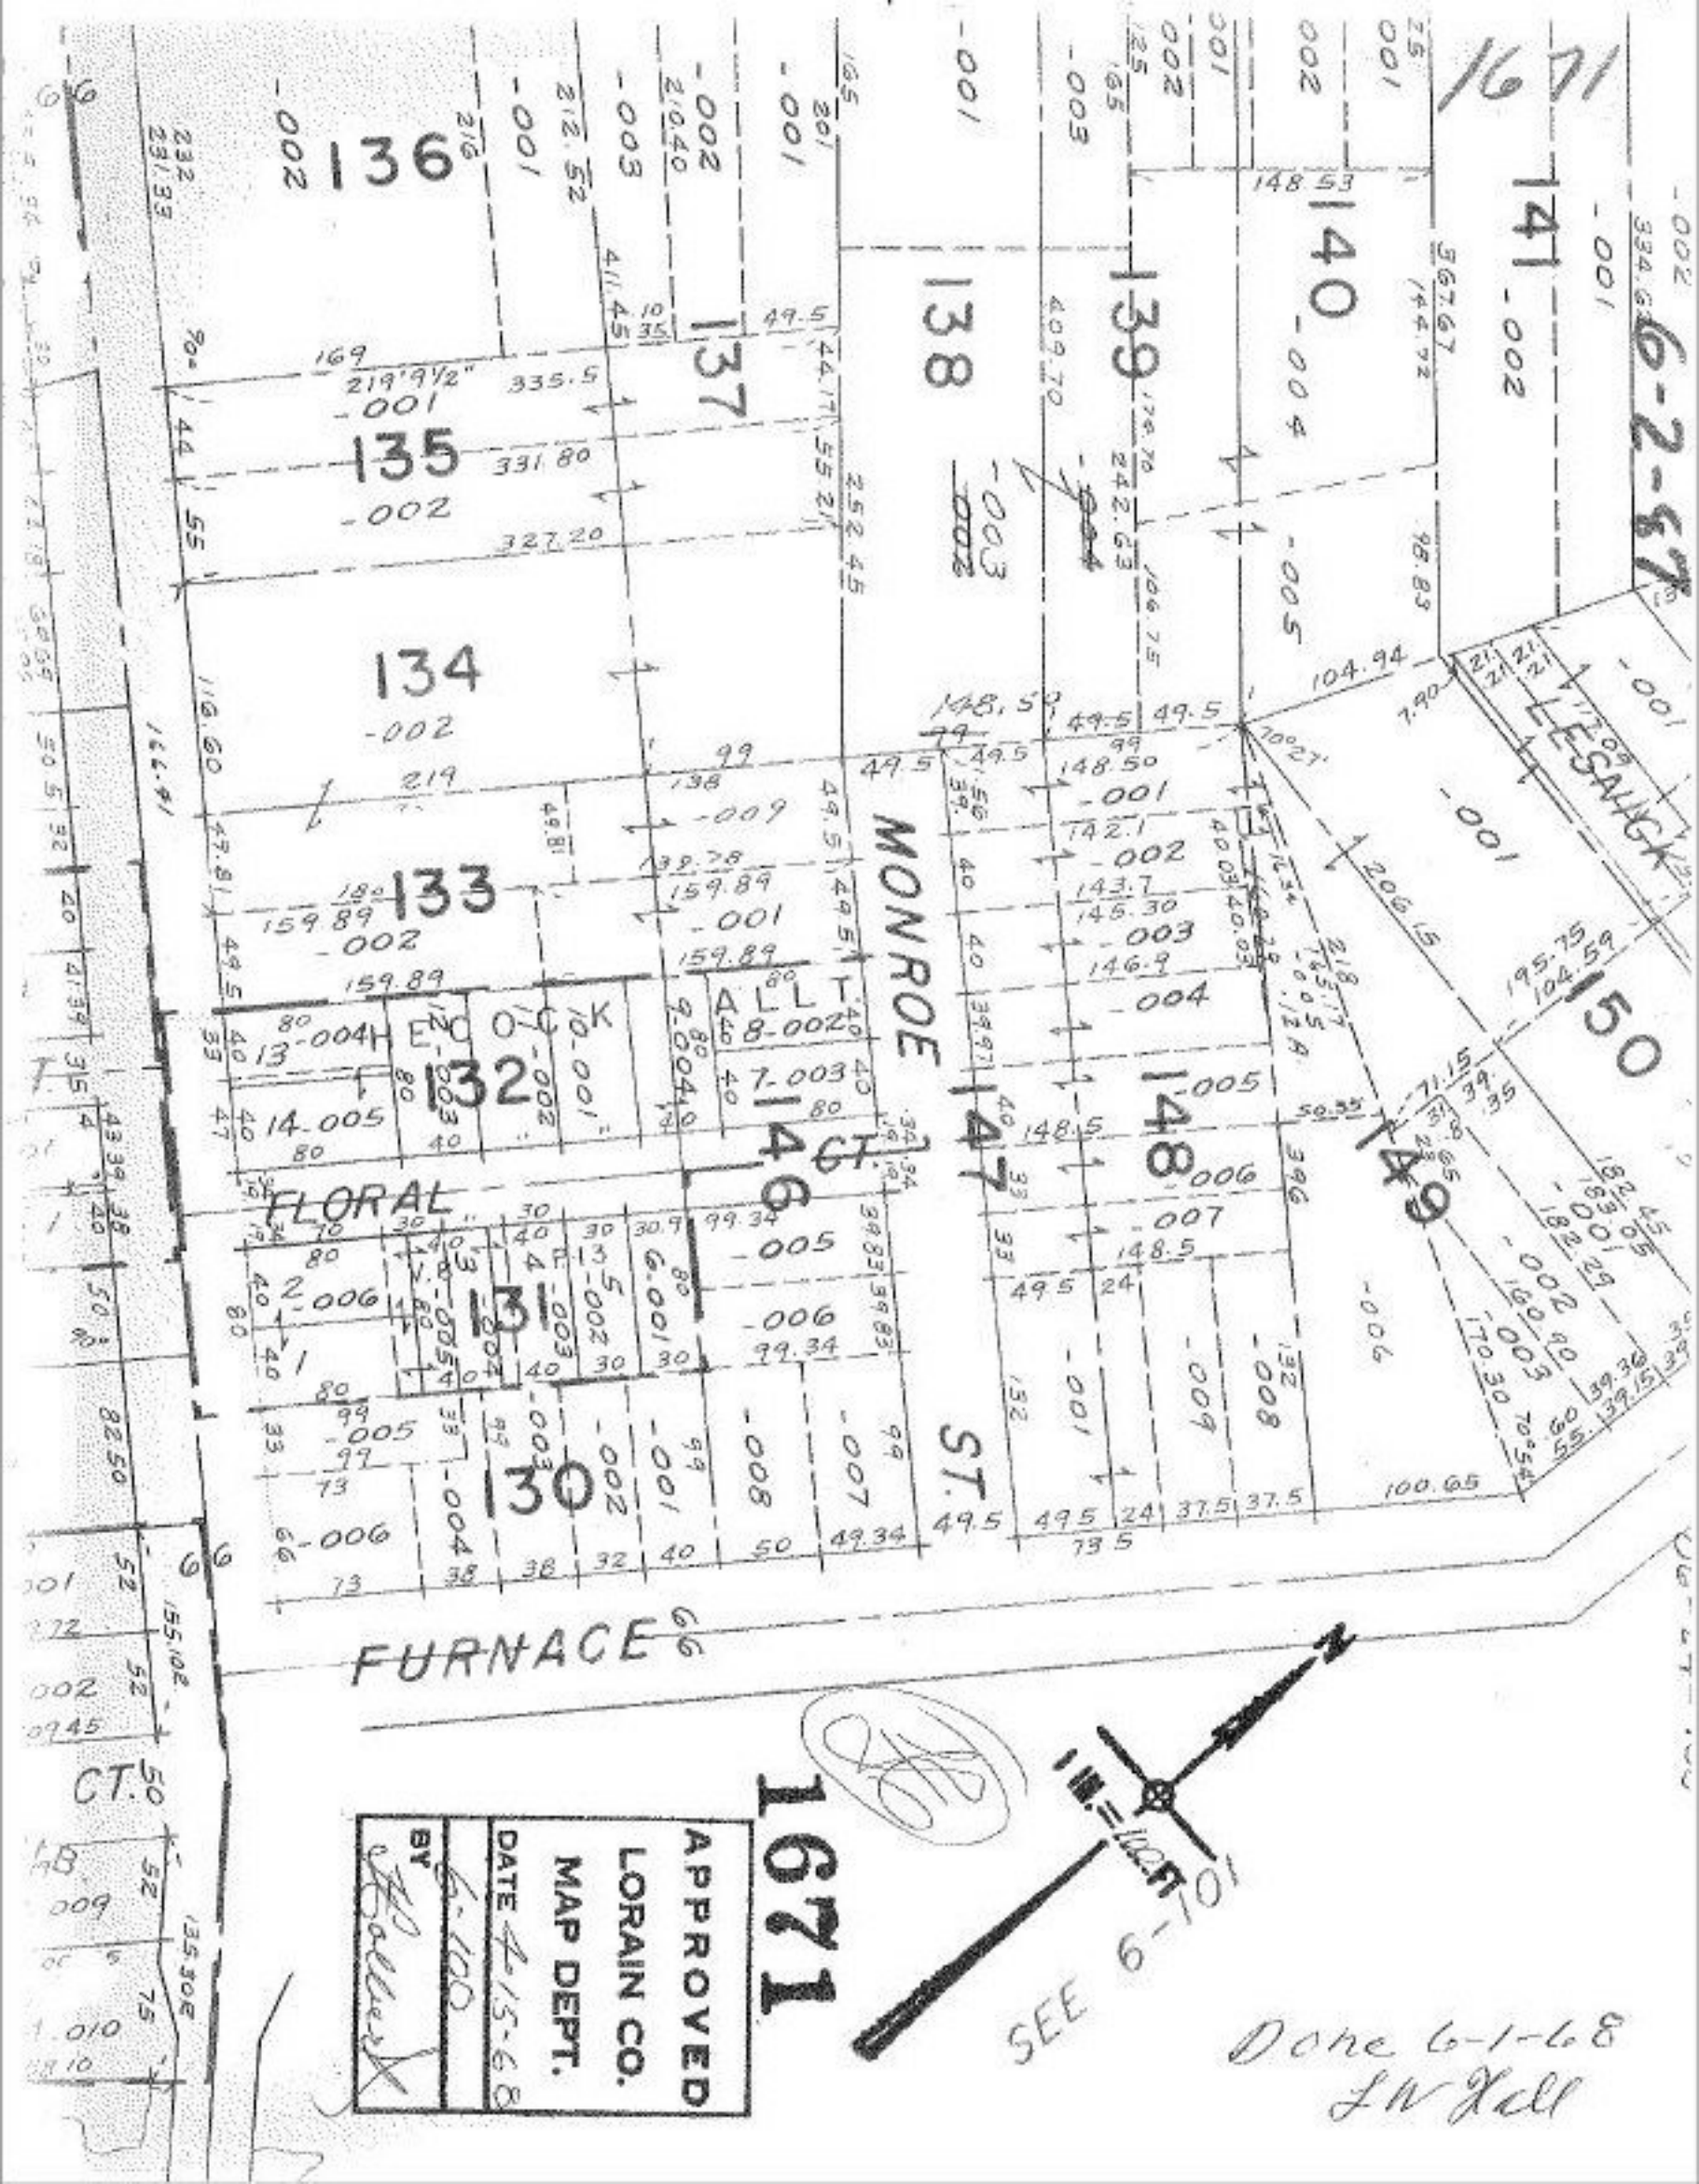
1671
6-2-67
136
135
134
133
132
131
130
137
138
139
140
141
146
147
148
149
150
HECOCK ALLT.
FLORAL
MONROE ST.
LESNICK
FURNACE
CT.
APPROVED
LORAIN CO.
MAP DEPT.
DATE 4-15-68
BY
SEE 6-101
Done 6-1-68
LW Hall