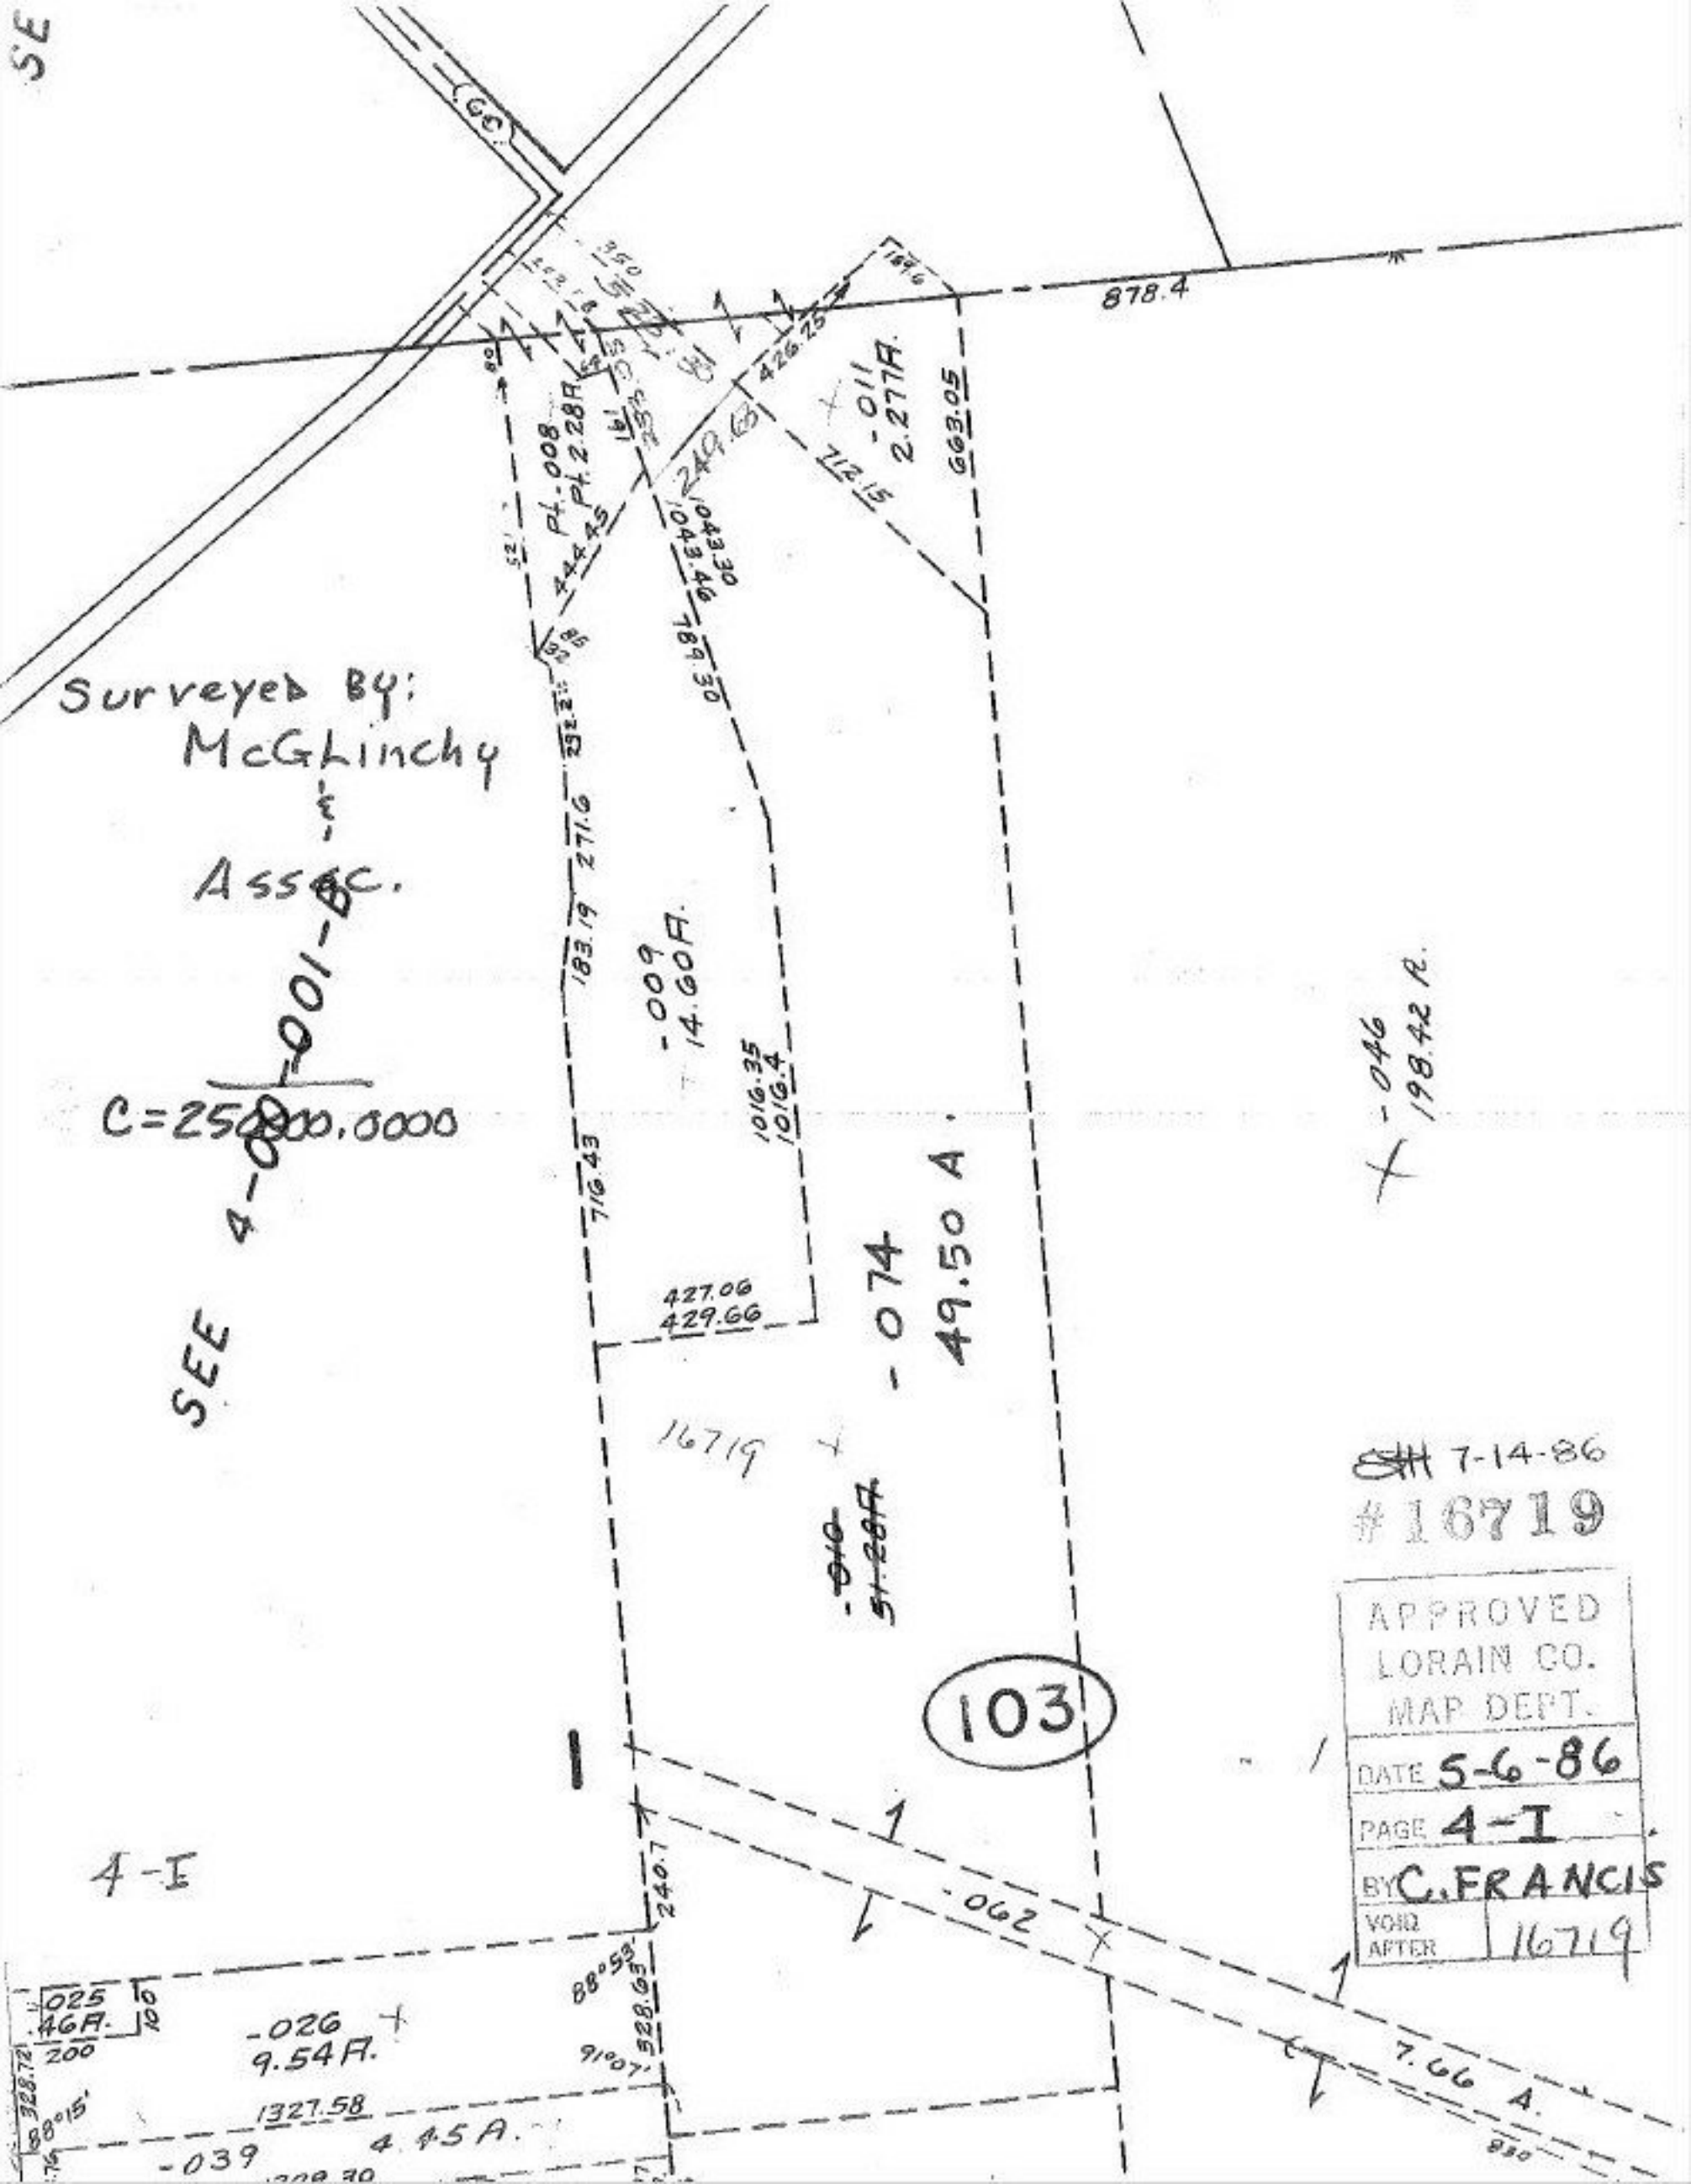

7-14-86
#16719

APPROVED
LORAIN CO.
MAP DEPT.
DATE 5-6-86
PAGE 4-I
BY C. FRANCIS
VOID AFTER 16719