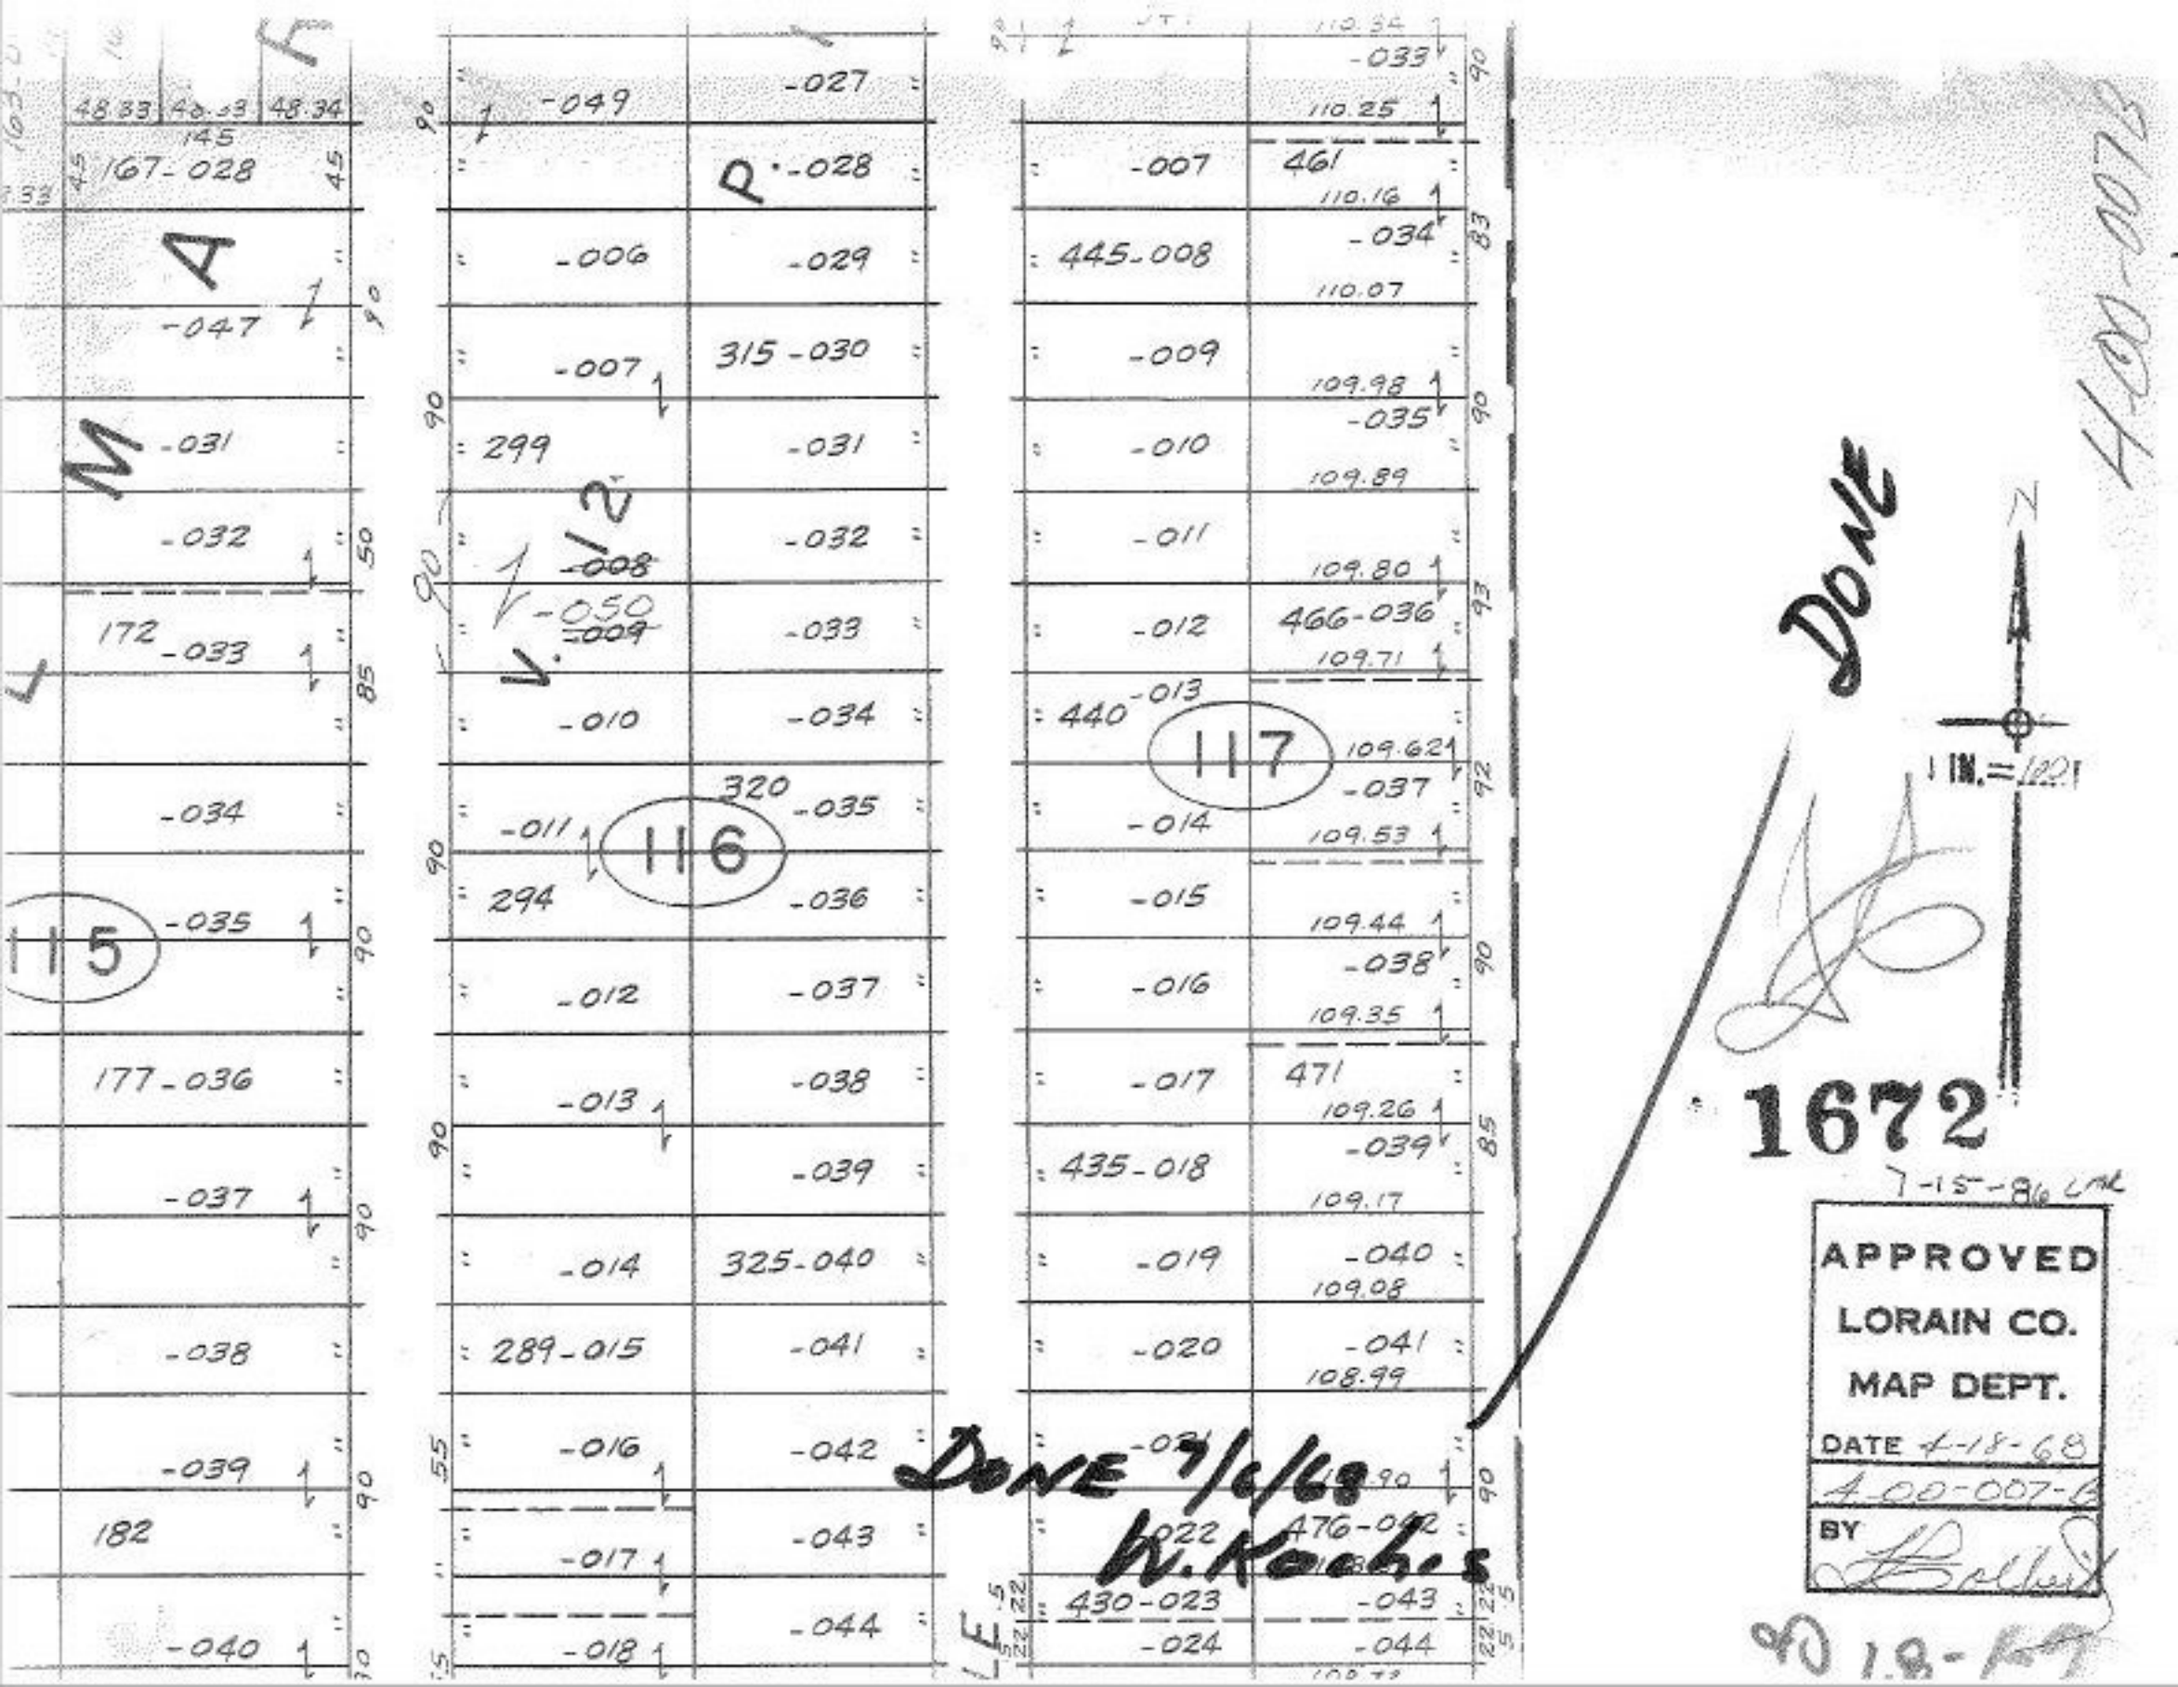

4-00-007B
DONE
1 IN. = 100'
1672
7-15-86
APPROVED
LORAIN CO.
MAP DEPT.
DATE 4-18-68
4-00-007-B
BY
DONE 7/6/68
W. Koches
115
116
117