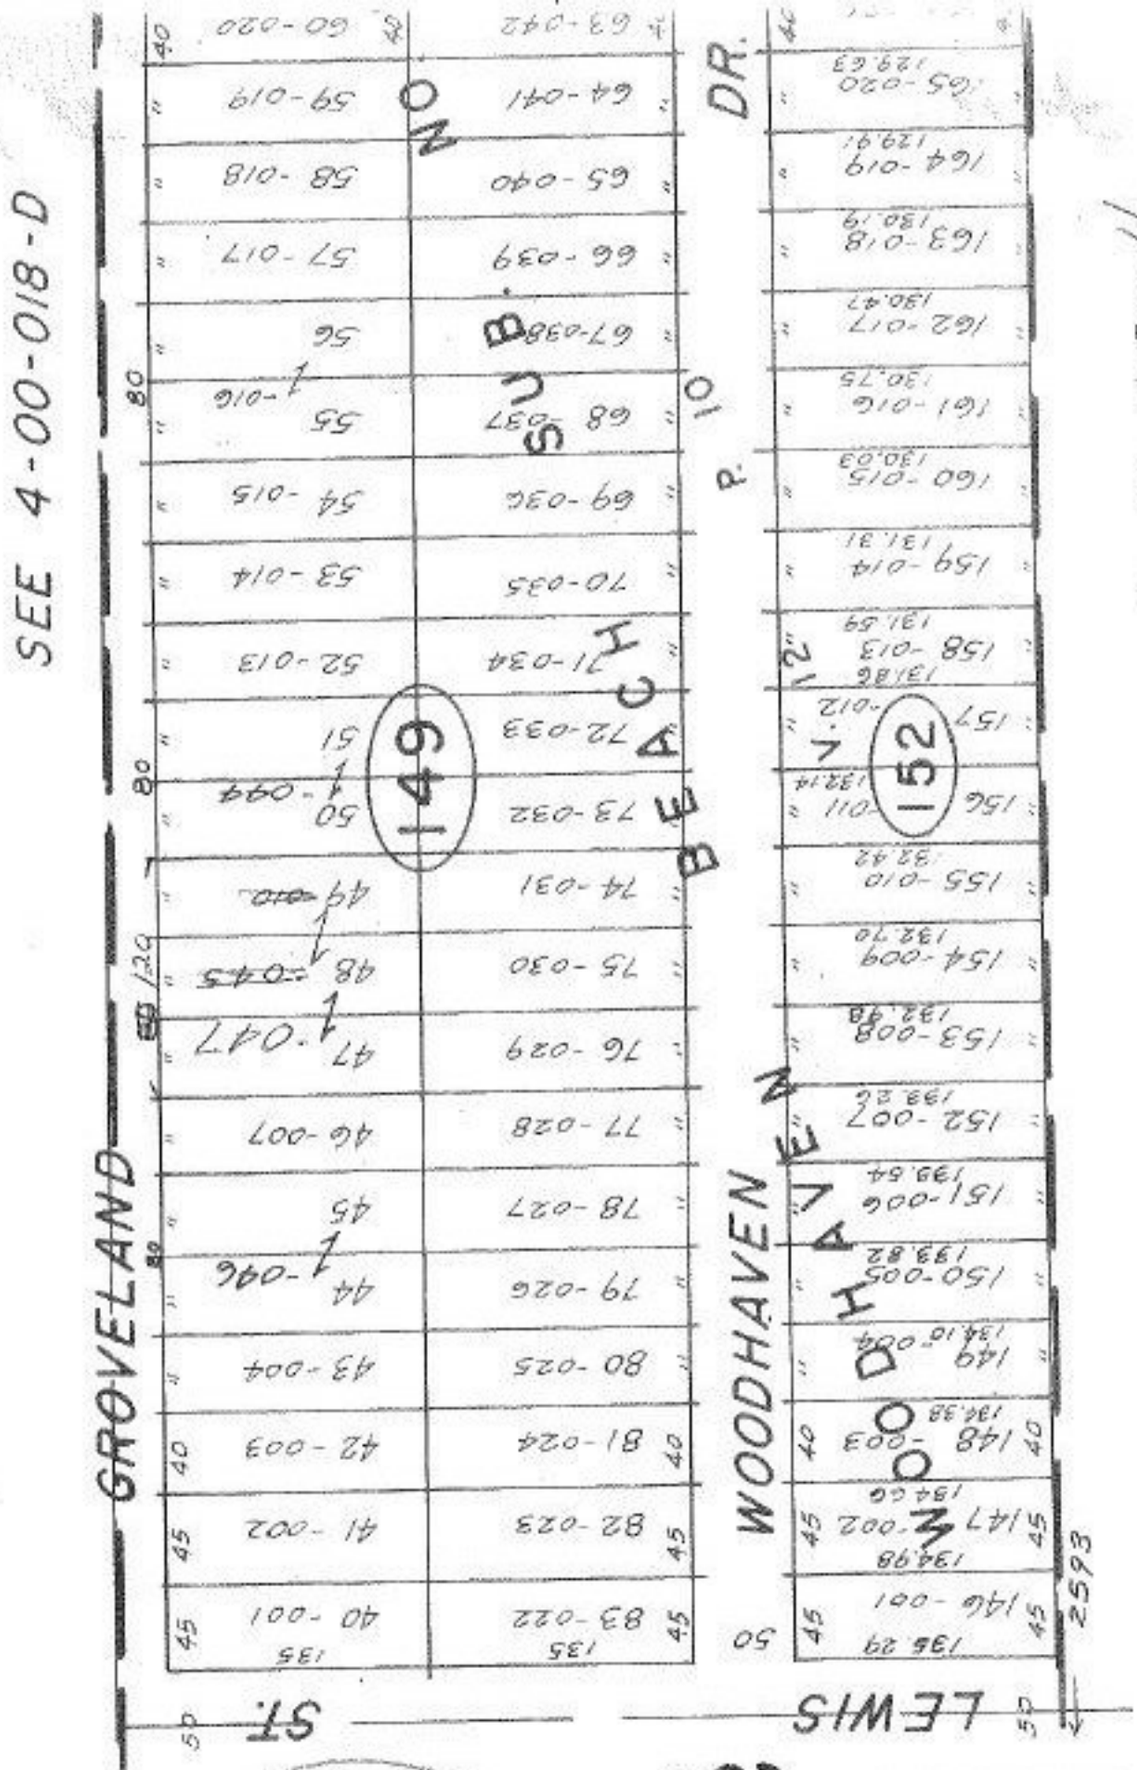

DONE 7/6/68
W. Kochis

1672

APPROVED
LORAIN CO.
MAP DEPT.
DATE 4-18-68
4-00-018-H
BY

7-15-86 L.L.

4-00-018H