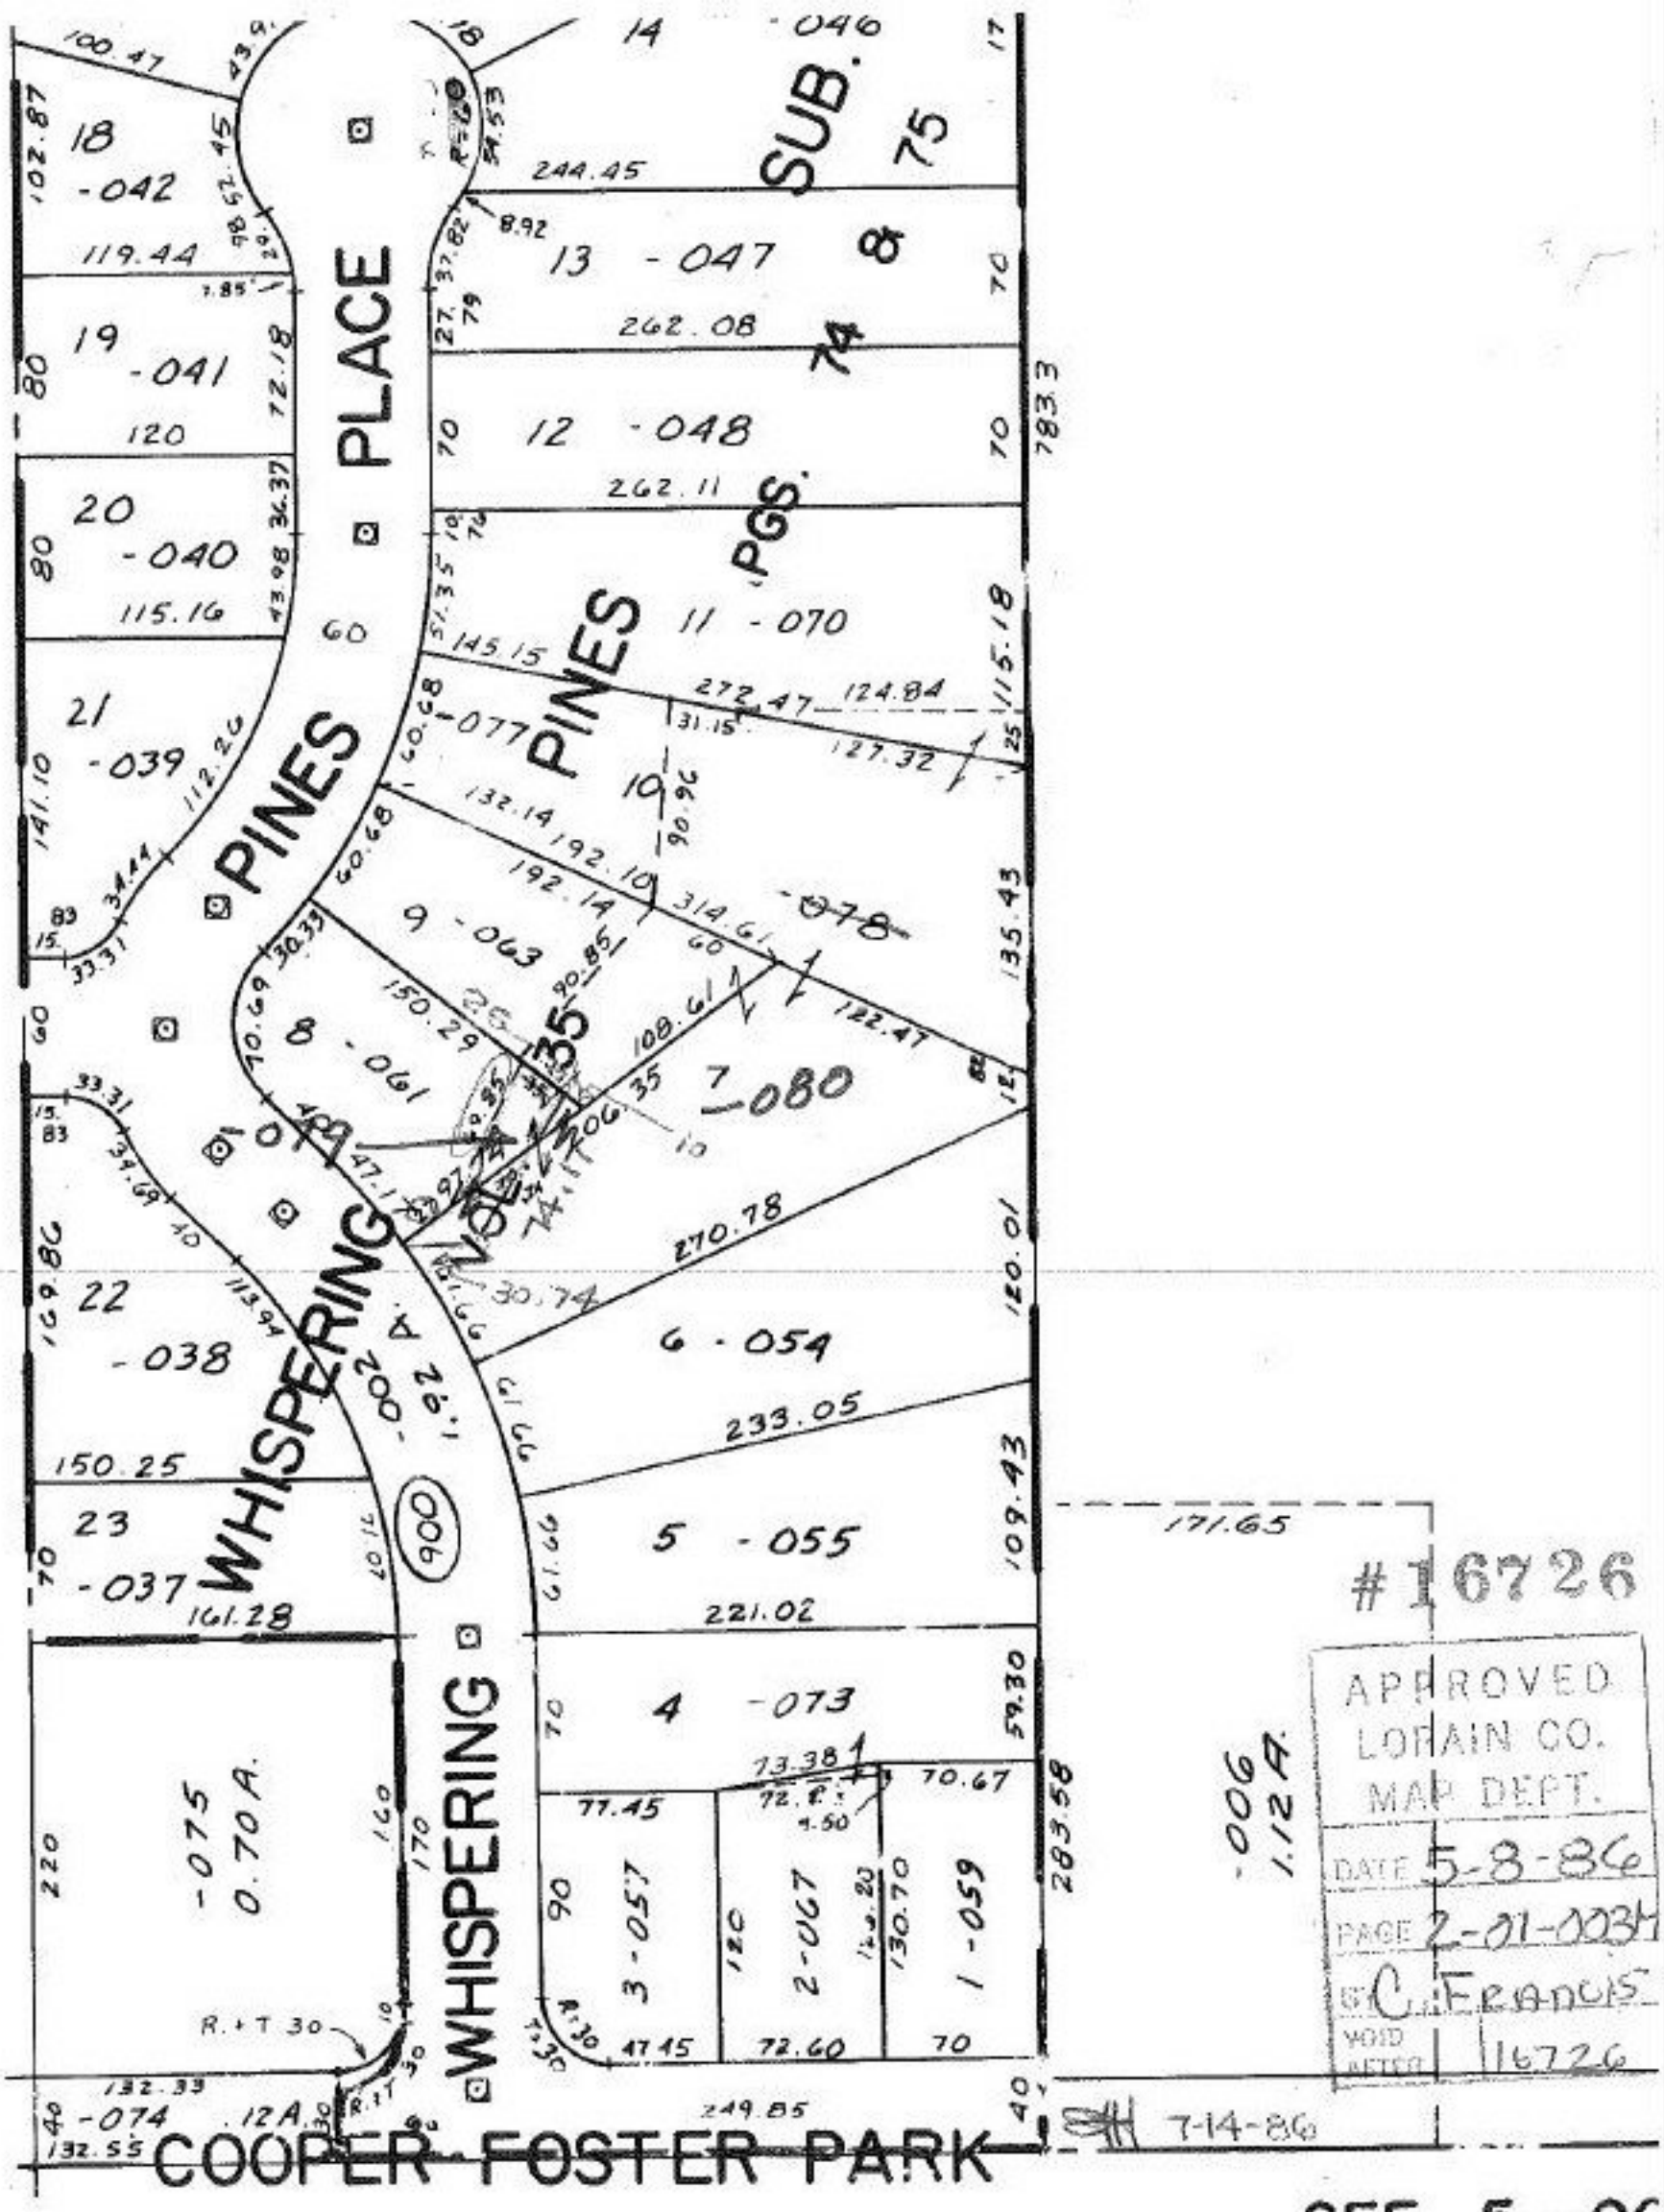

Prior Deed Ref. 1333/750
Deed Description By: Norman Hura & Assoc.
Deed C=1;38461.53846

BLA