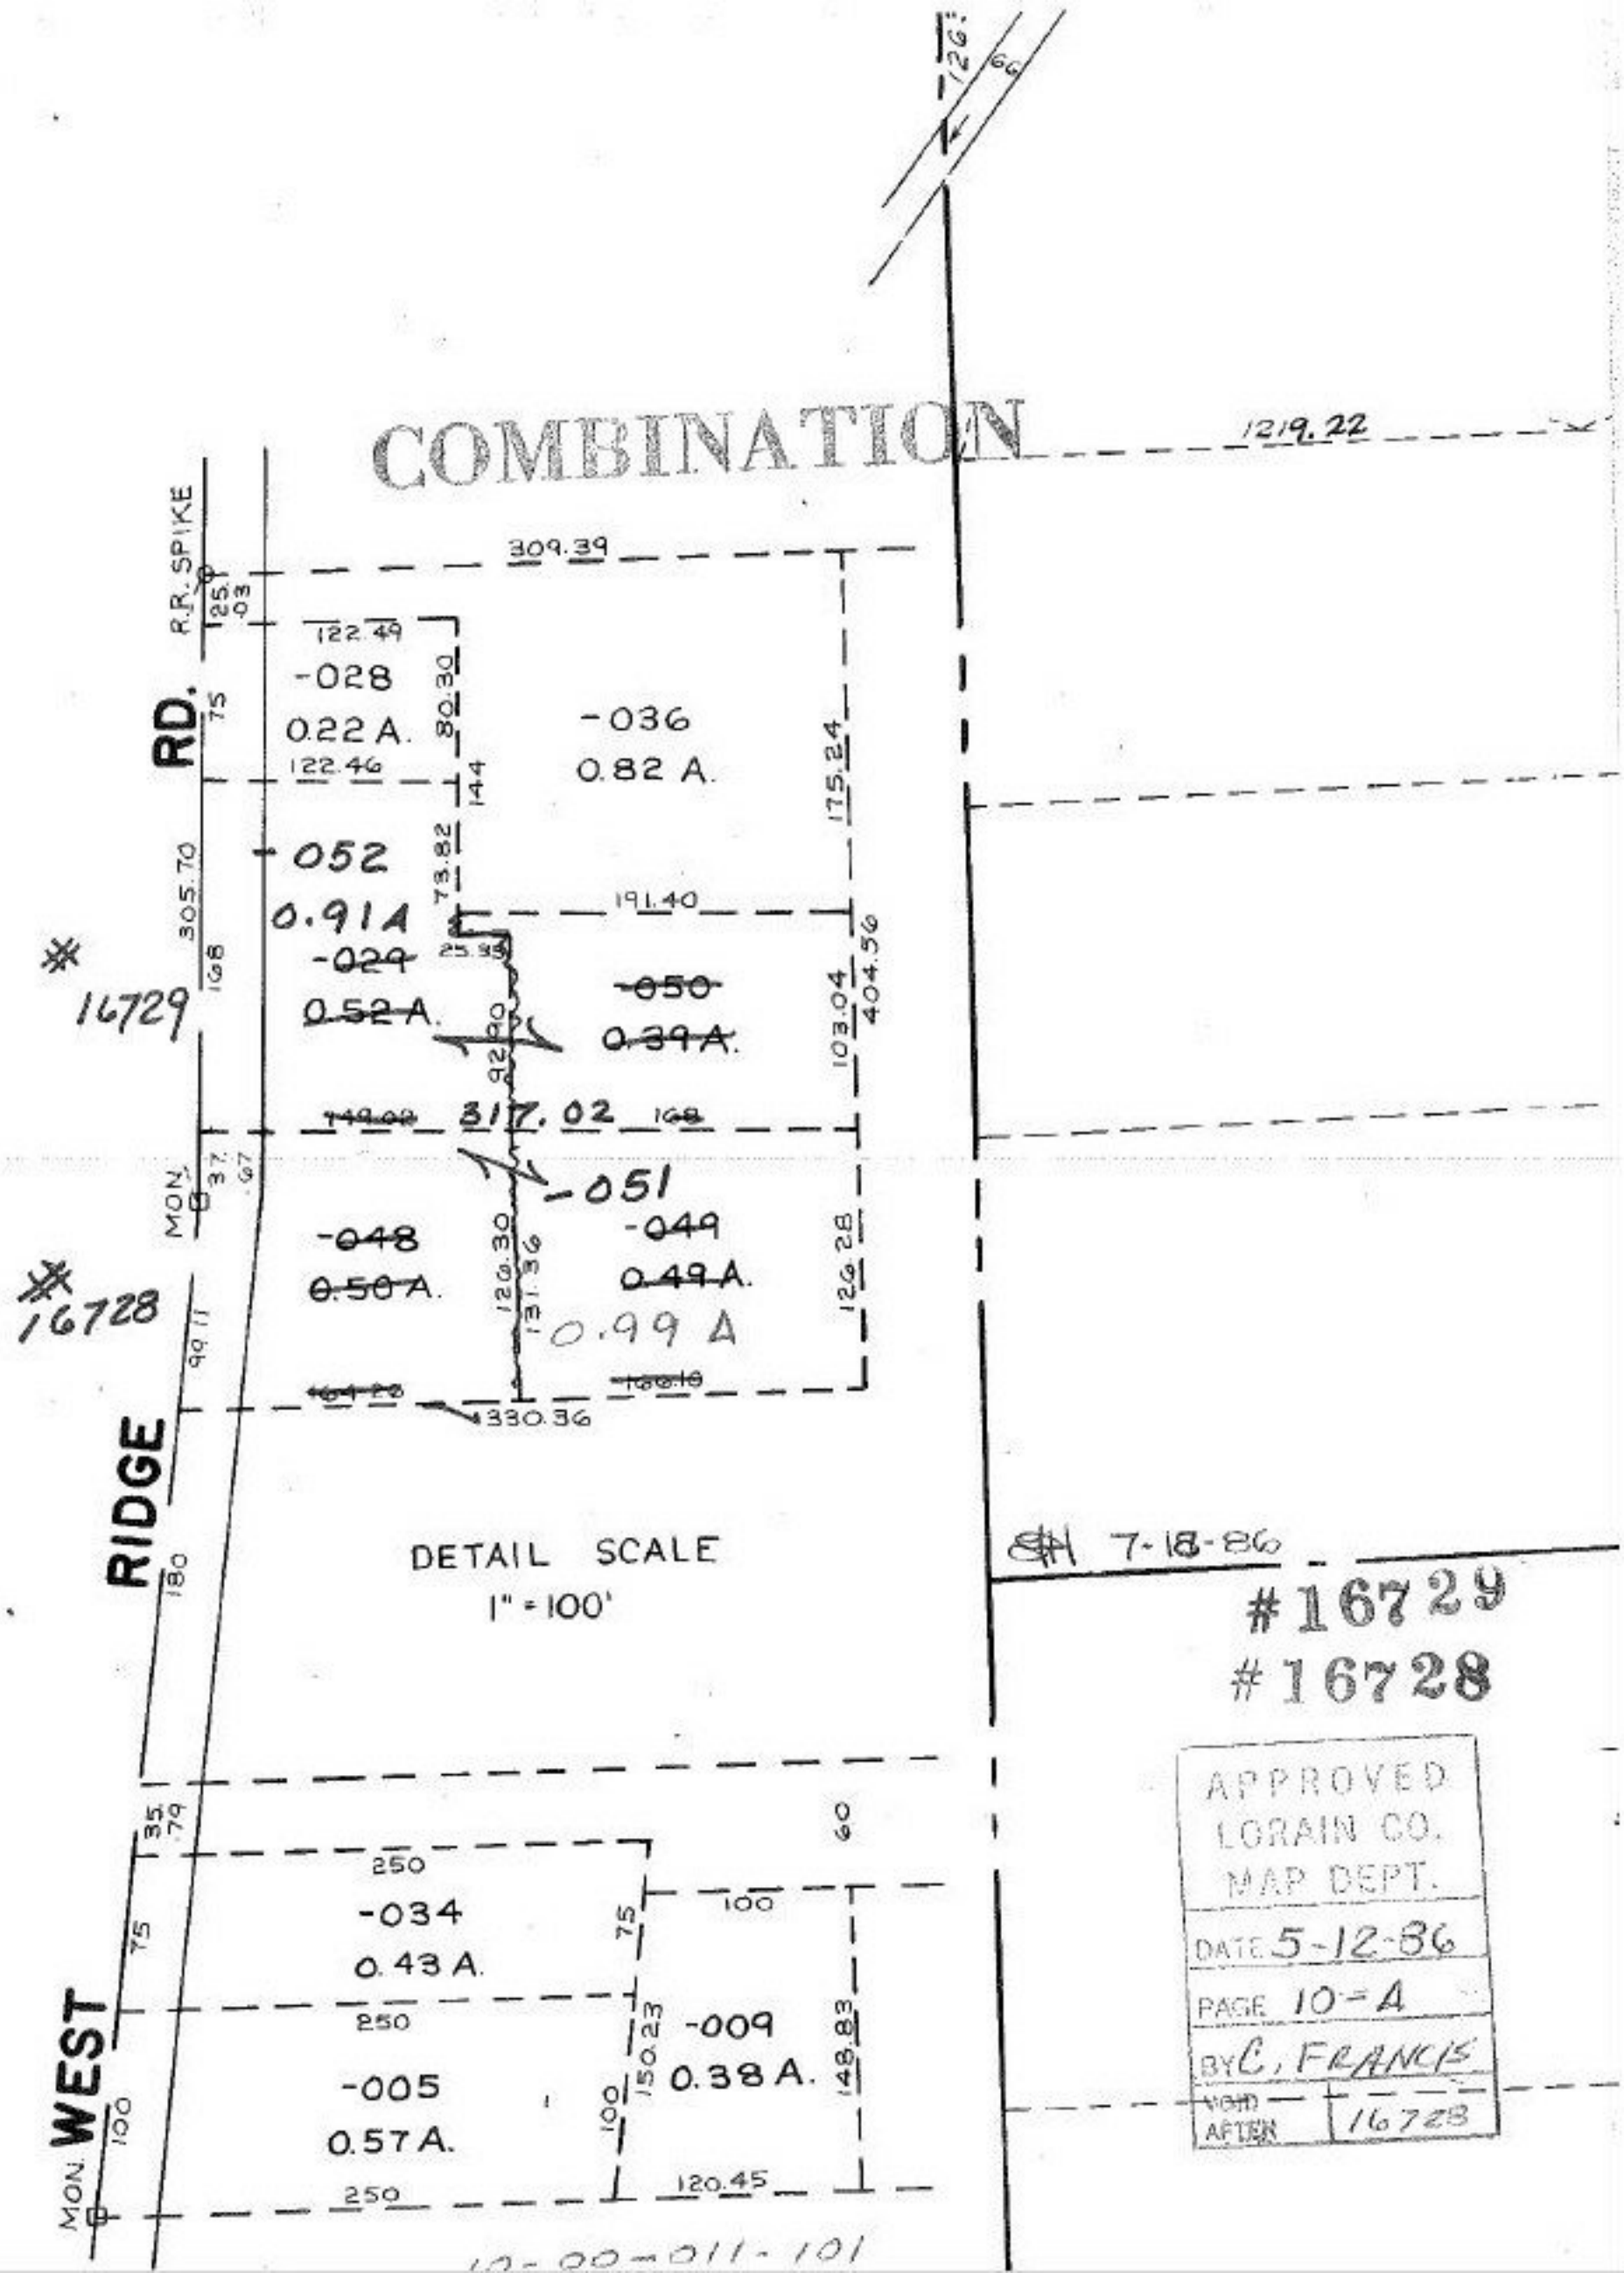
COMBINATION
1219.22
R.R. SPIKE
RD.
309.39
122.49
-028
0.22 A.
80.30
-036
0.82 A.
122.46
144
175.24
-052
0.91A
73.82
191.40
305.70
168
25.35
-029
0.52 A.
-050
0.39 A.
92.90
103.04
404.56
16729
317.02
168
-051
MON.
-048
0.50 A.
126.30
131.36
-049
0.49 A.
126.28
16728
0.99 A
99.11
330.36
RIDGE
DETAIL SCALE
1" = 100'
180
7-18-86
#16729
#16728
APPROVED
LORAIN CO.
MAP DEPT.
DATE 5-12-86
PAGE 10-A
BY C. FRANCIS
VOID AFTER 16728
35.79
250
-034
0.43 A.
75
100
60
250
-009
0.38 A.
150.23
148.83
-005
0.57 A.
100
WEST
MON.
250
120.45
10-00-011-101