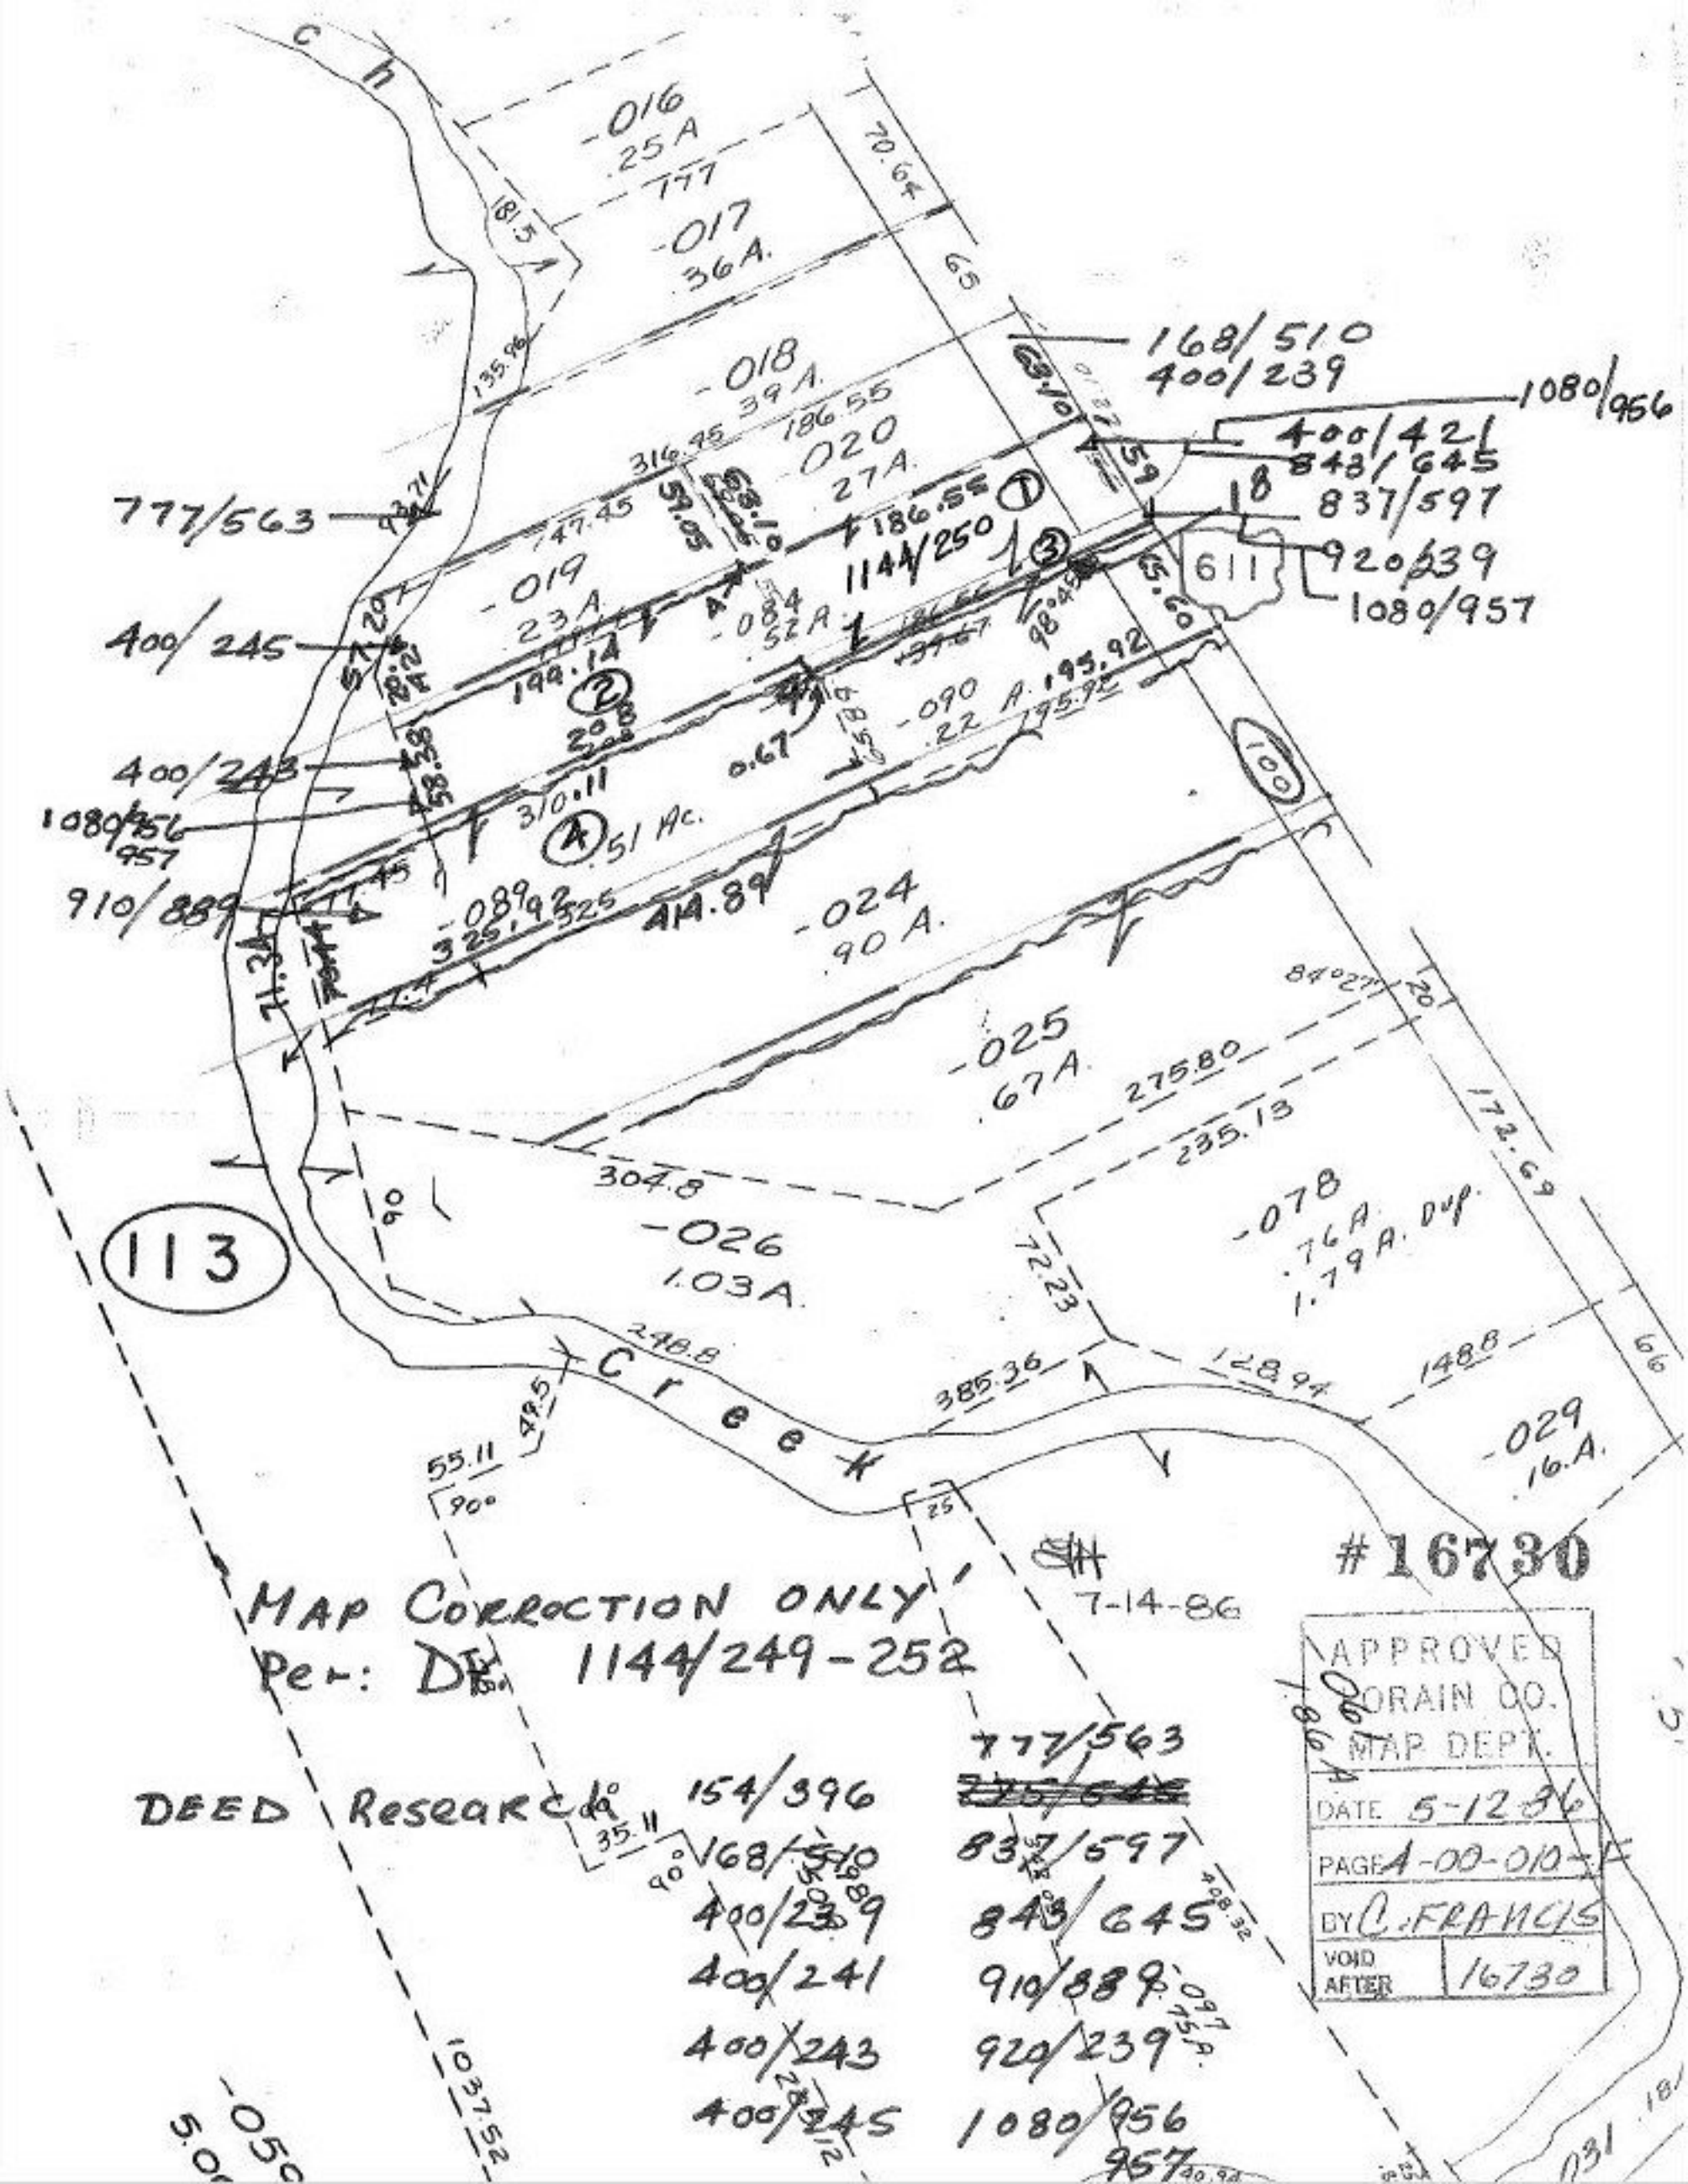

-016
.25 A
-017
.36 A.
-018
.39 A.
-020
.27 A.
-019
.23 A.
-084
.52 A.
-090
.22 A.
-024
.90 A.
-025
.67 A.
-026
1.03 A.
-078
.76 A.
1.79 A. Dup.
-029
.16 A.
168/510
400/239
1080/956
400/421
843/645
837/597
920/239
1080/957
777/563
400/245
400/243
1080/956
957
910/889
1144/250
611
113
Creek
#16730
7-14-86
MAP CORRECTION ONLY
Per: DF 1144/249-252
DEED Research
777/563
154/396
168/510
400/239
400/241
400/243
400/245
837/597
843/645
910/889
920/239
1080/956
957
APPROVED
LORAIN CO.
MAP DEPT.
DATE 5-12-86
PAGE 4-00-010-F
BY C. FRANCIS
VOID AFTER 16730