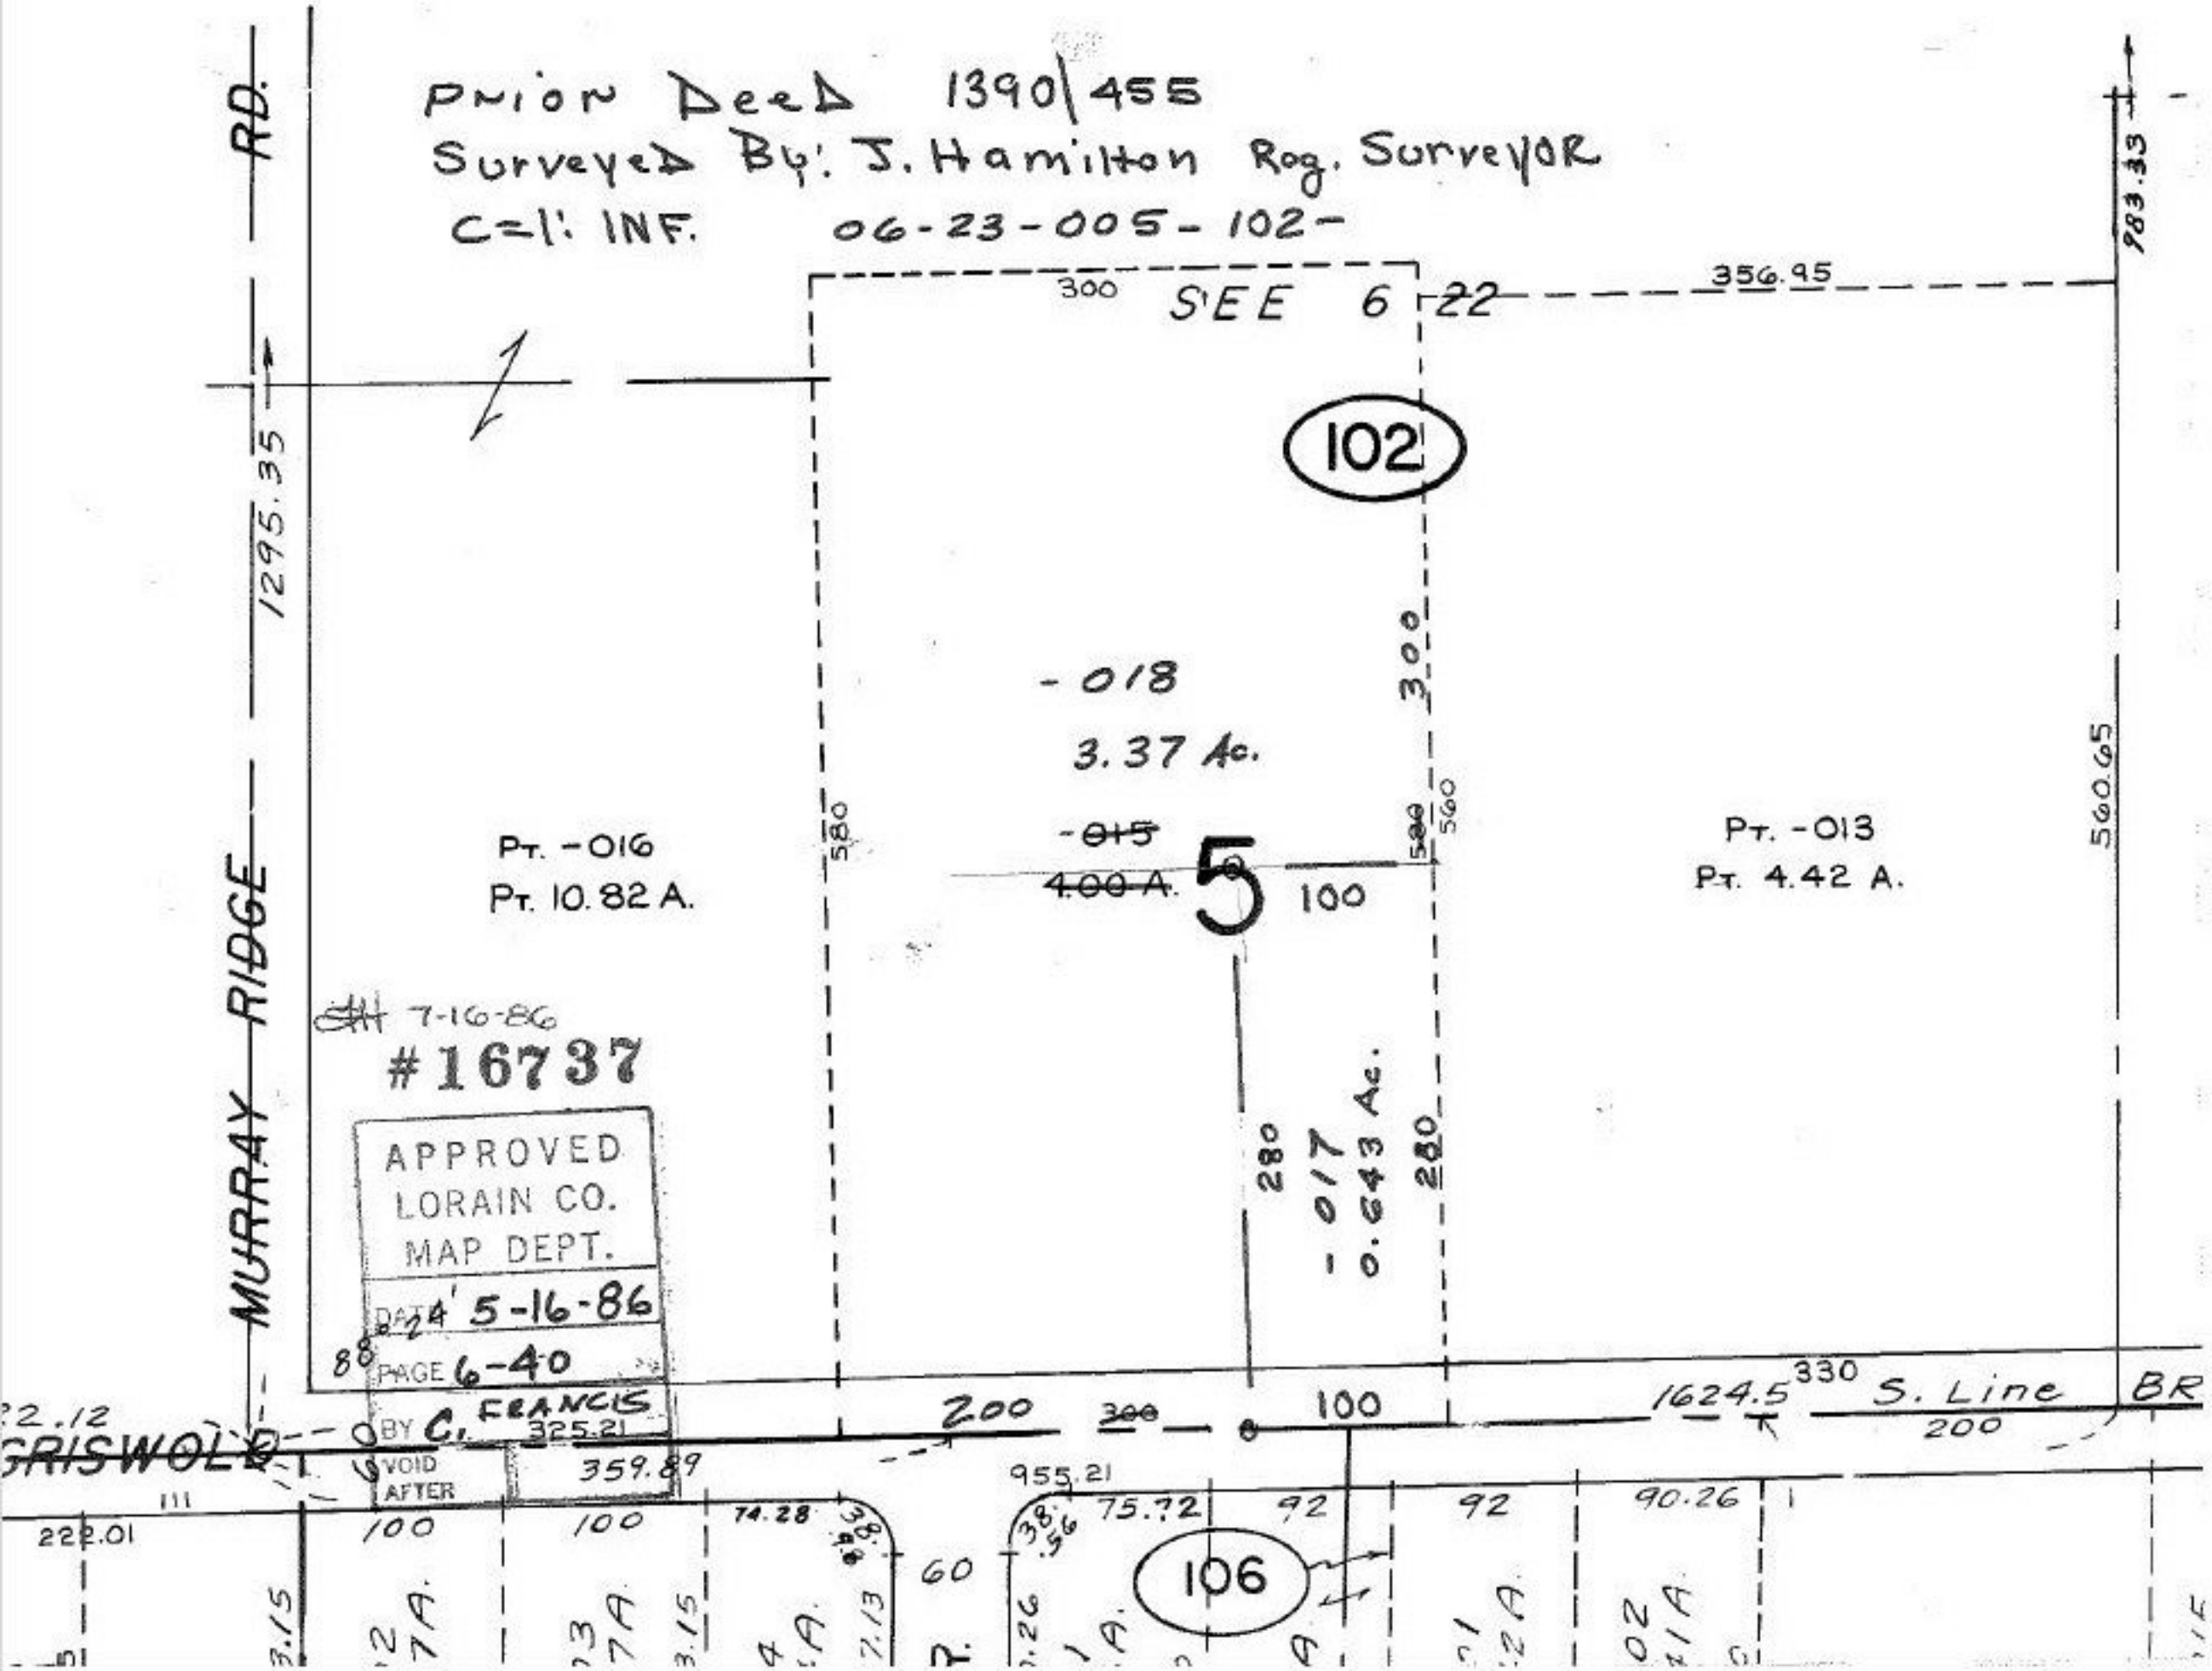

Prior Deed 1390\455
Surveyed By: J. Hamilton Reg. Surveyor
C=1: INF. 06-23-005-102-
RD.
MURRAY RIDGE
1295.35
983.33
300
SEE 6-22
356.95
102
300
-018
3.37 Ac.
580
-015
4.00 A.
5
100
560
560.65
Pt. -016
Pt. 10.82 A.
Pt. -013
Pt. 4.42 A.
7-16-86
#16737
APPROVED
LORAIN CO.
MAP DEPT.
DATE 5-16-86
PAGE 6-40
BY C. FRANCIS
VOID AFTER
280
-017
0.643 Ac.
280
GRISWOLD
325.21
359.89
200
300
100
1624.5
330
S. Line
BR
200
955.21
222.01
100
100
74.28
75.72
92
92
90.26
60
106