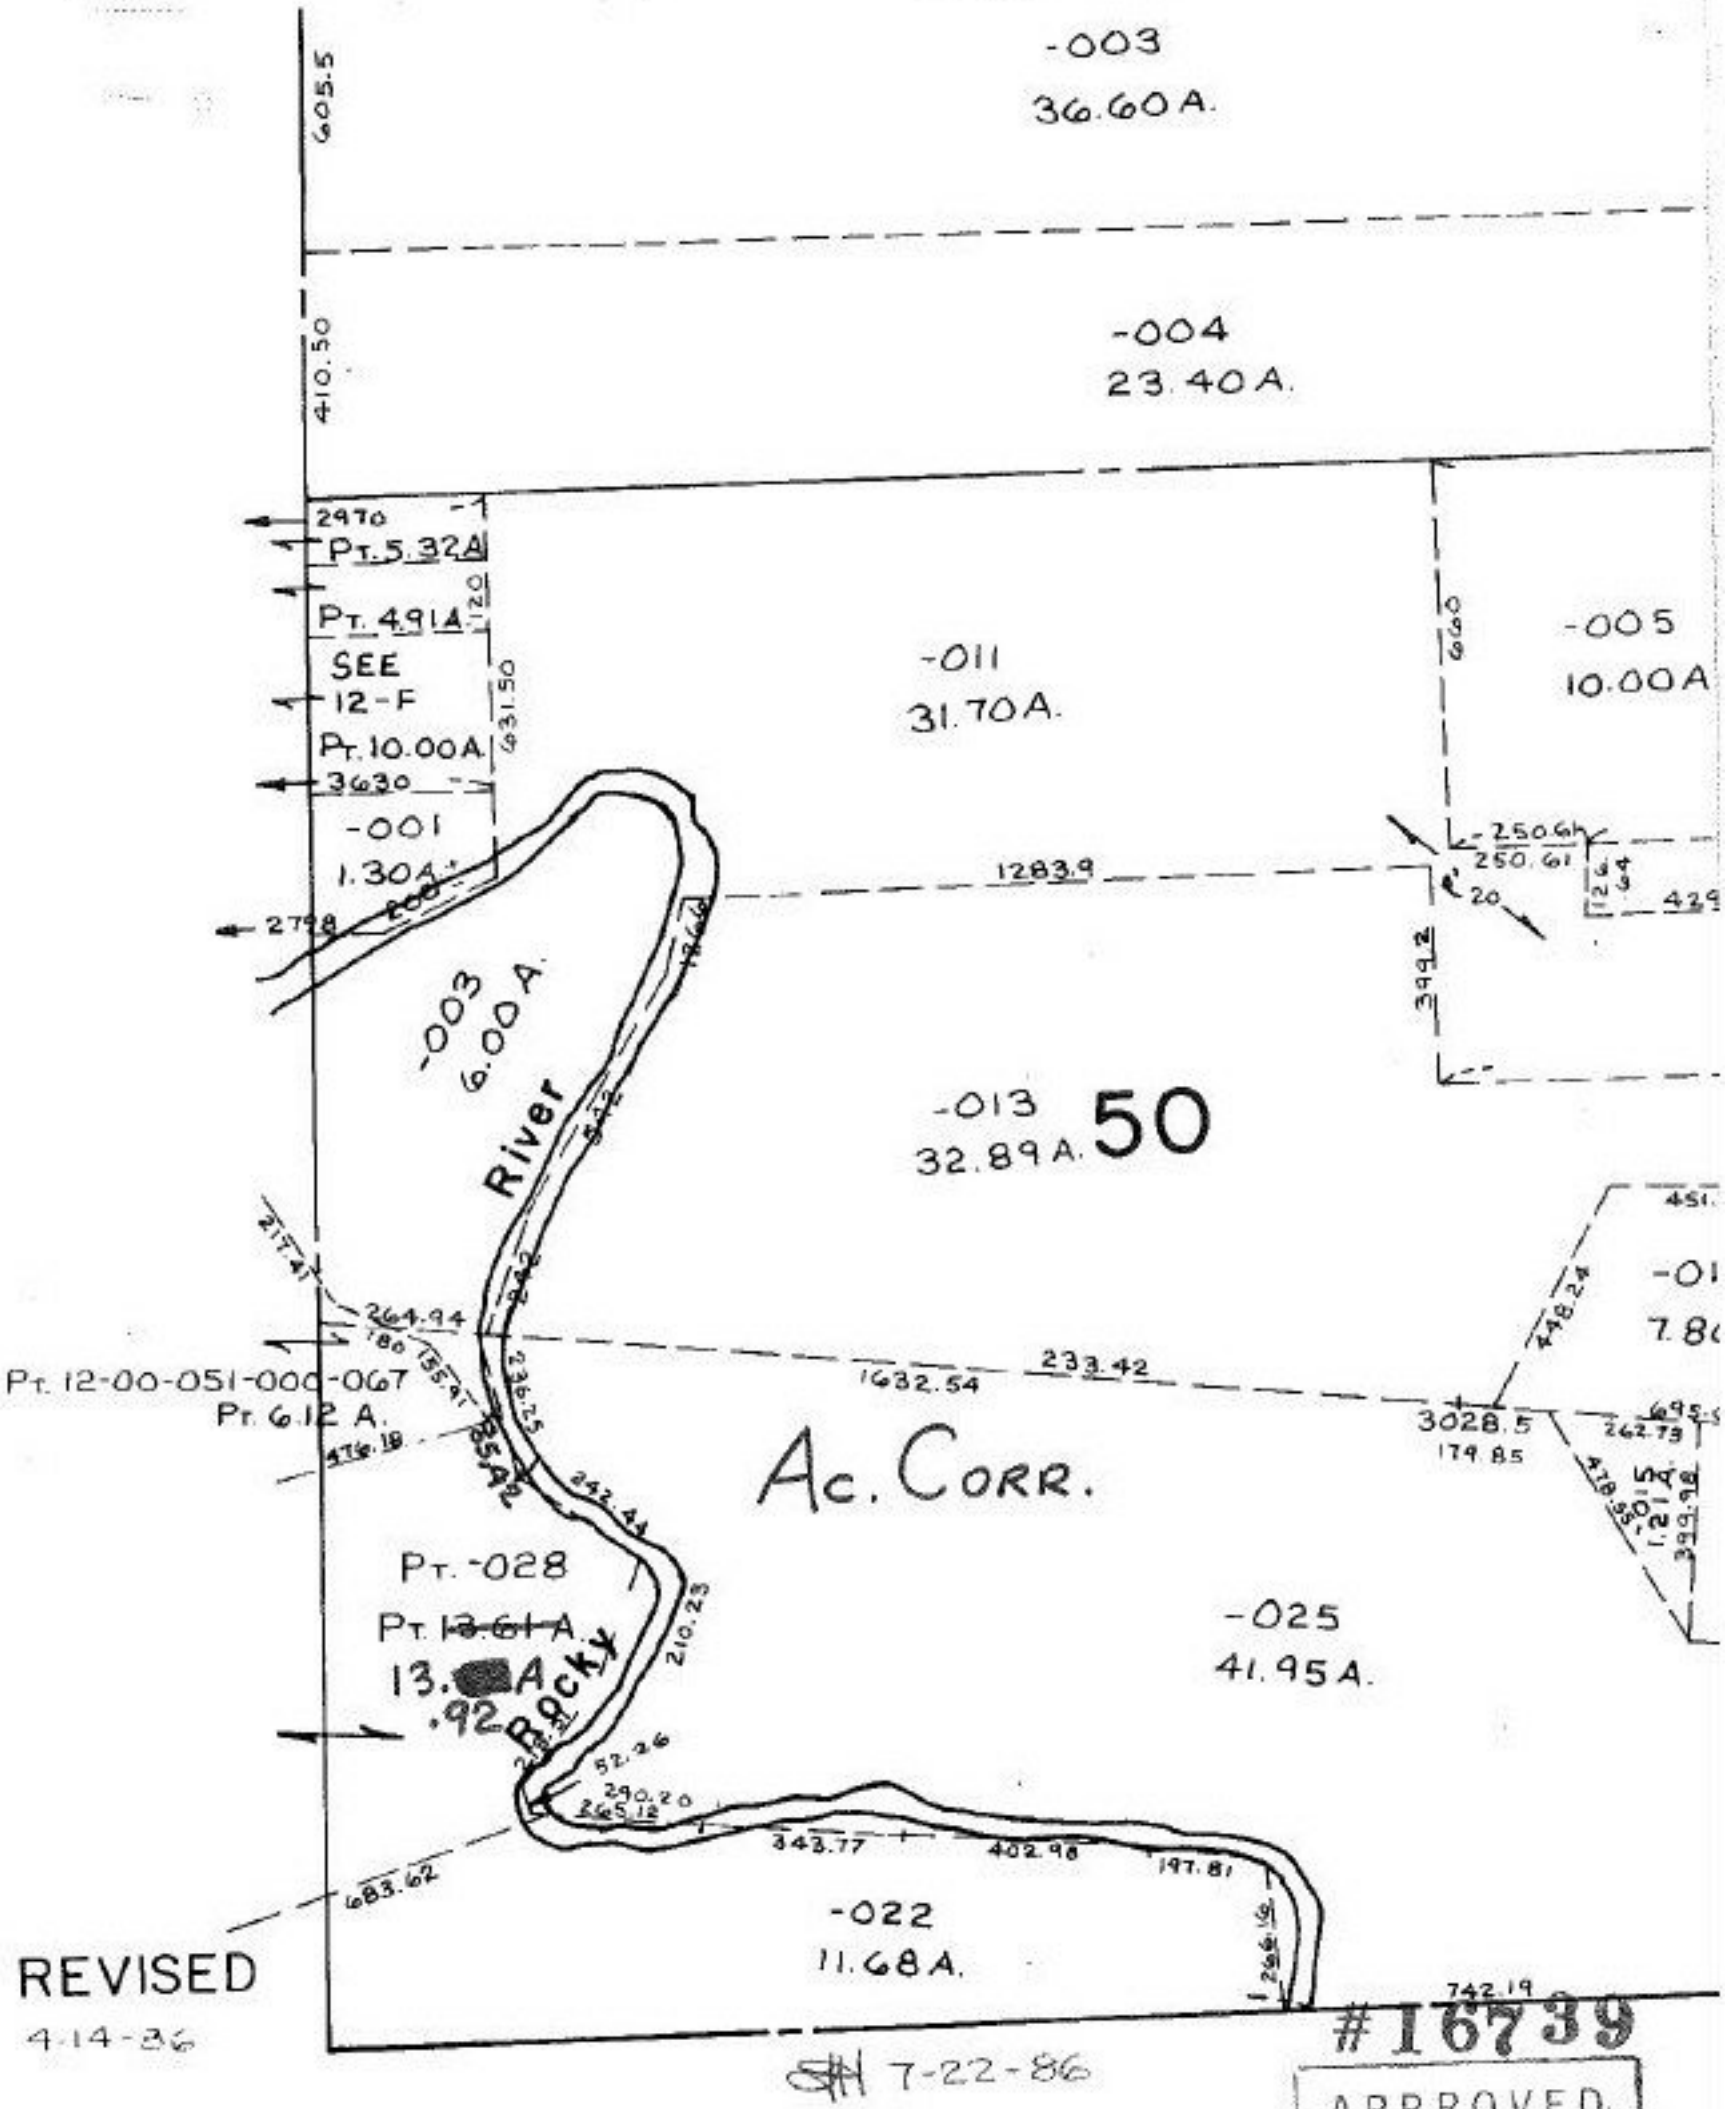

12-G

#16739
APPROVED
LORAIN CO.
MAP DEPT.
LOTS 26
DATE 5-16-86
PAGE 12-G
BY G. FRANCIS
VOID AFTER 16739