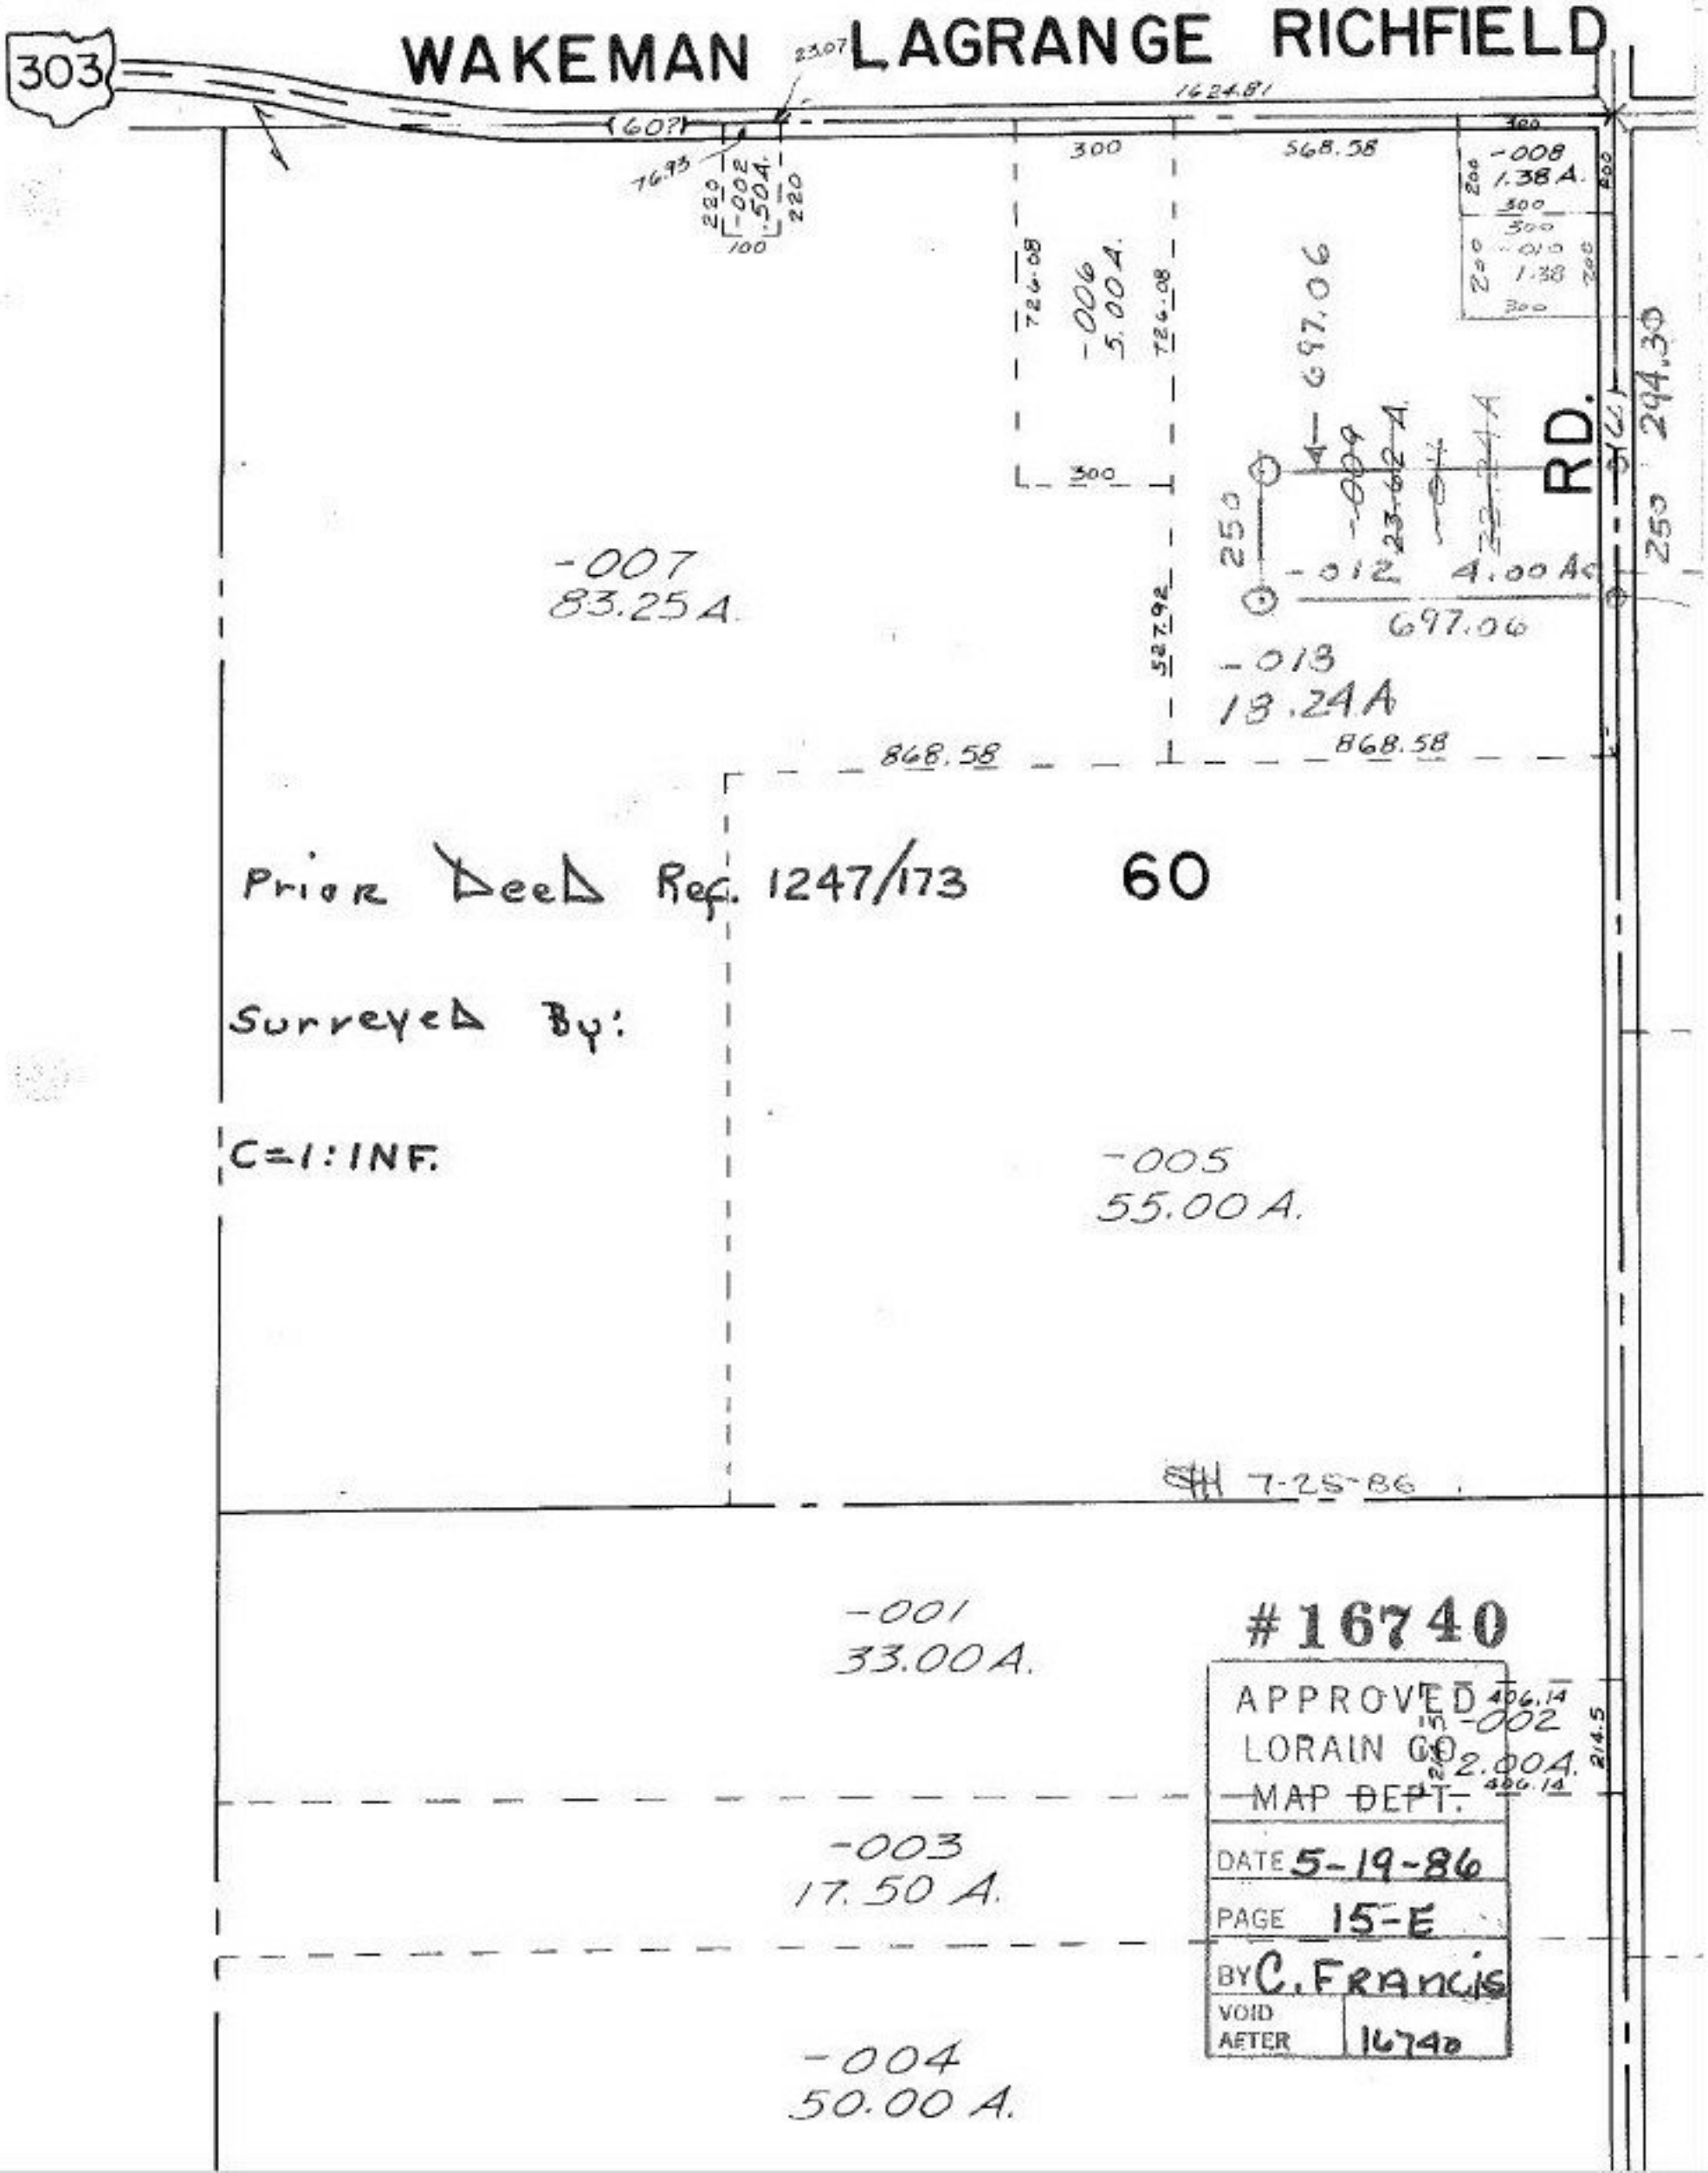
303
WAKEMAN LAGRANGE RICHFIELD
1624.81
23.07
(60?)
76.93
220
-002
.50A.
220
100
300
568.58
-008
1.38 A.
300
300
-010
1.38
300
726.08
-006
5.00 A.
726.08
697.06
RD.
294.30
250
-009
23.62 A
-012
4.00 Ac
697.06
-007
83.25 A.
527.92
-013
18.24 A
868.58
868.58
Prior Deed Ref. 1247/173
60
Surveyed By:
C=1:INF.
-005
55.00 A.
7-25-86
-001
33.00 A.
#16740
APPROVED
LORAIN CO.
MAP DEPT.
DATE 5-19-86
PAGE 15-E
BY C. FRANCIS
VOID AFTER 16740
406.14
-002
2.00 A.
406.14
214.5
-003
17.50 A.
-004
50.00 A.