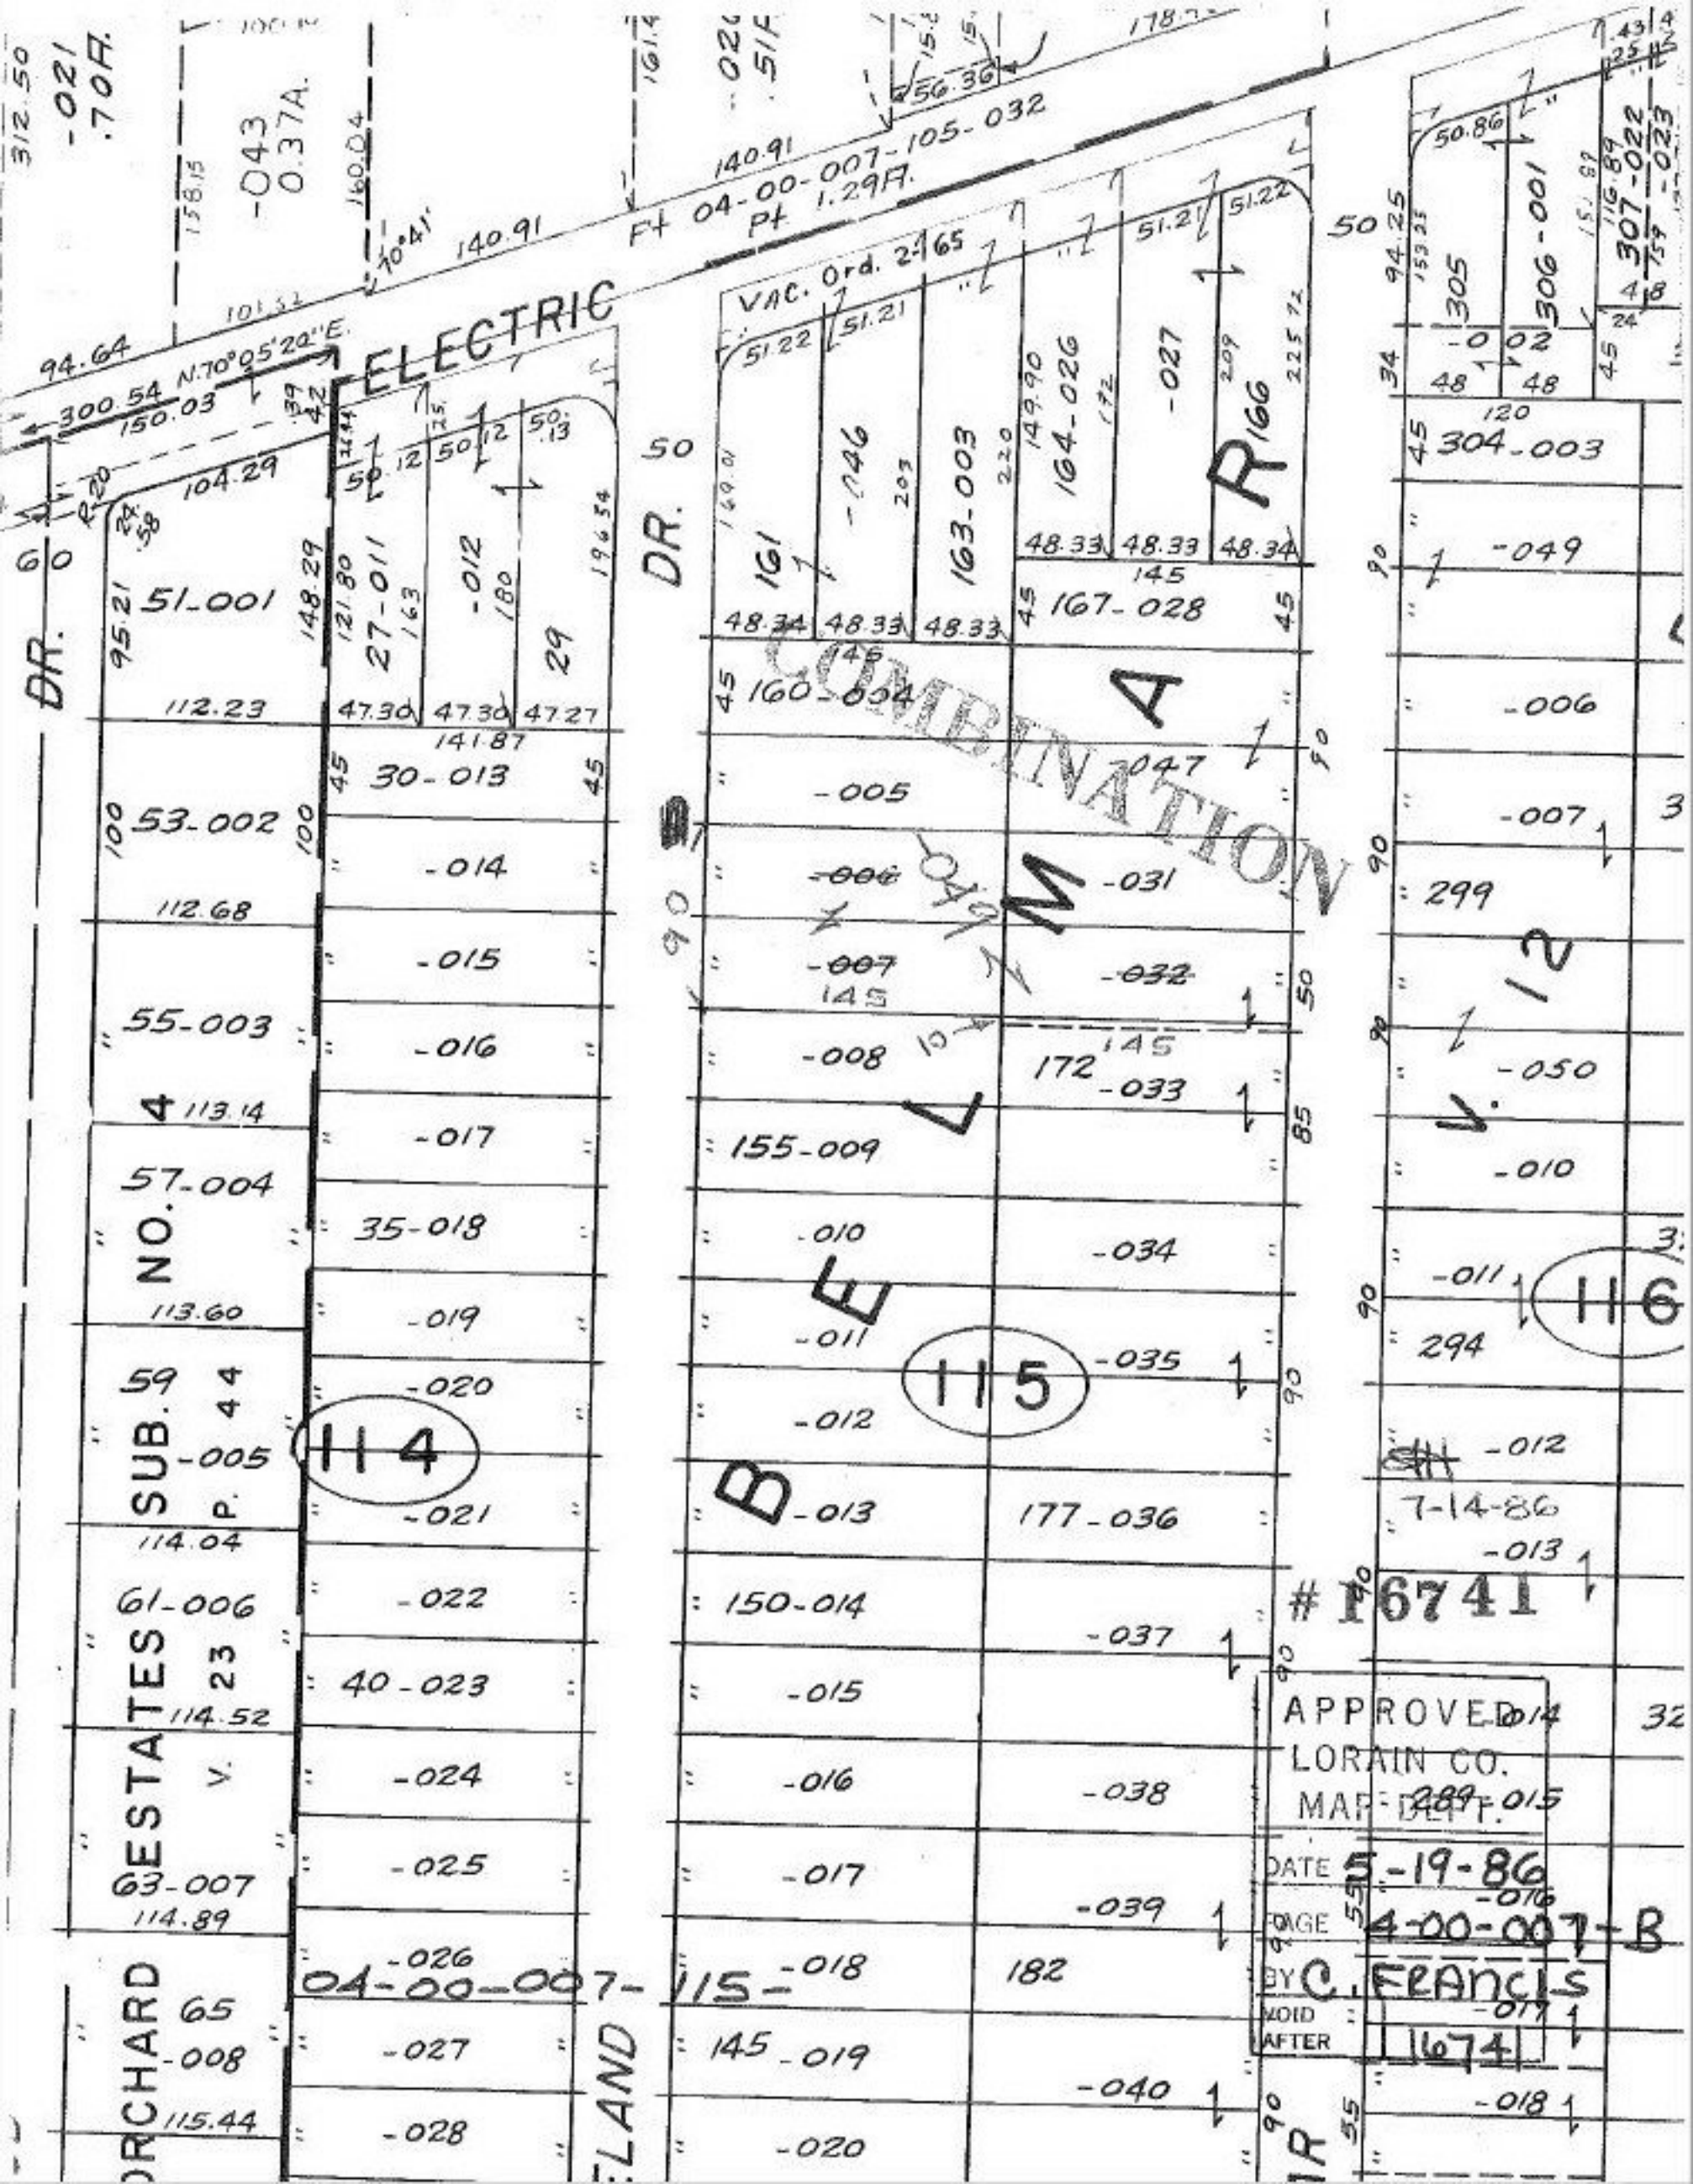

ELECTRIC
DR.
VAC. Ord. 2-65
Ft 04-00-007-105-032
Pt 1.29A.
COMBINATION
V. 12
SUB. NO. 4
ESTATES
ORCHARD
114
115
116
04-00-007-115-
16741
APPROVED
LORAIN CO.
MAP DEPT.
DATE 5-19-86
PAGE 4-00-007-B
BY C. FRANCIS
VOID AFTER 1674
7-14-86