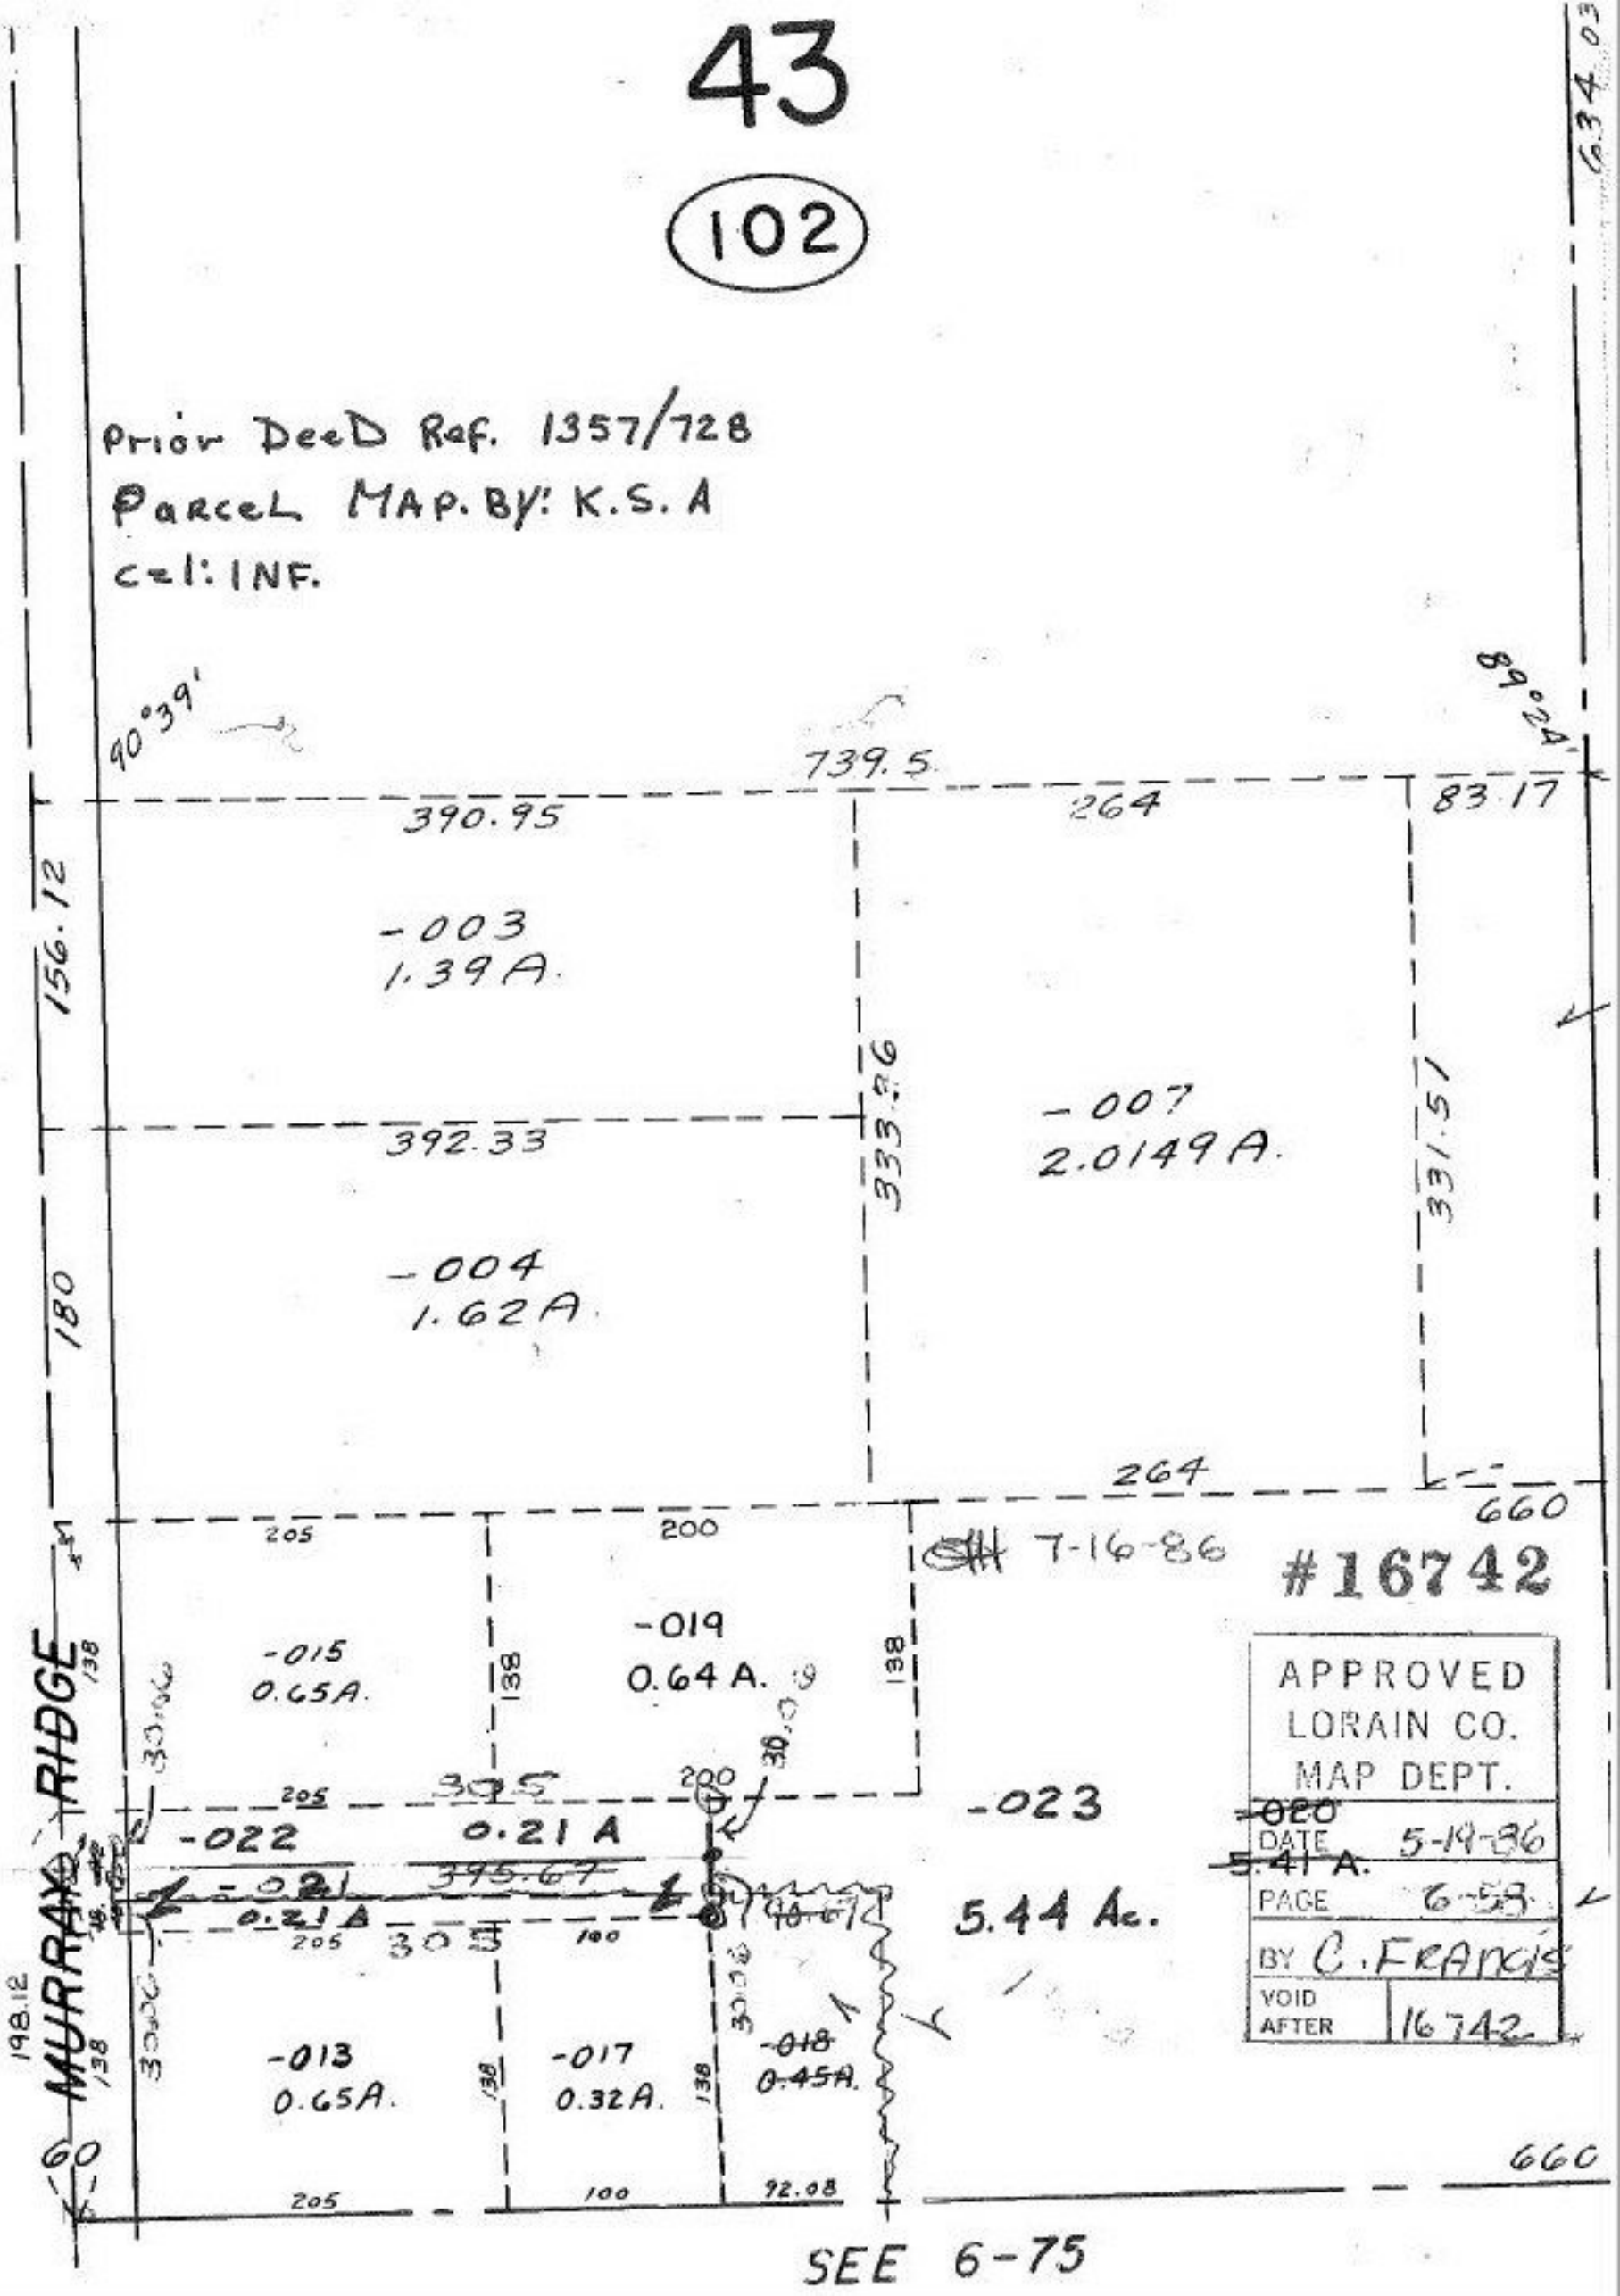
43
102
Prior Deed Ref. 1357/728
Parcel MAP. BY: K.S.A
cel: INF.
90°39'
89°24'
739.5
390.95
264
83.17
156.12
-003
1.39A.
392.33
333.36
-007
2.0149A.
331.51
180
-004
1.62A.
264
660
205
200
7-16-86
#16742
-015
0.65A.
-019
0.64 A.
138
138
138
30.06
30.06
205
305
200
-023
-022
0.21 A
-021
395.67
0.21 A
205
305
100
5.44 Ac.
MURRAY RIDGE
198.12
138
30.06
30.06
-013
0.65A.
-017
0.32A.
-018
0.45A.
138
138
138
60
205
100
92.08
660
APPROVED
LORAIN CO.
MAP DEPT.
DATE 5-19-86
PAGE 6-58
BY C. FRANCIS
VOID AFTER 16742
SEE 6-75