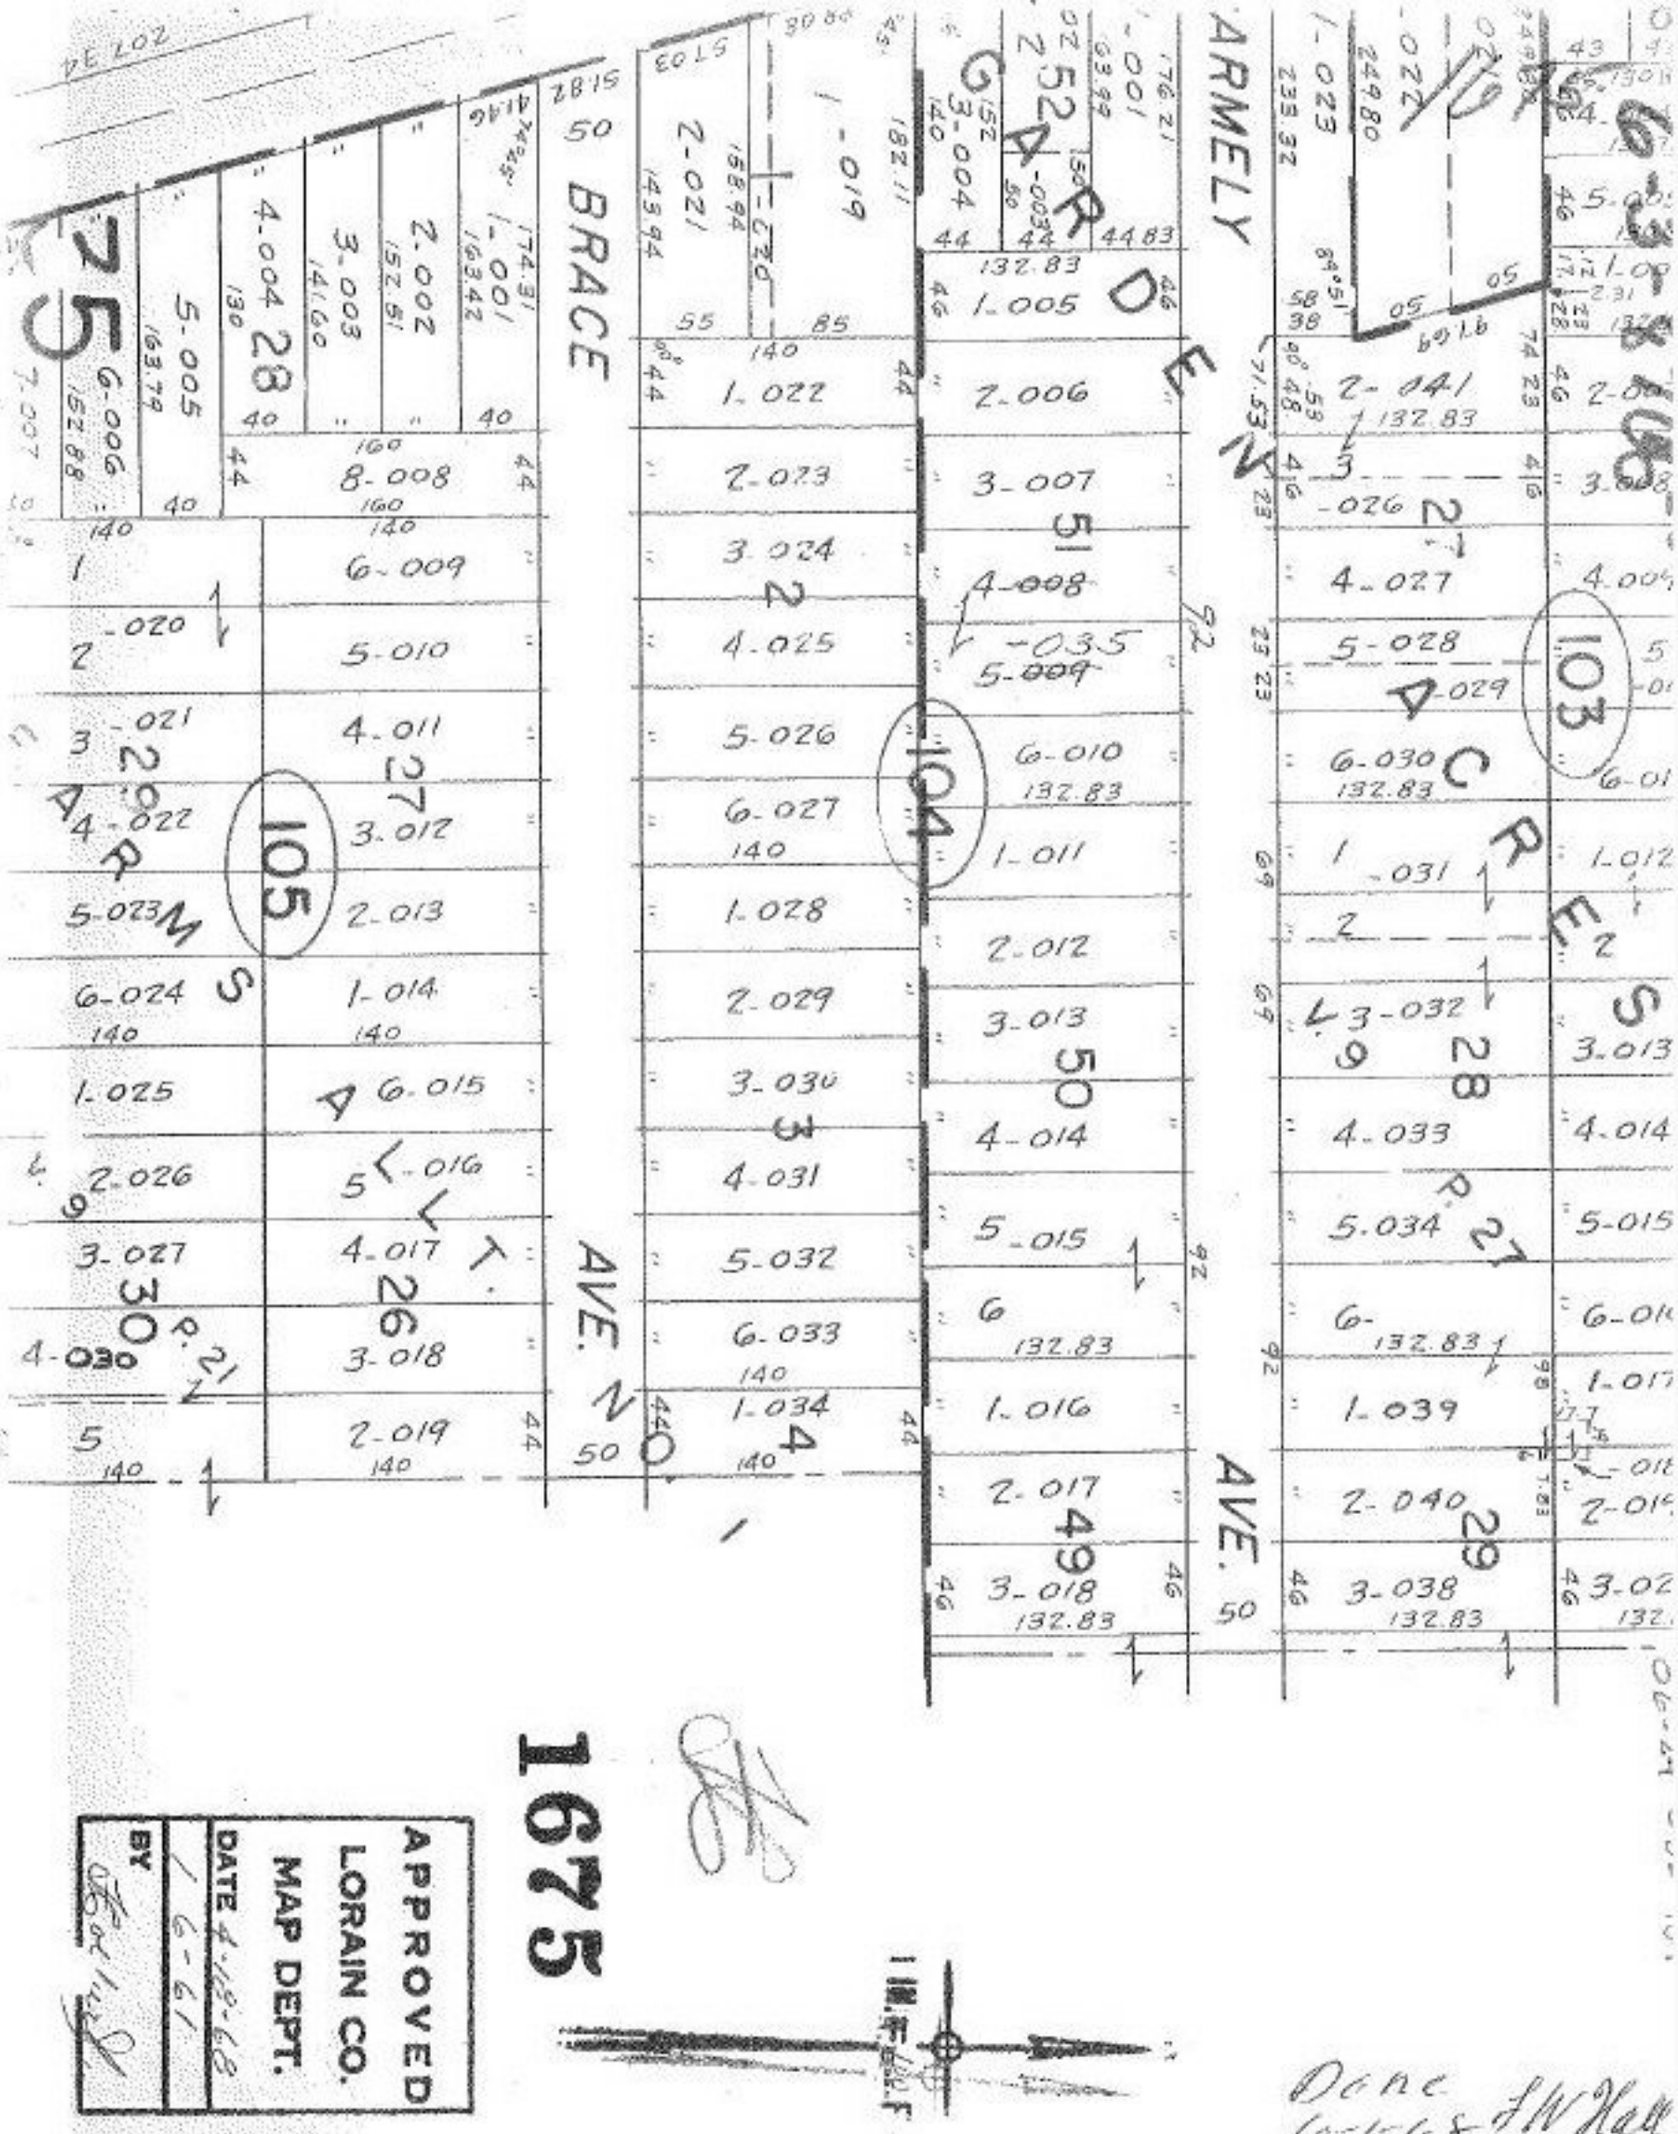
BRACE
AVE.
ARMELY
AVE.
105
104
103
APPROVED
LORAIN CO.
MAP DEPT.
DATE 4-19-62
1-6-61
BY
1675
Done
Co-Inc & J.W. Hall