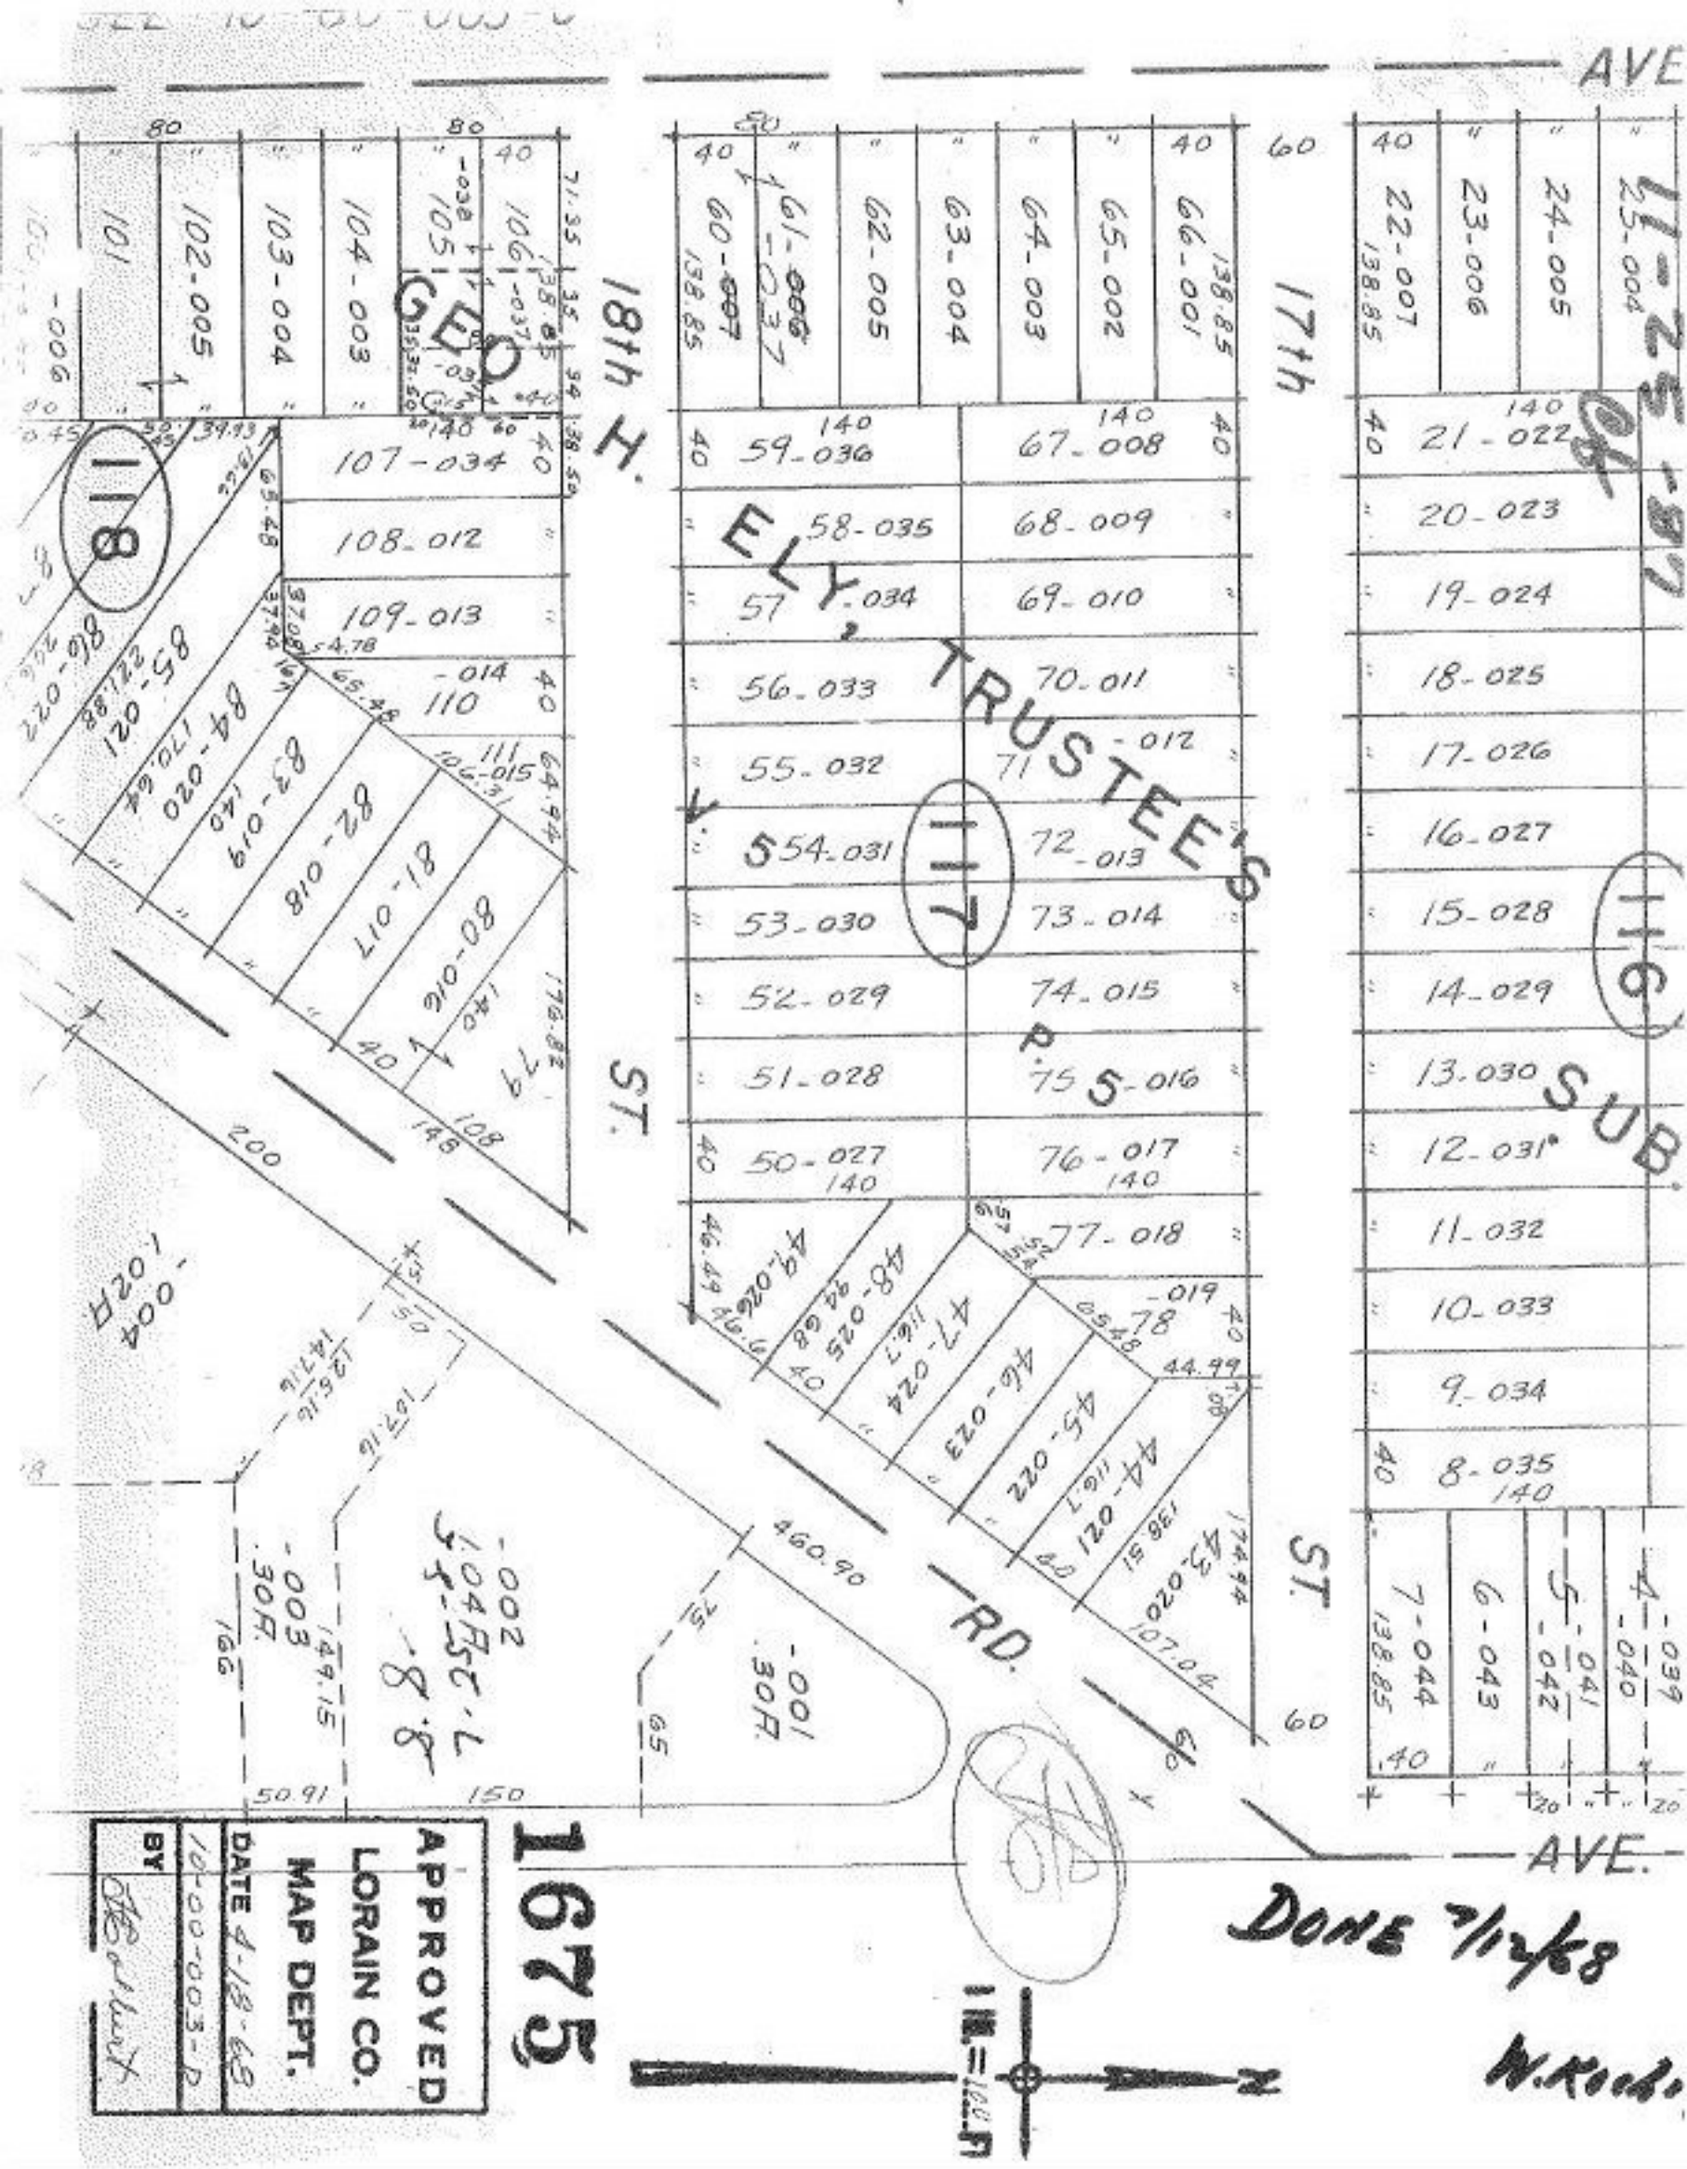

AVE
18th H. ST.
17th ST.
GEO. ELY, TRUSTEE'S SUB.
RD.
AVE.
118
117
116
1675
APPROVED
LORAIN CO.
MAP DEPT.
DATE 4-18-68
10-00-003-D
BY
DONE 7/12/68
W. Koch