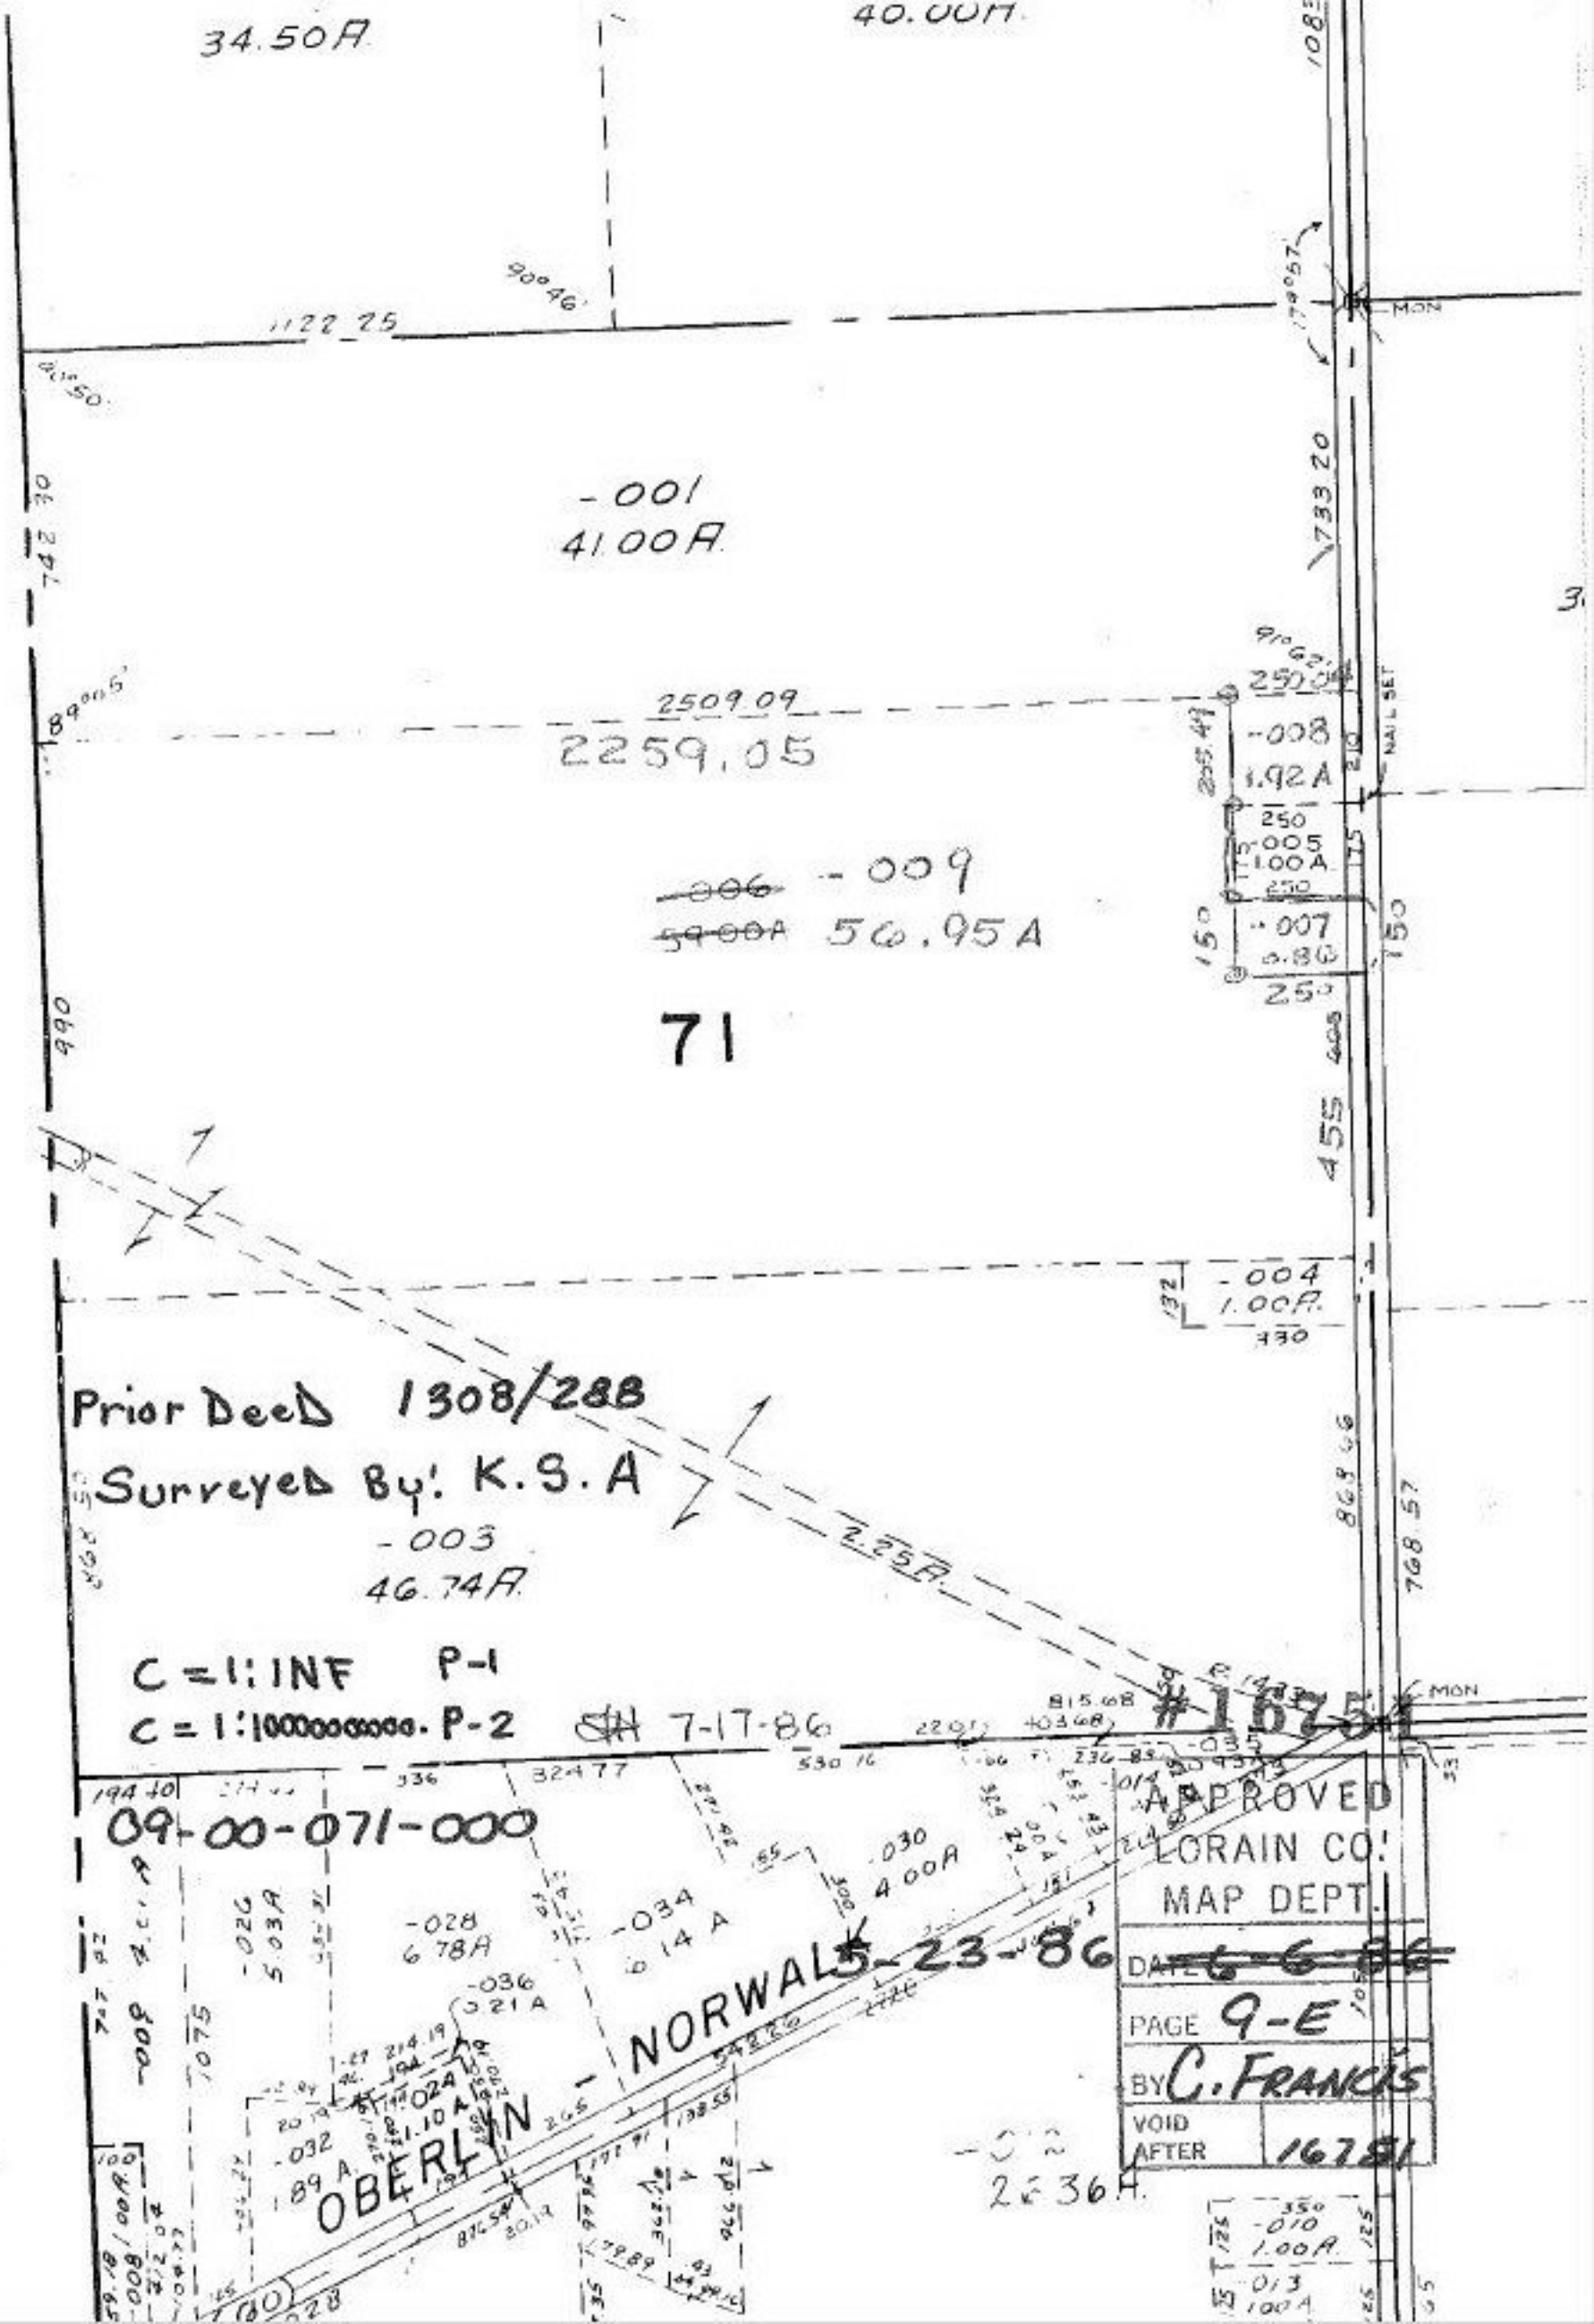
34.50A
40.00A
1122.25
-001
41.00A
2509.09
2259.05
-008
1.92A
-005
1.00A
-007
0.86
-009
56.95A
71
-004
1.00A
Prior Deed 1308/288
Surveyed By: K.S.A
-003
46.74A
C=1:INF P-1
C=1:1000000000. P-2
7-17-86
#16751
09-00-071-000
-028
6.78A
-034
6.14A
-030
4.00A
5-23-86
OBERLIN - NORWALK
APPROVED
LORAIN CO.
MAP DEPT.
DATE 6-6-86
PAGE 9-E
BY C. FRANCIS
VOID AFTER 16751
-010
1.00A
-013
1.00A
2.36A
MON
NAIL SET