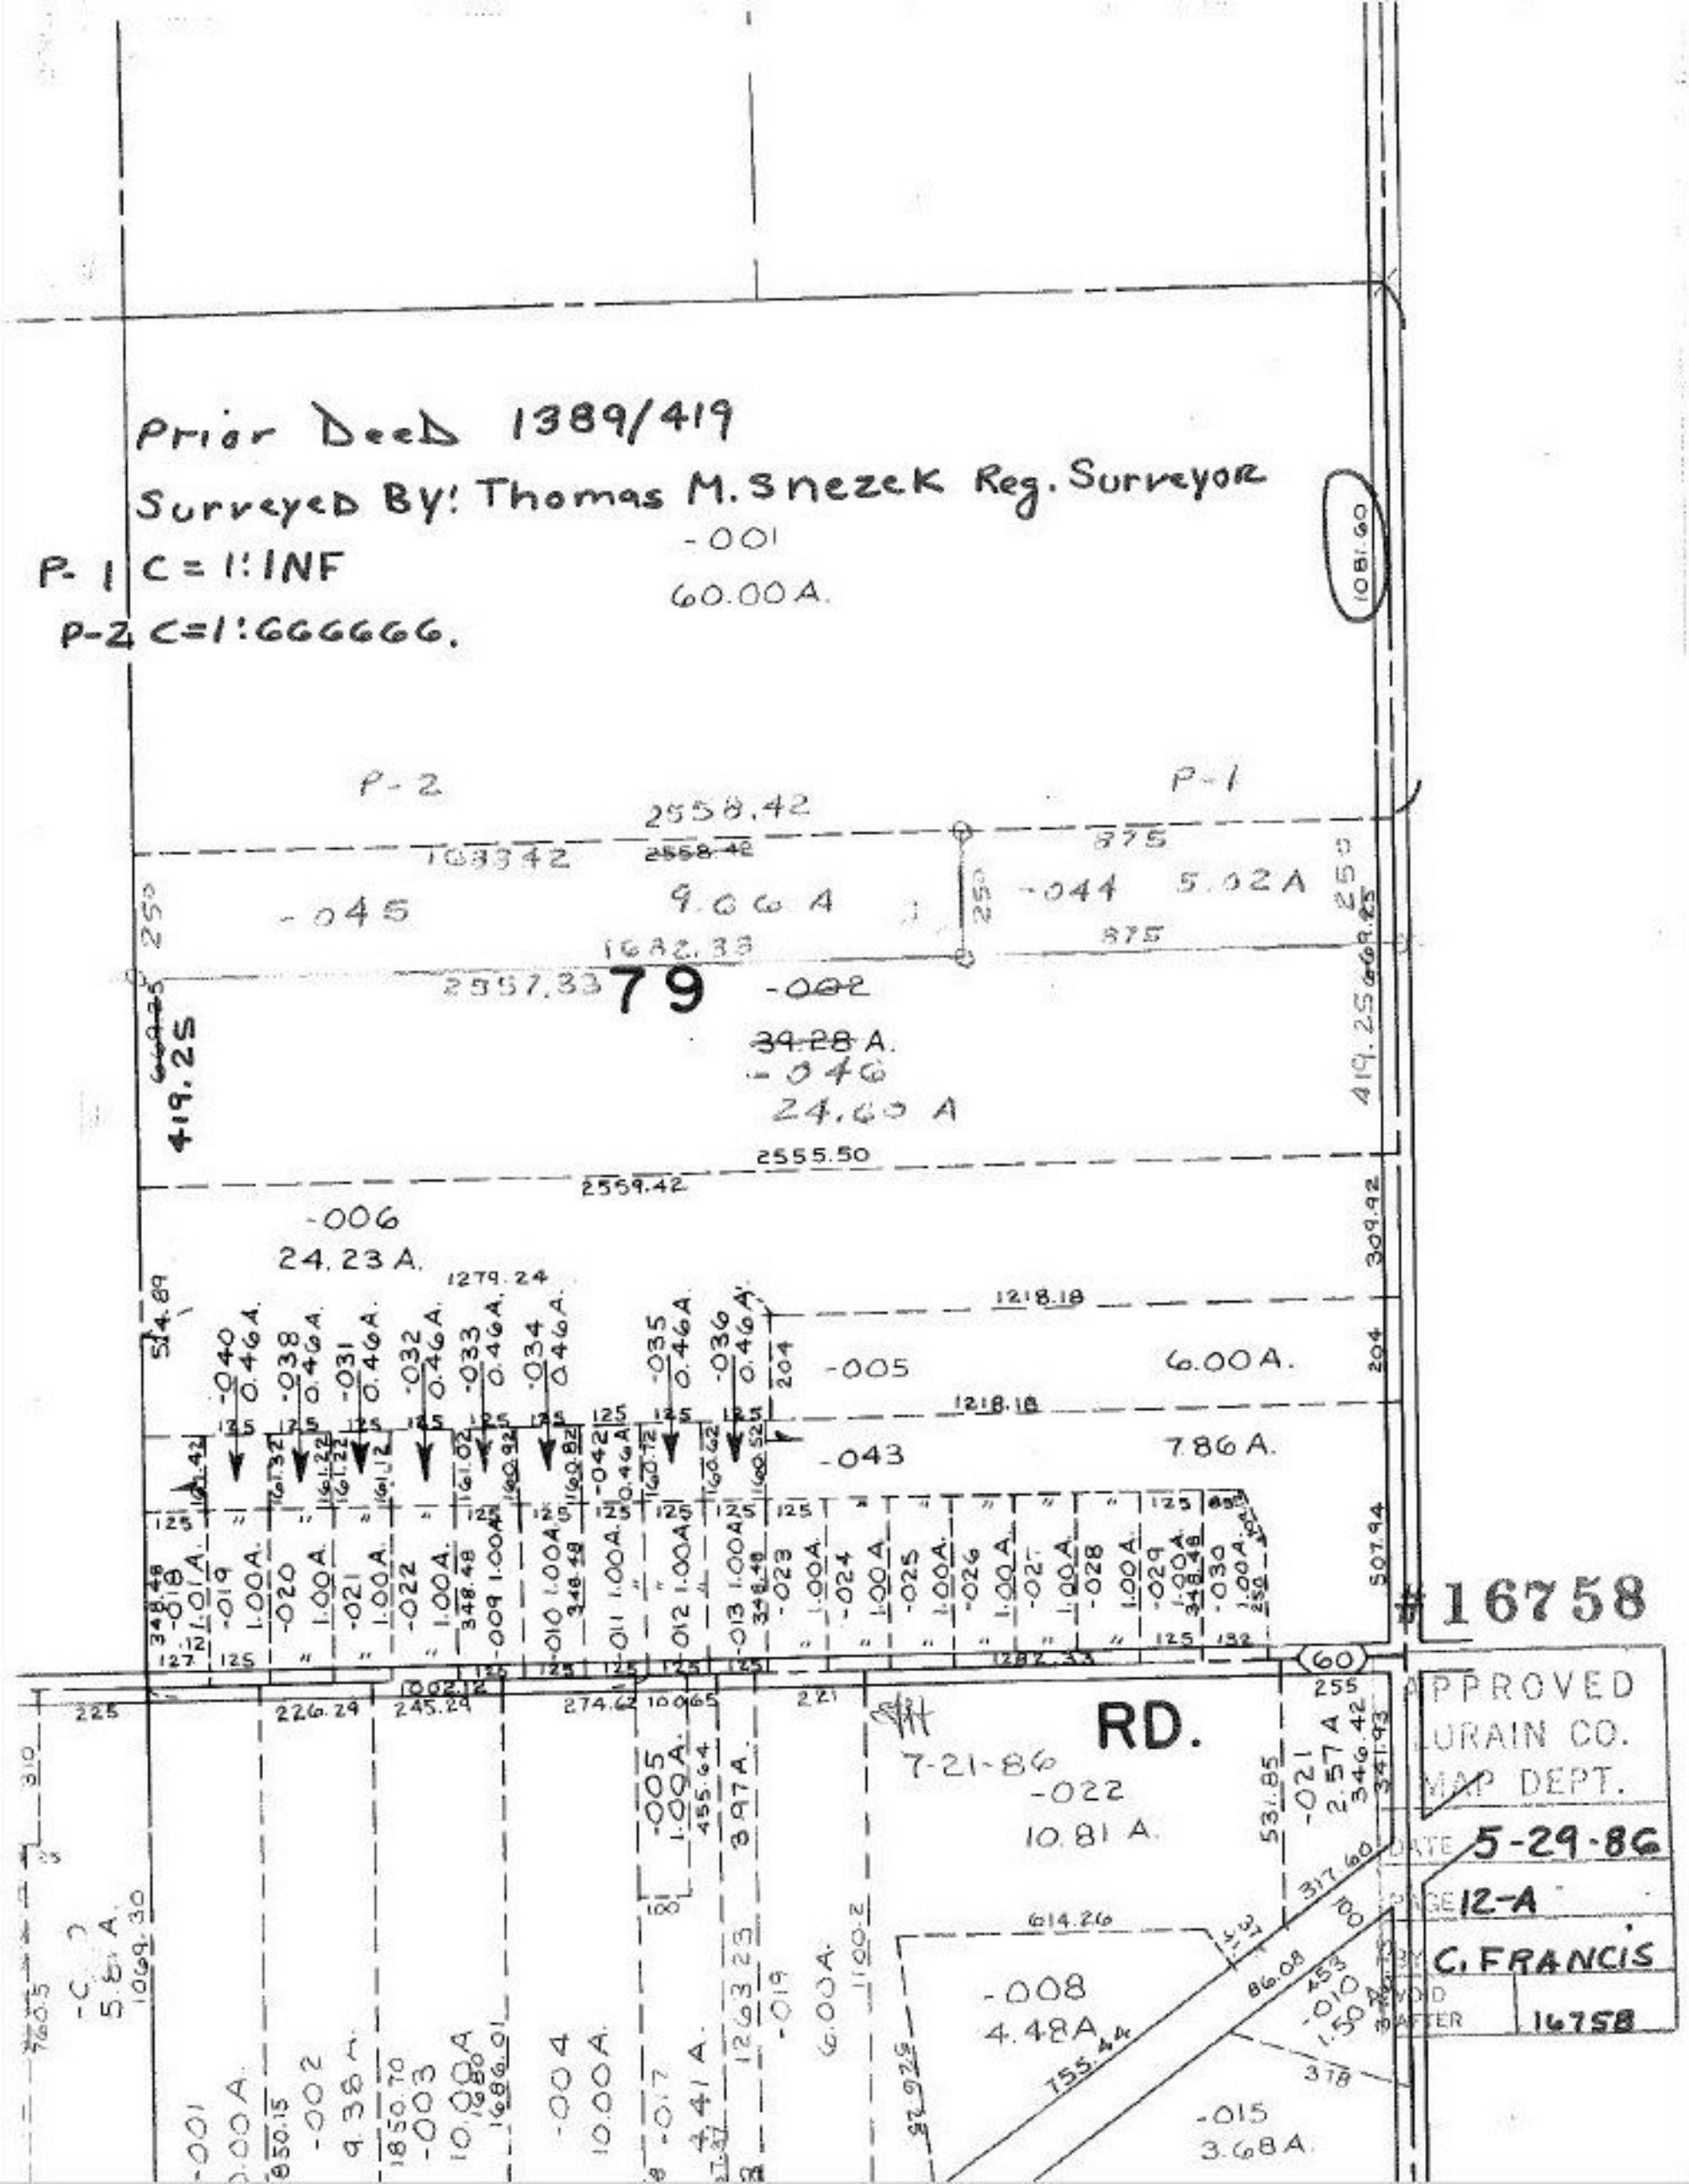
Prior Deed 1389/419
Surveyed By: Thomas M. Snezek Reg. Surveyor
P-1 C=1:INF
P-2 C=1:666666.
-001
60.00A.
1081.60
P-2
P-1
2558.42
1633.42
875
-045
9.66 A
-044
5.02A
1682.33
2557.33
79
-002
39.28 A.
-046
24.60 A
419.25
2555.50
2559.42
-006
24.23 A.
1279.24
1218.18
-005
6.00A.
-043
7.86 A.
#16758
RD.
7-21-86
-022
10.81 A.
-008
4.48A
-015
3.68A.
APPROVED
LURAIN CO.
MAP DEPT.
DATE 5-29-86
PAGE 12-A
BY C. FRANCIS
VOID AFTER 16758