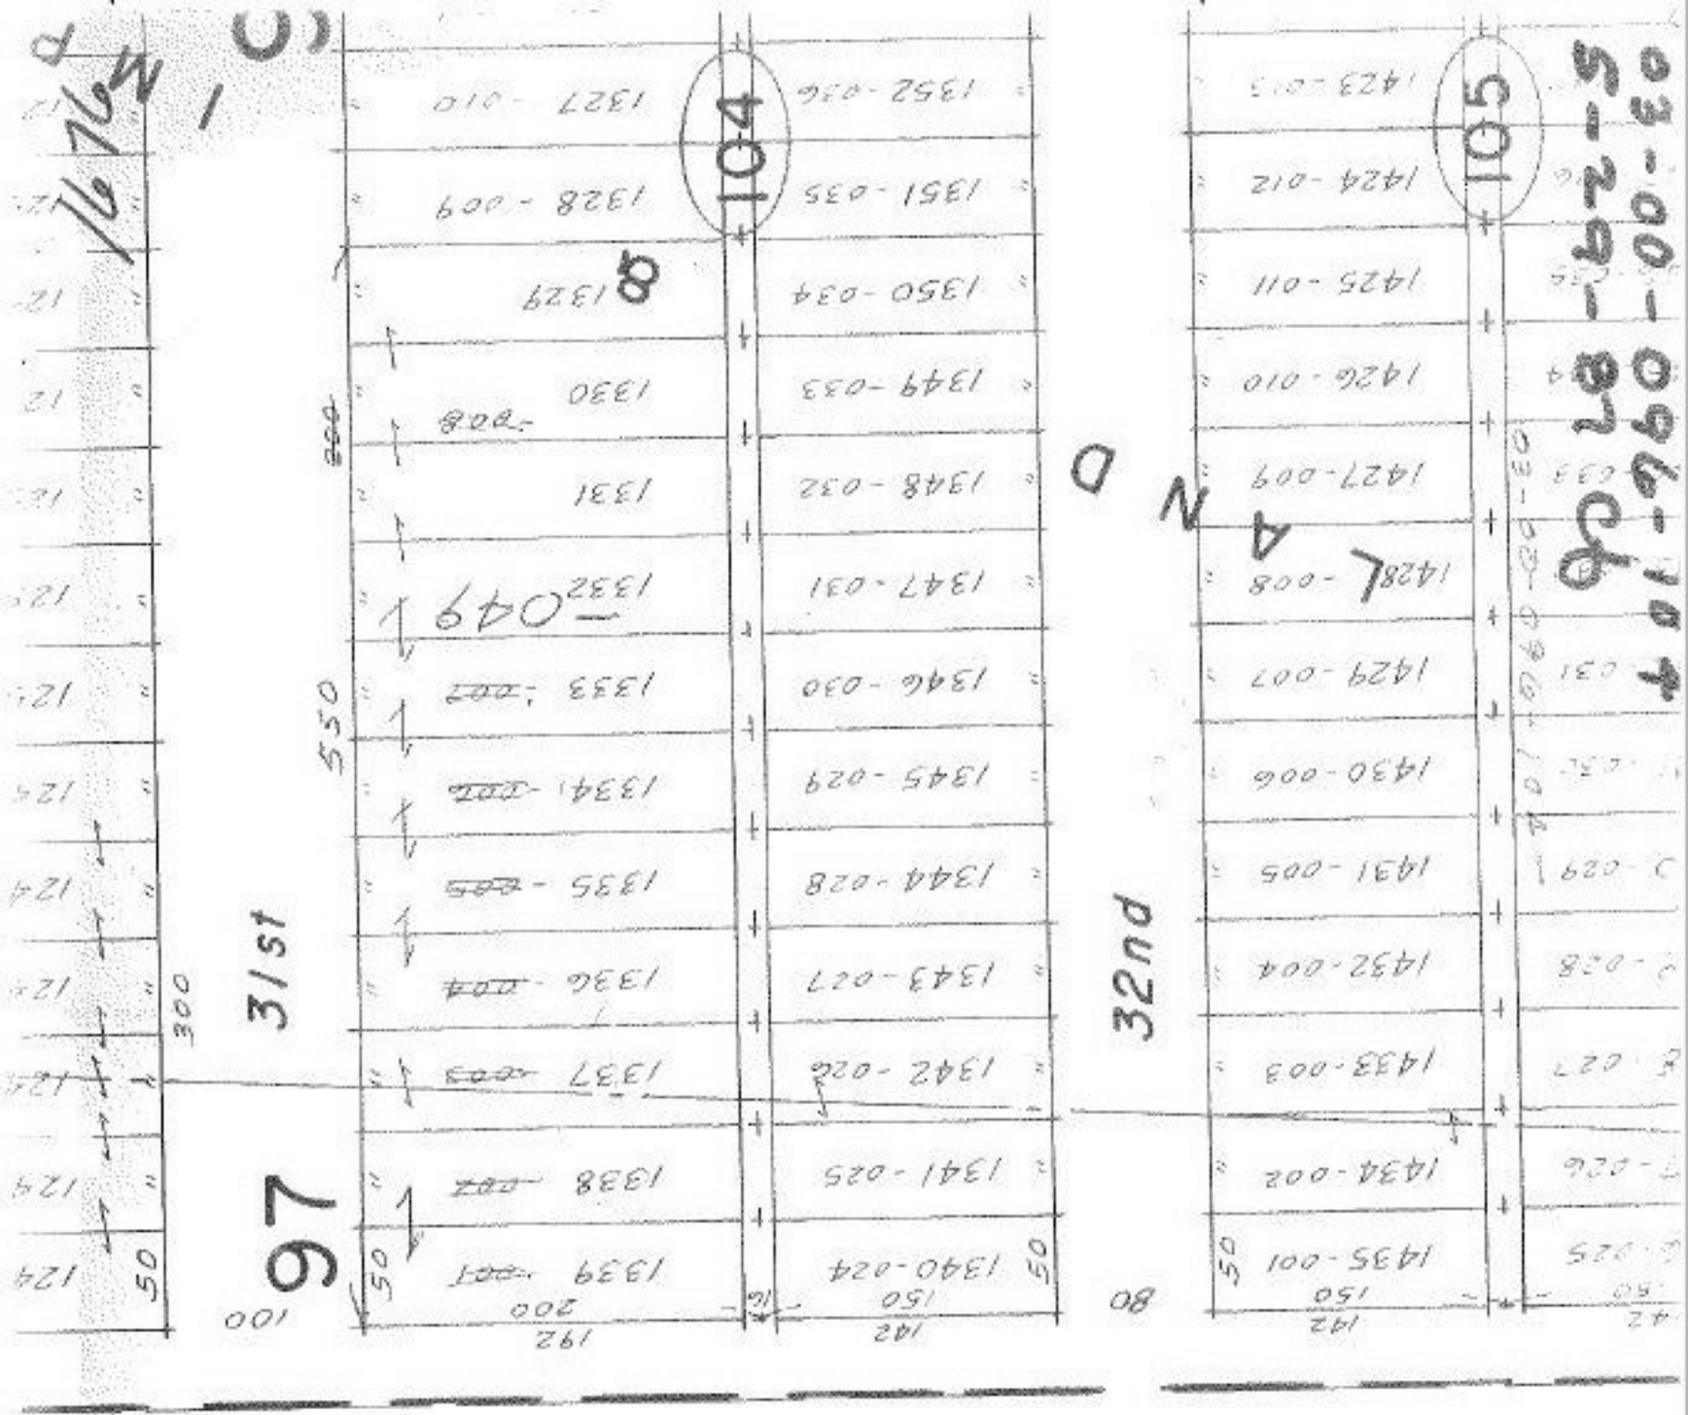
1676
97
31st
32nd
104
105
300
550
100
50
150
200
192
142
80
1327
1328 -009
1329
1330
1331
1332 -049
1333
1334
1335
1336
1337
1338
1339
1340-024
1341-025
1342-026
1343-027
1344-028
1345-029
1346-030
1347-031
1348-032
1349-033
1350-034
1351-035
1352-036
1423-013
1424-012
1425-011
1426-010
1427-009
1428-008
1429-007
1430-006
1431-005
1432-004
1433-003
1434-002
1435-001
03-00-096-00-004
03-00-096-00-005
SEE 3-00-097-B
1676
APPROVED
LORAIN CO.
MAP DEPT.
DATE 4-18-68
3-00-096-A
BY
7-14-86
S.S
N
1 in. = 100 ft.
Done 7-6-88 LMH