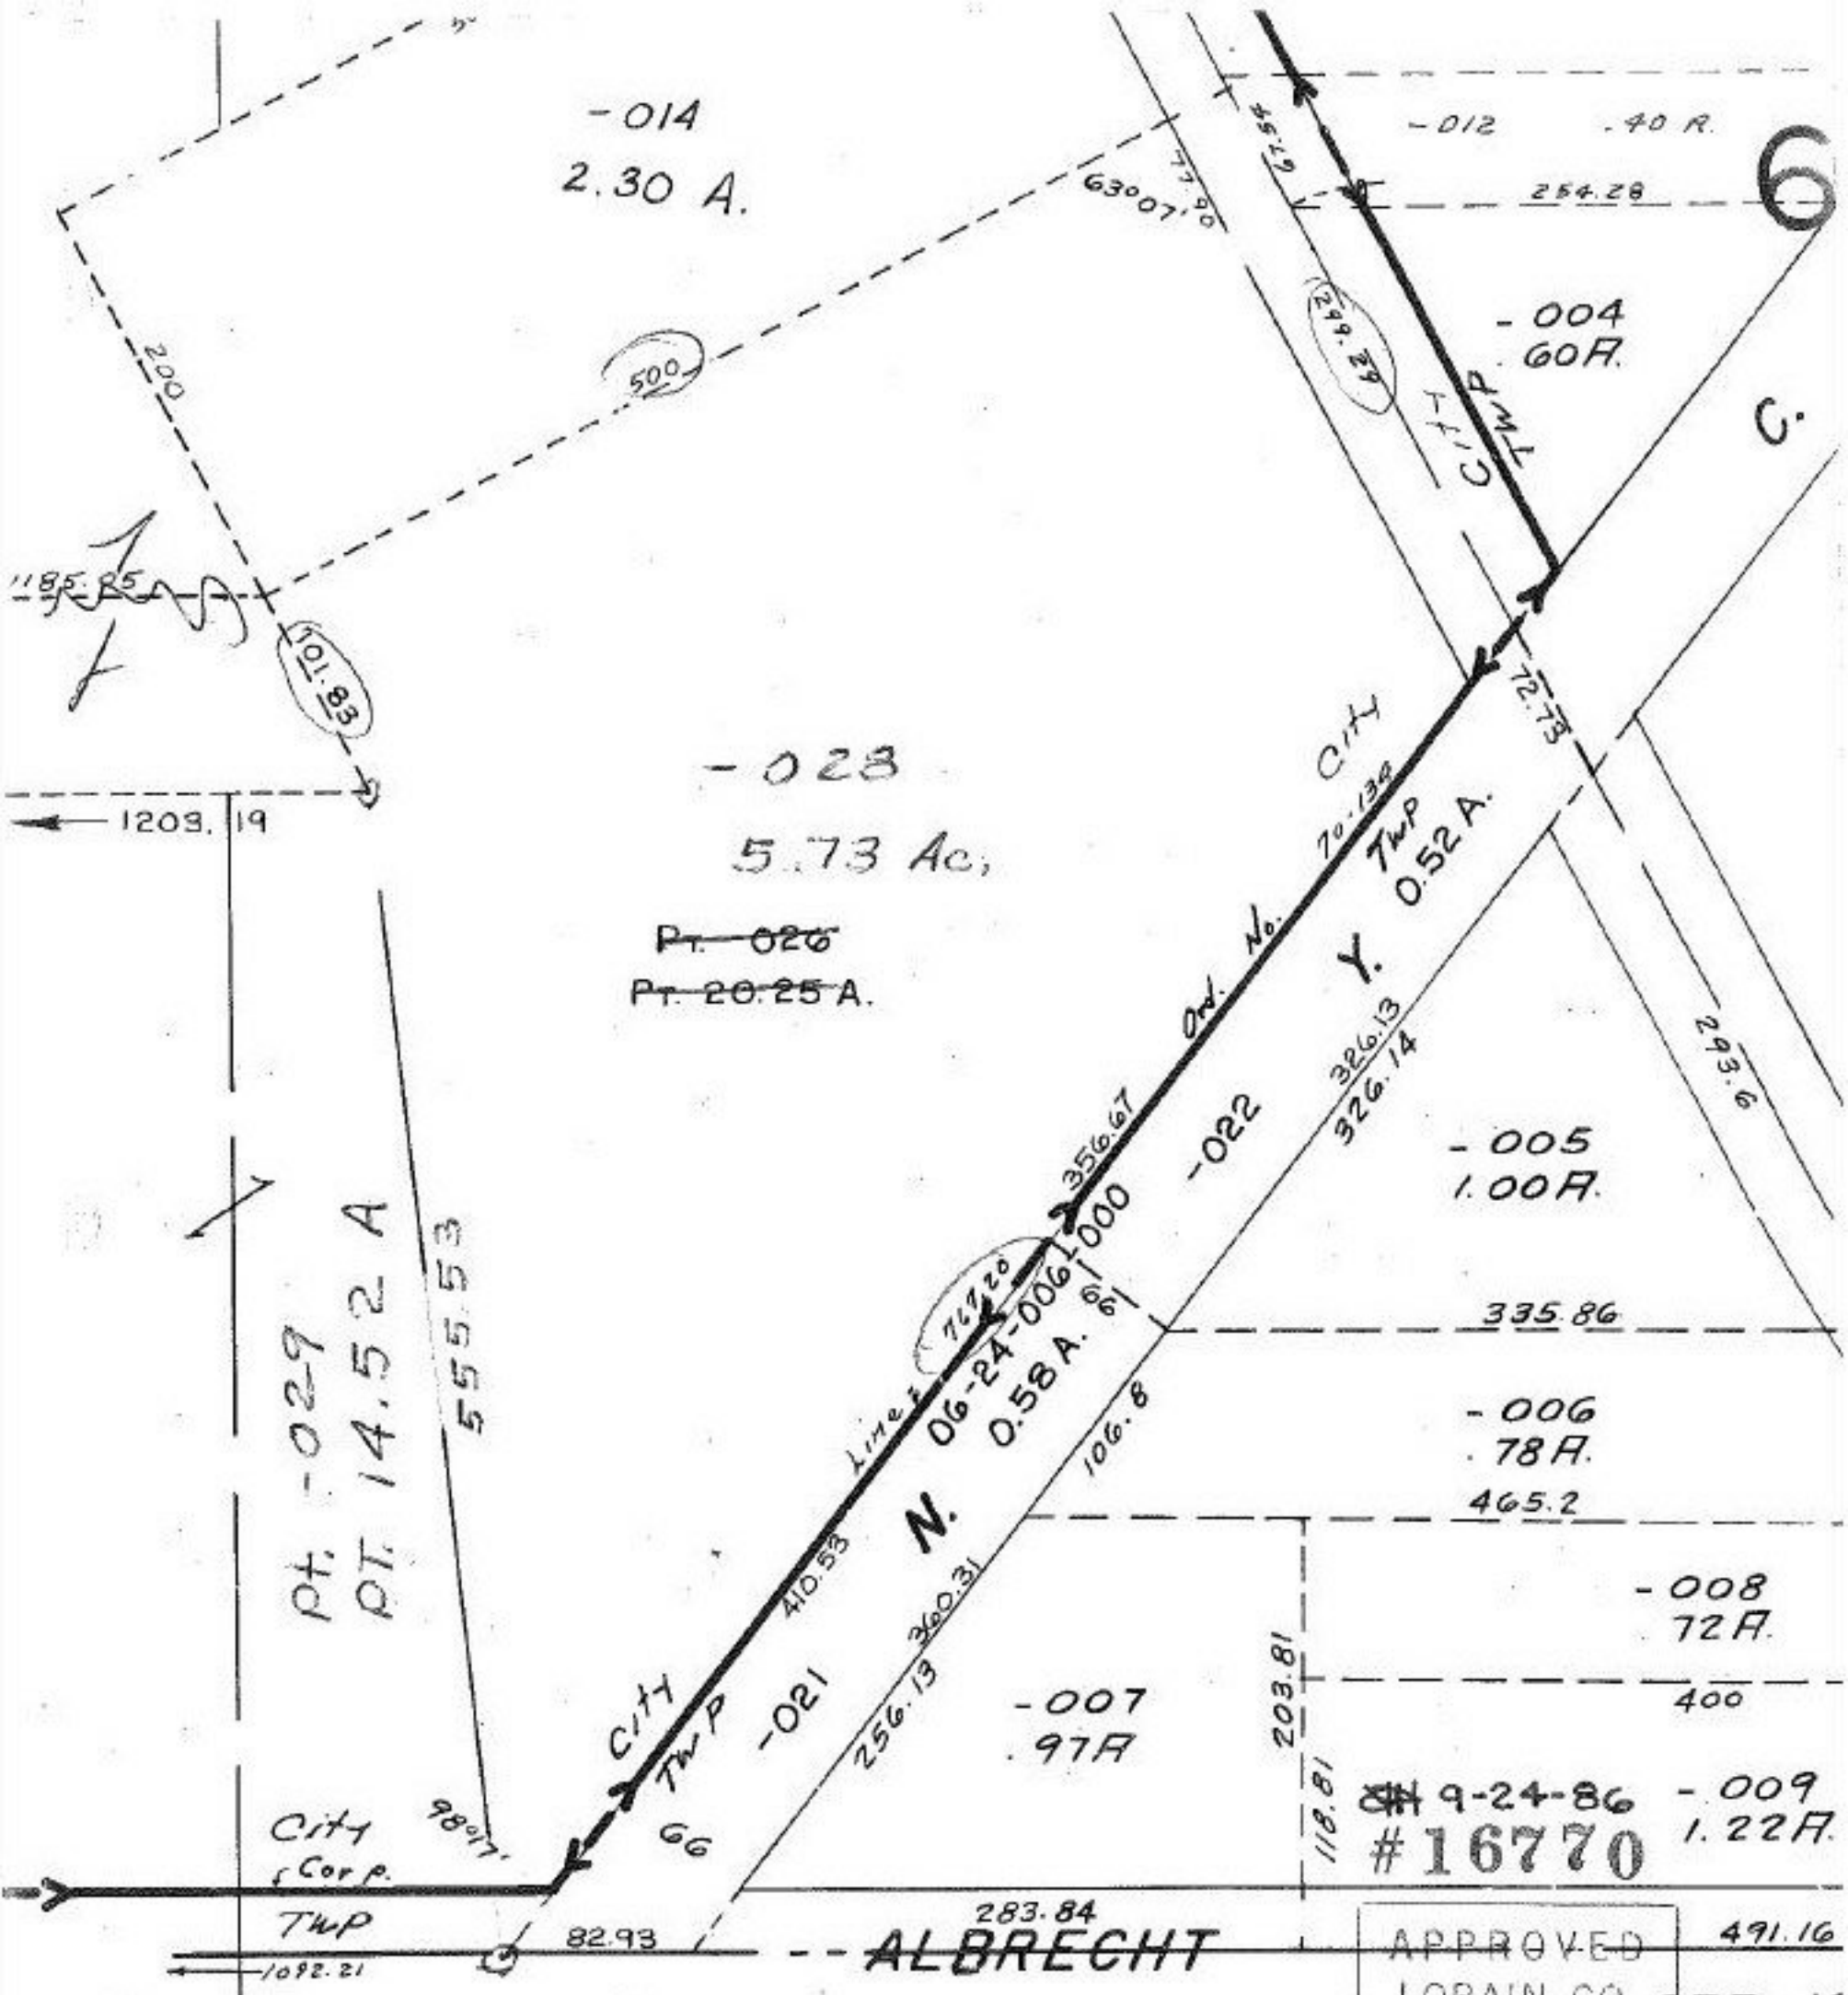

Prior Deed 1280/523
Surveyed By: K. S. A
C = 1:200000.

APPROVED
LORAIN CO.
MAP DEPT.
DATE 6-5-86
PAGE 6-131
BY C. Francis
VOID AFTER 16770

SEE 10

ELYRIA TWP