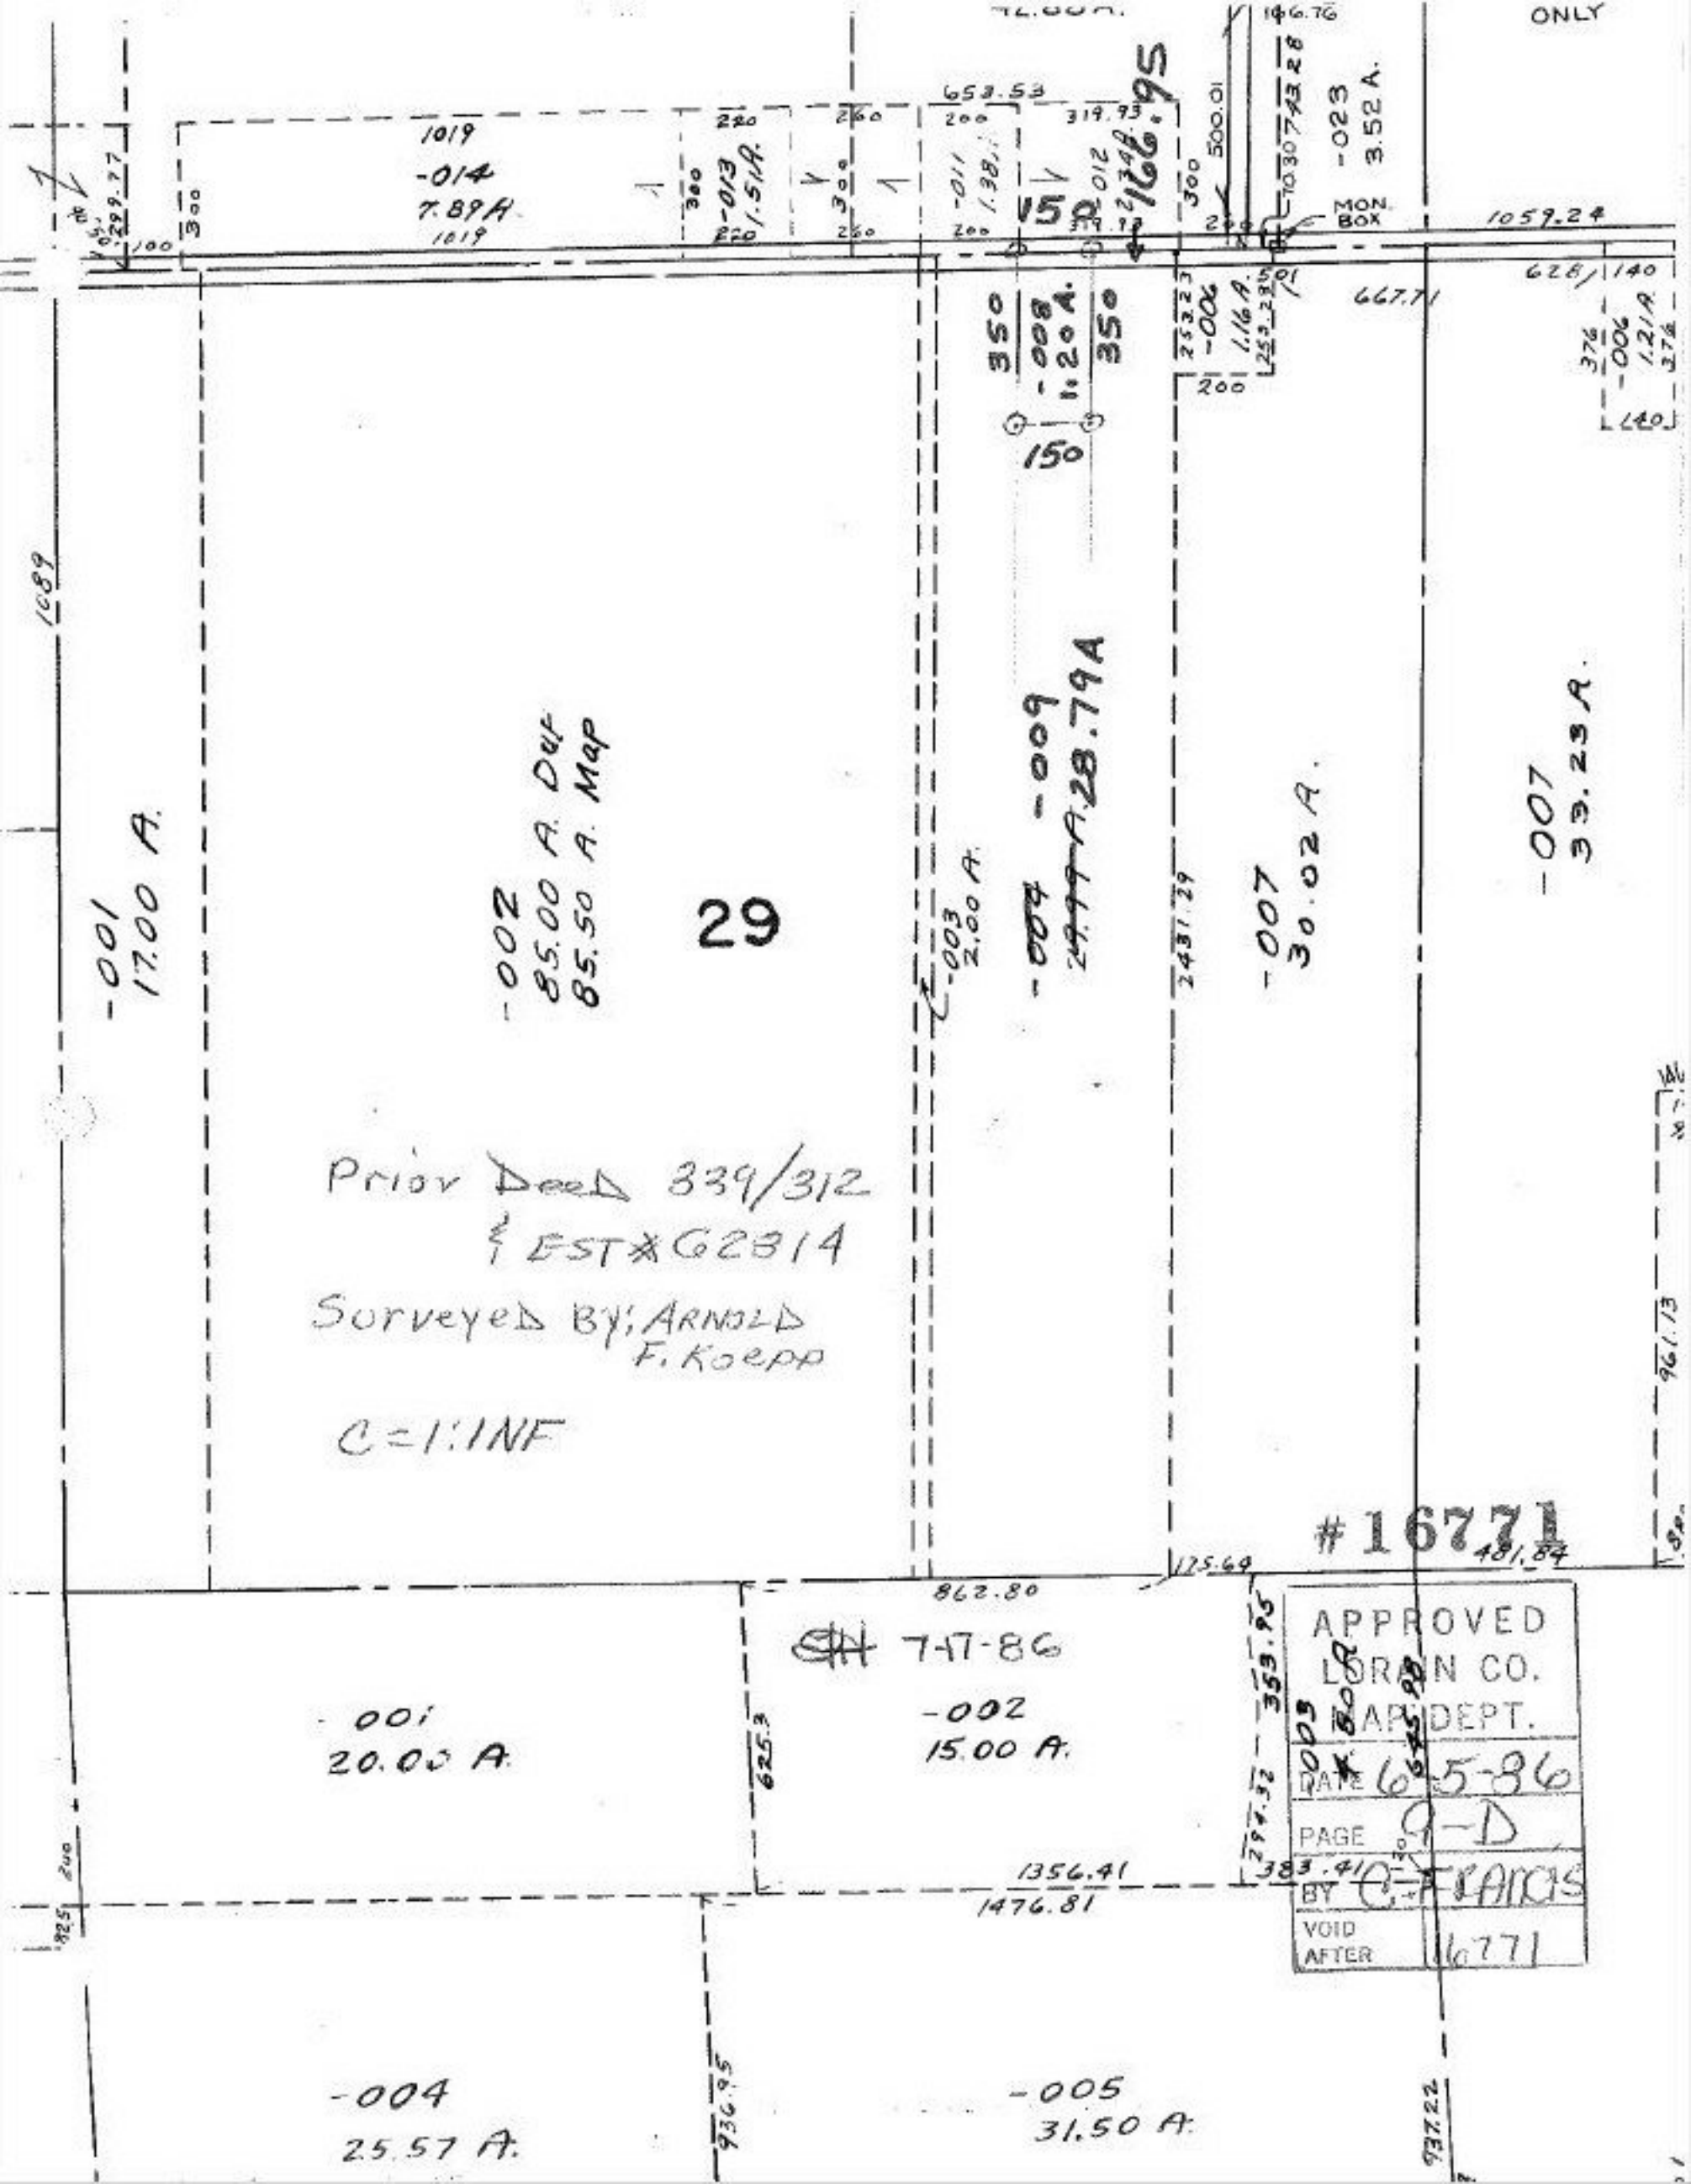
ONLY
1019
-014
7.89 A.
-013
1.51 A.
-011
1.38 A.
166.95
150
-023
3.52 A.
MON. BOX
1059.24
628
140
667.71
350
-008
1.20 A.
350
150
-006
1.16 A.
-006
1.21 A.
1089
-001
17.00 A.
-002
85.00 A. Dup
85.50 A. Map
29
-003
2.00 A.
-004
-009
28.79 A
2431.29
-007
30.02 A.
-007
33.23 A.
Prior Deed 339/312
& EST # 62314
Surveyed By: Arnold
F. Koepp
C=1:INF
#16771
481.84
175.64
862.80
7-17-86
-001
20.00 A.
-002
15.00 A.
625.3
353.95
1356.41
1476.81
383.41
-004
25.57 A.
-005
31.50 A.
936.95
937.22
APPROVED
LORAIN CO.
MAP DEPT.
DATE 6-5-86
PAGE 9-D
BY C. Francis
VOID AFTER 16771