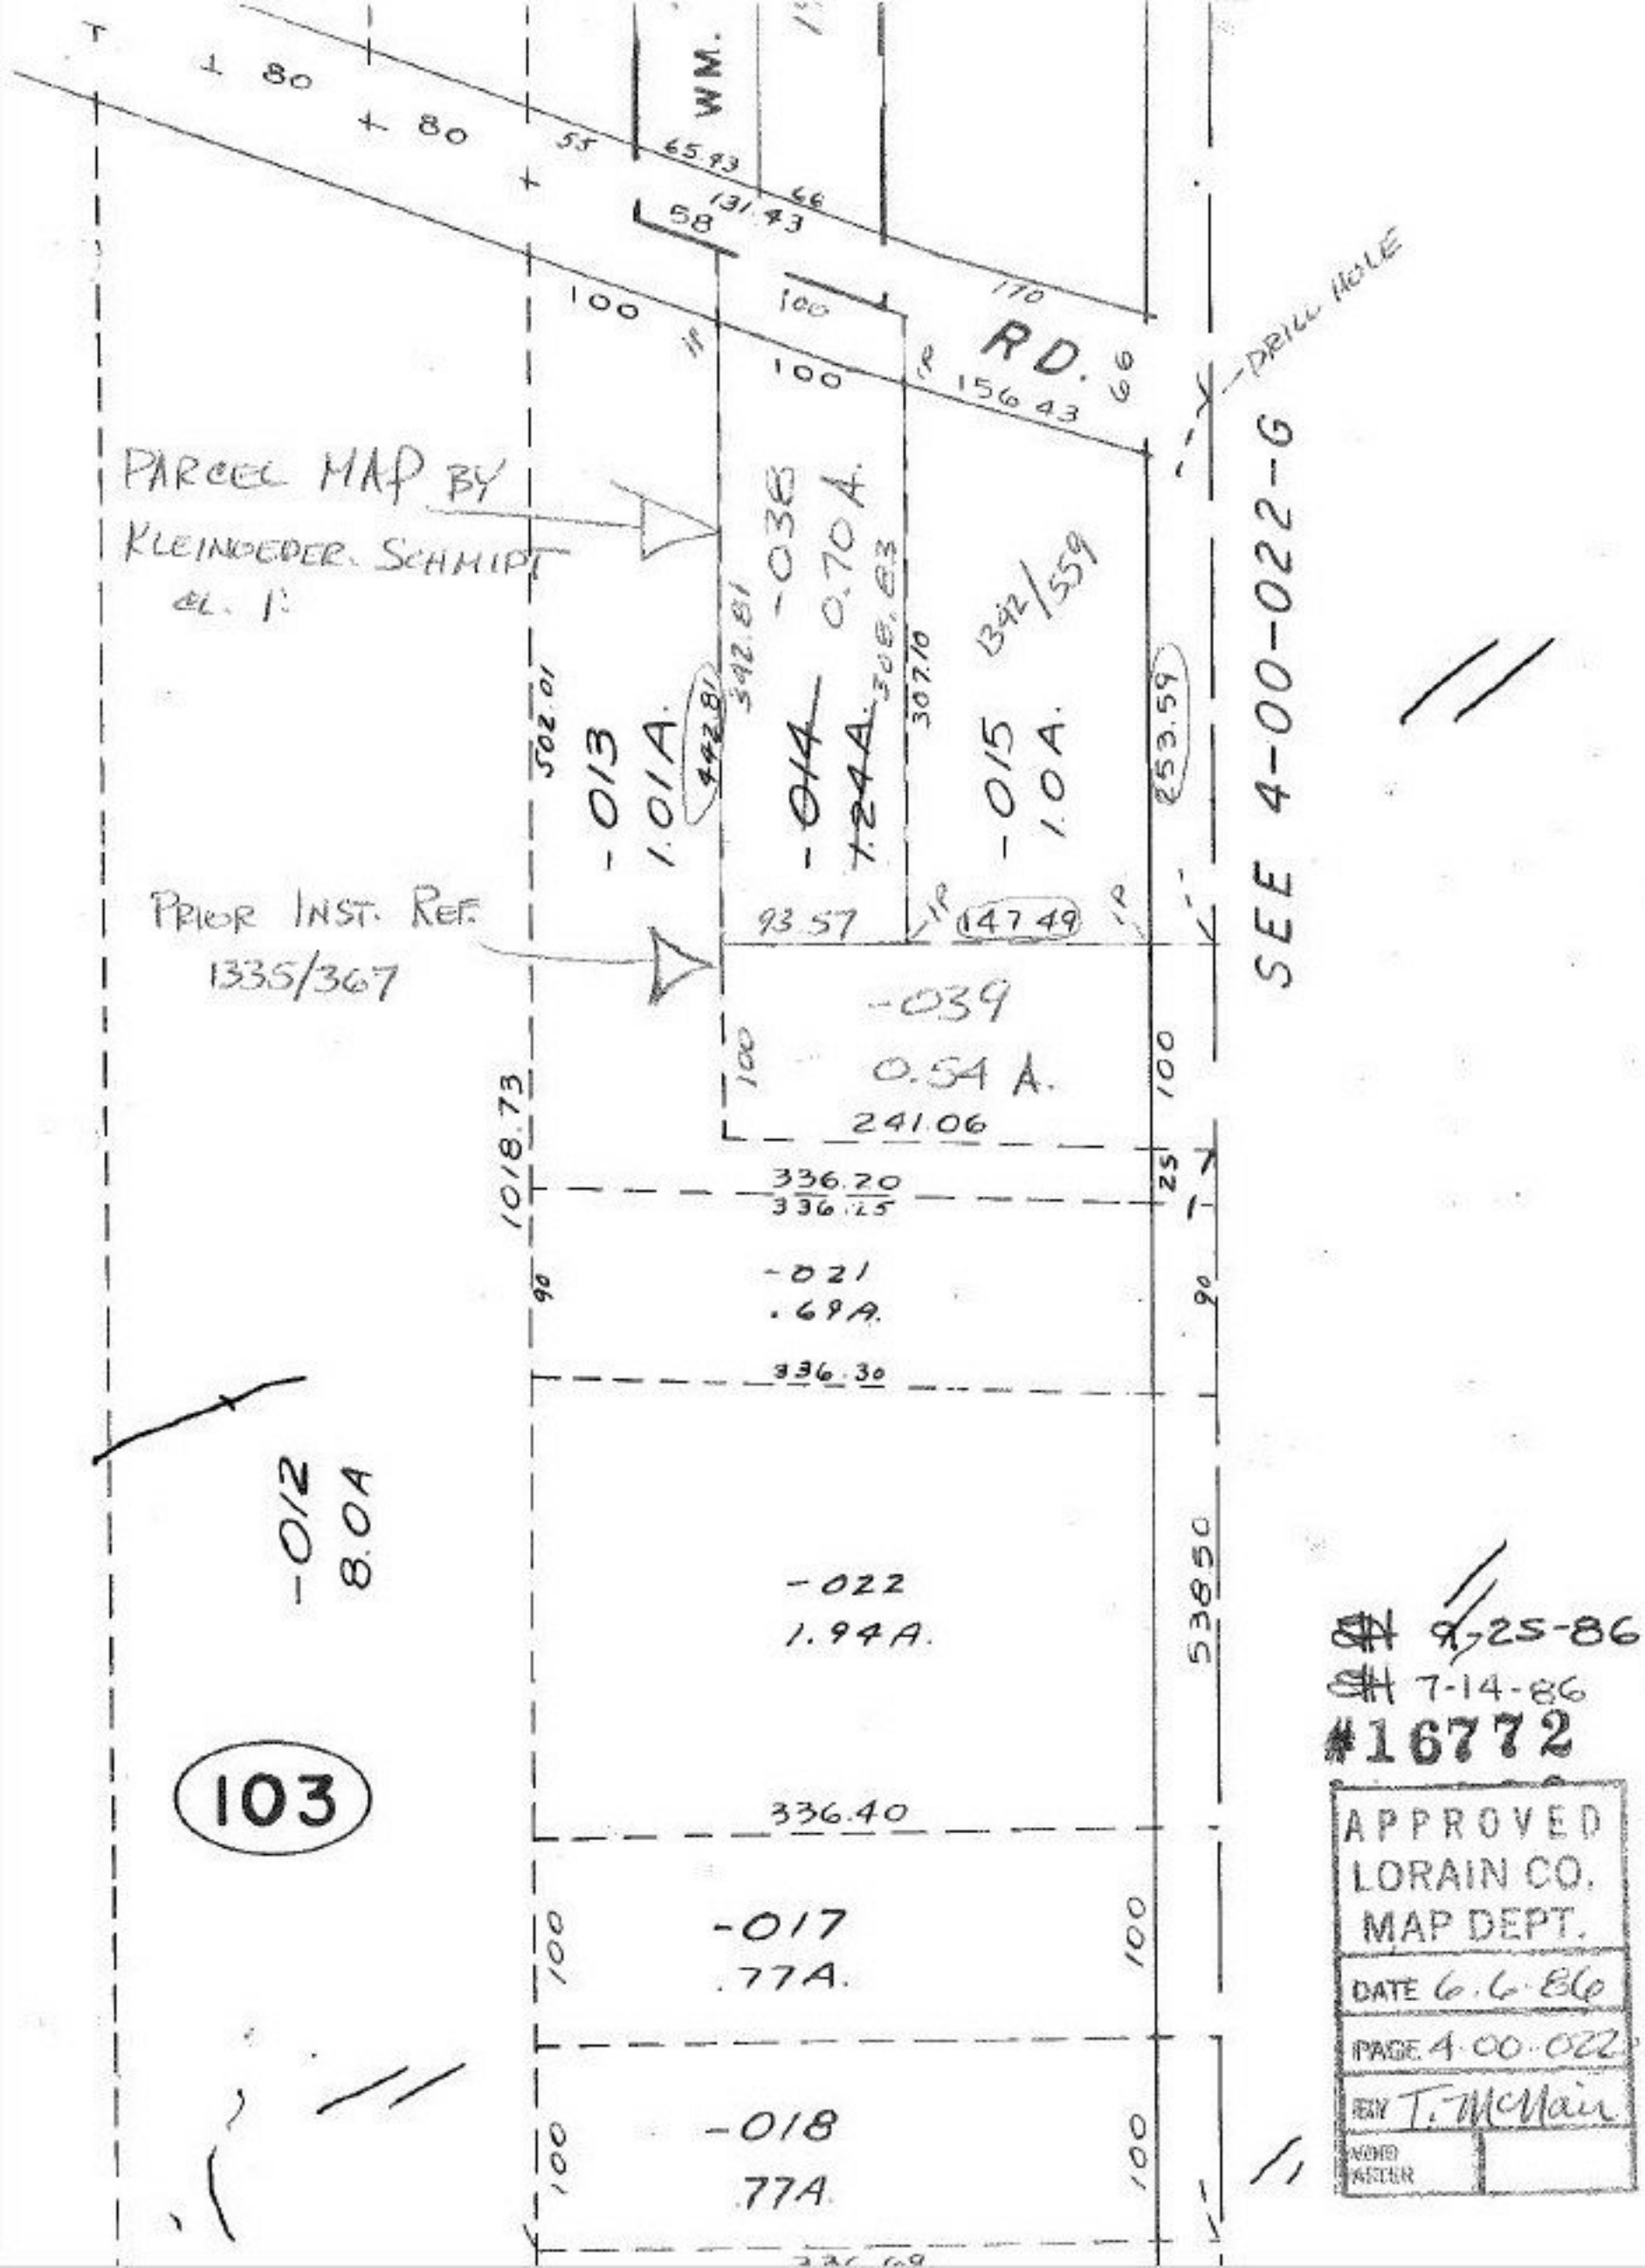
WM.
RD.
DRILL HOLE
PARCEL MAP BY
KLEINOEDER. SCHMIDT
& ASS.
PRIOR INST. REF.
1335/367
-013
1.01A.
-036
0.70A.
-014
1.24A.
-015
1.0A.
342/559
-039
0.54 A.
-021
.69A.
-012
8.0A
-022
1.94A.
103
-017
.77A.
-018
.77A.
SEE 4-00-022-G
9-25-86
7-14-86
#16772
APPROVED
LORAIN CO.
MAP DEPT.
DATE 6.6.86
PAGE 4-00-022-F
BY T. McMain