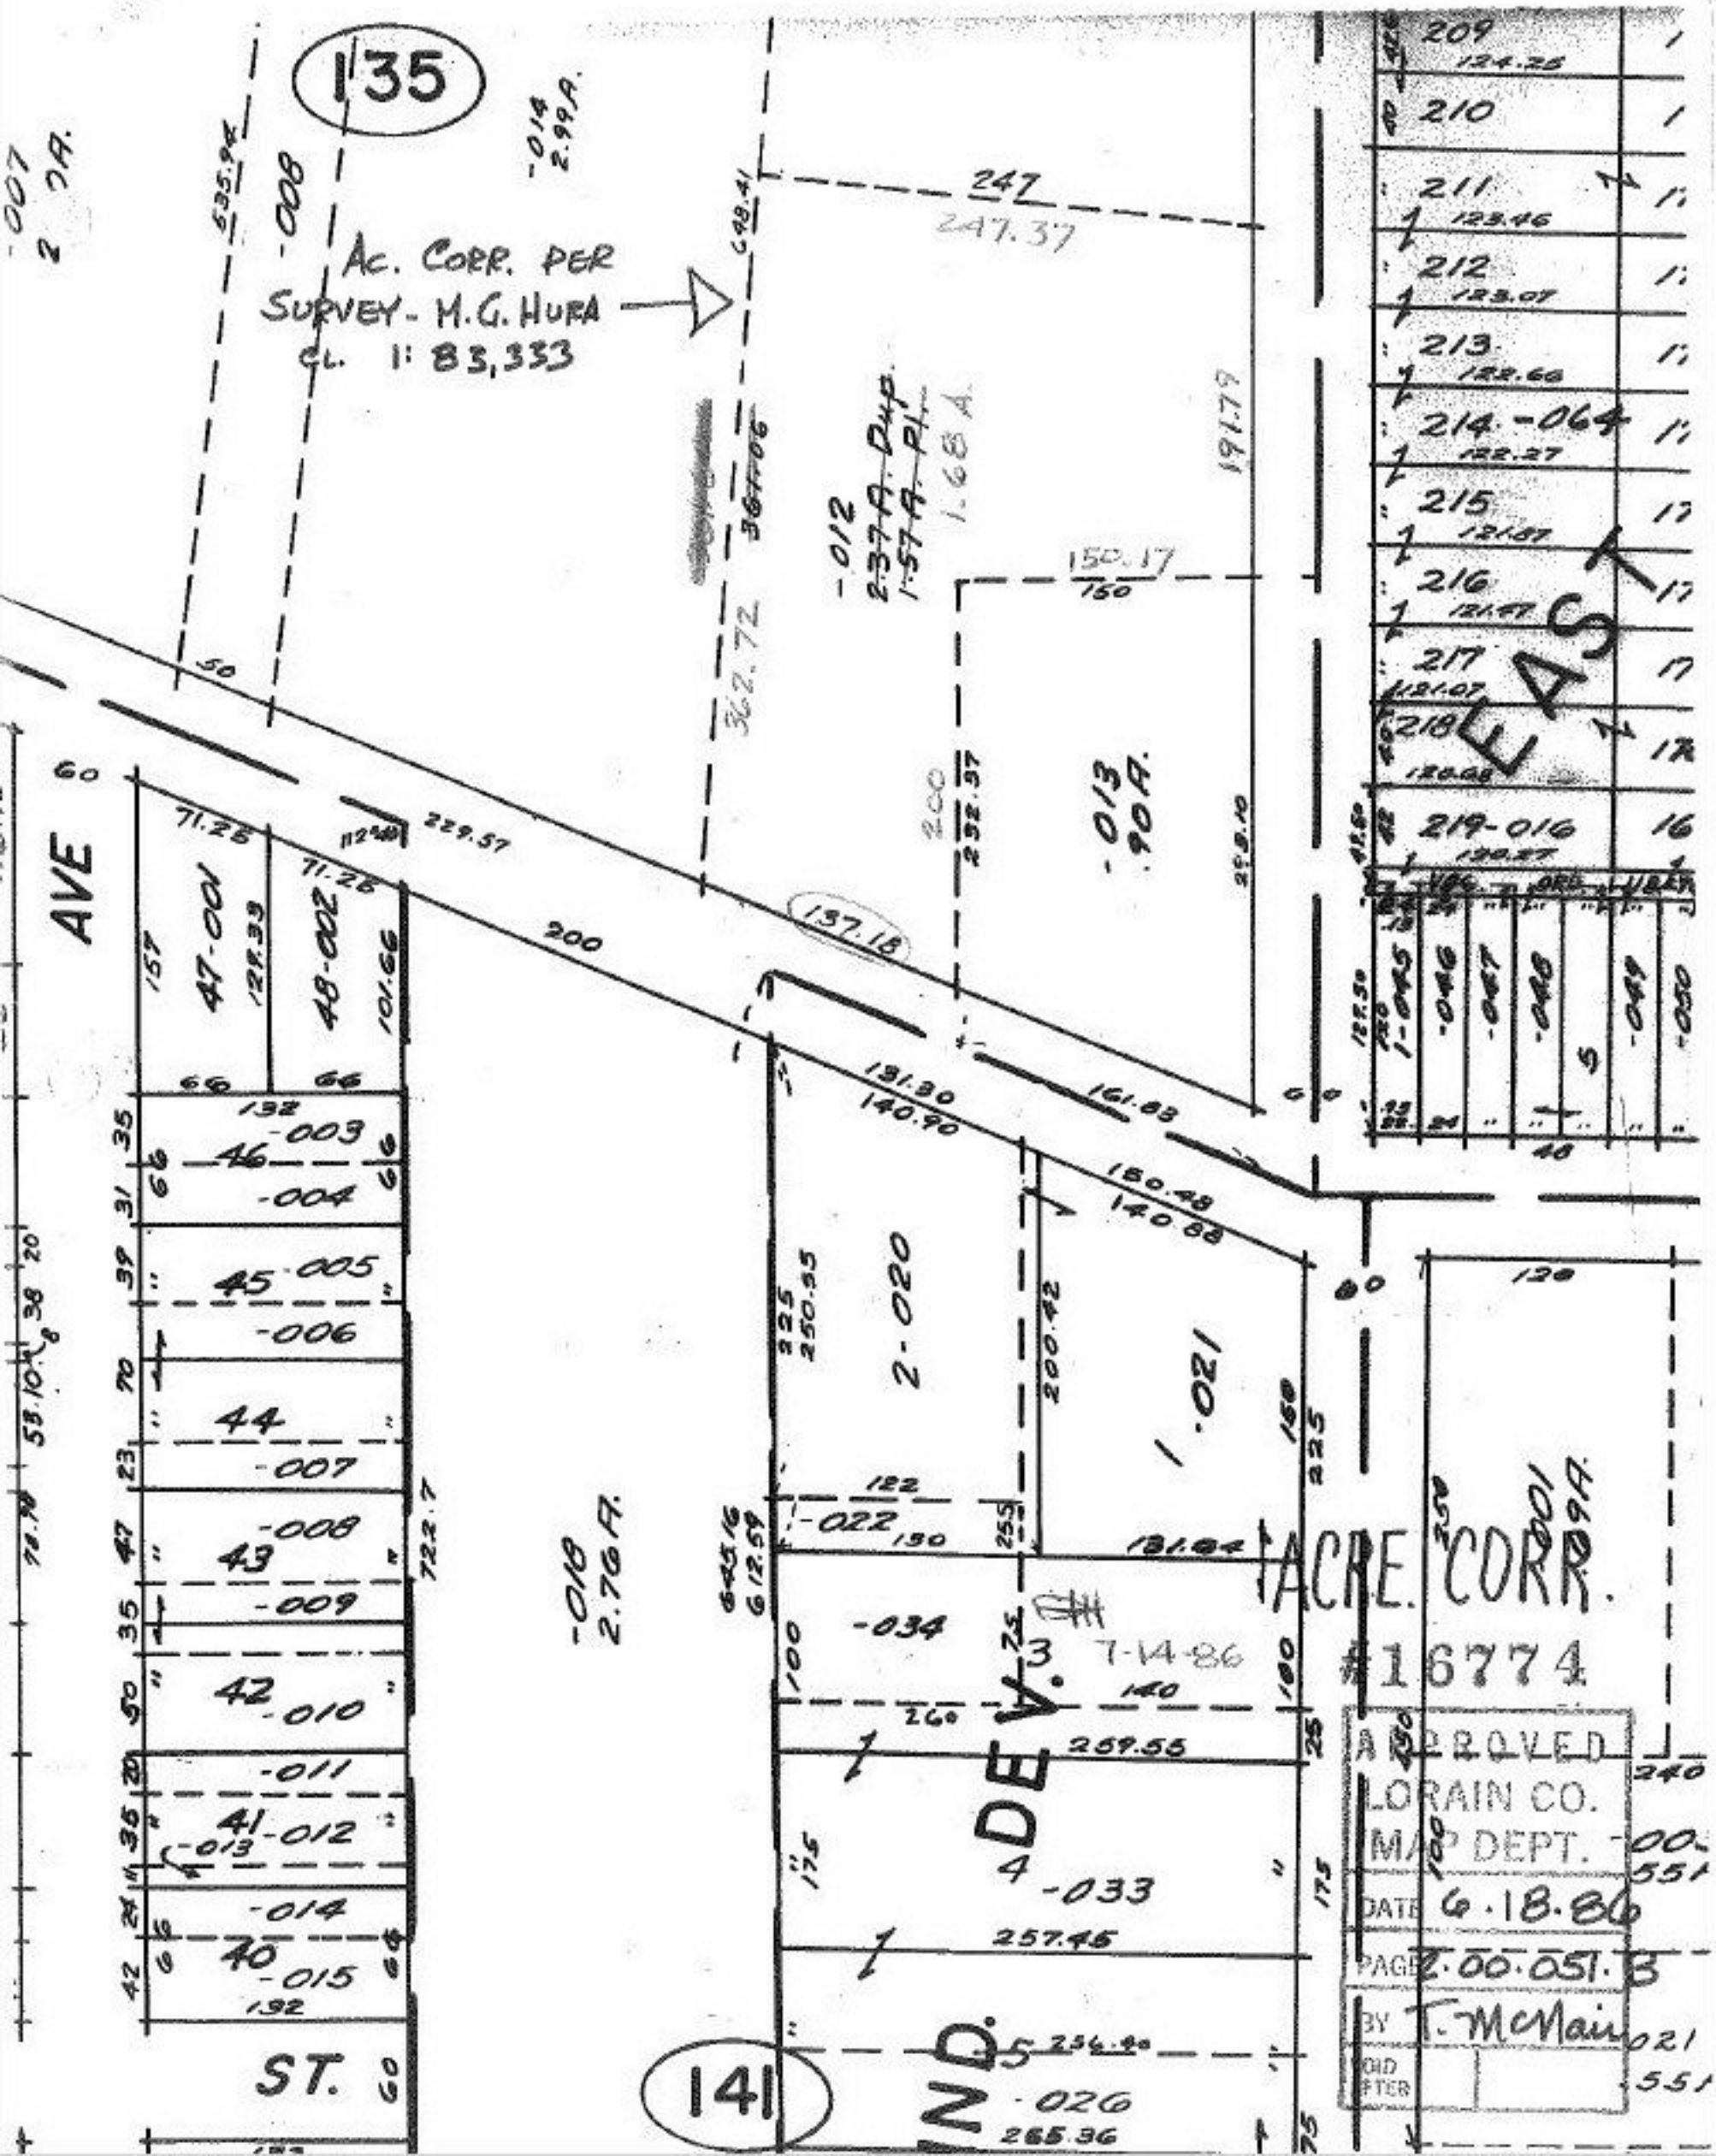
135
AC. CORR. PER SURVEY - M.G. HURA CL. 1: 83,333
247
247.37
191.79
150.17
150
-012
2.37 A. Dup.
1.57 A. Pl.
1.68 A.
362.72
-013
.90 A.
137.18
200
229.57
71.25
47-001
48-002
AVE
ST.
141
2-020
1-021
-018
2.76 A.
-022
-034
-033
-026
DEV.
ACRE. CORR.
#16774
7-14-86
APPROVED
LORAIN CO.
MAP DEPT.
DATE 6.18.86
PAGE 2.00.051.B
BY T. McNair
EAST