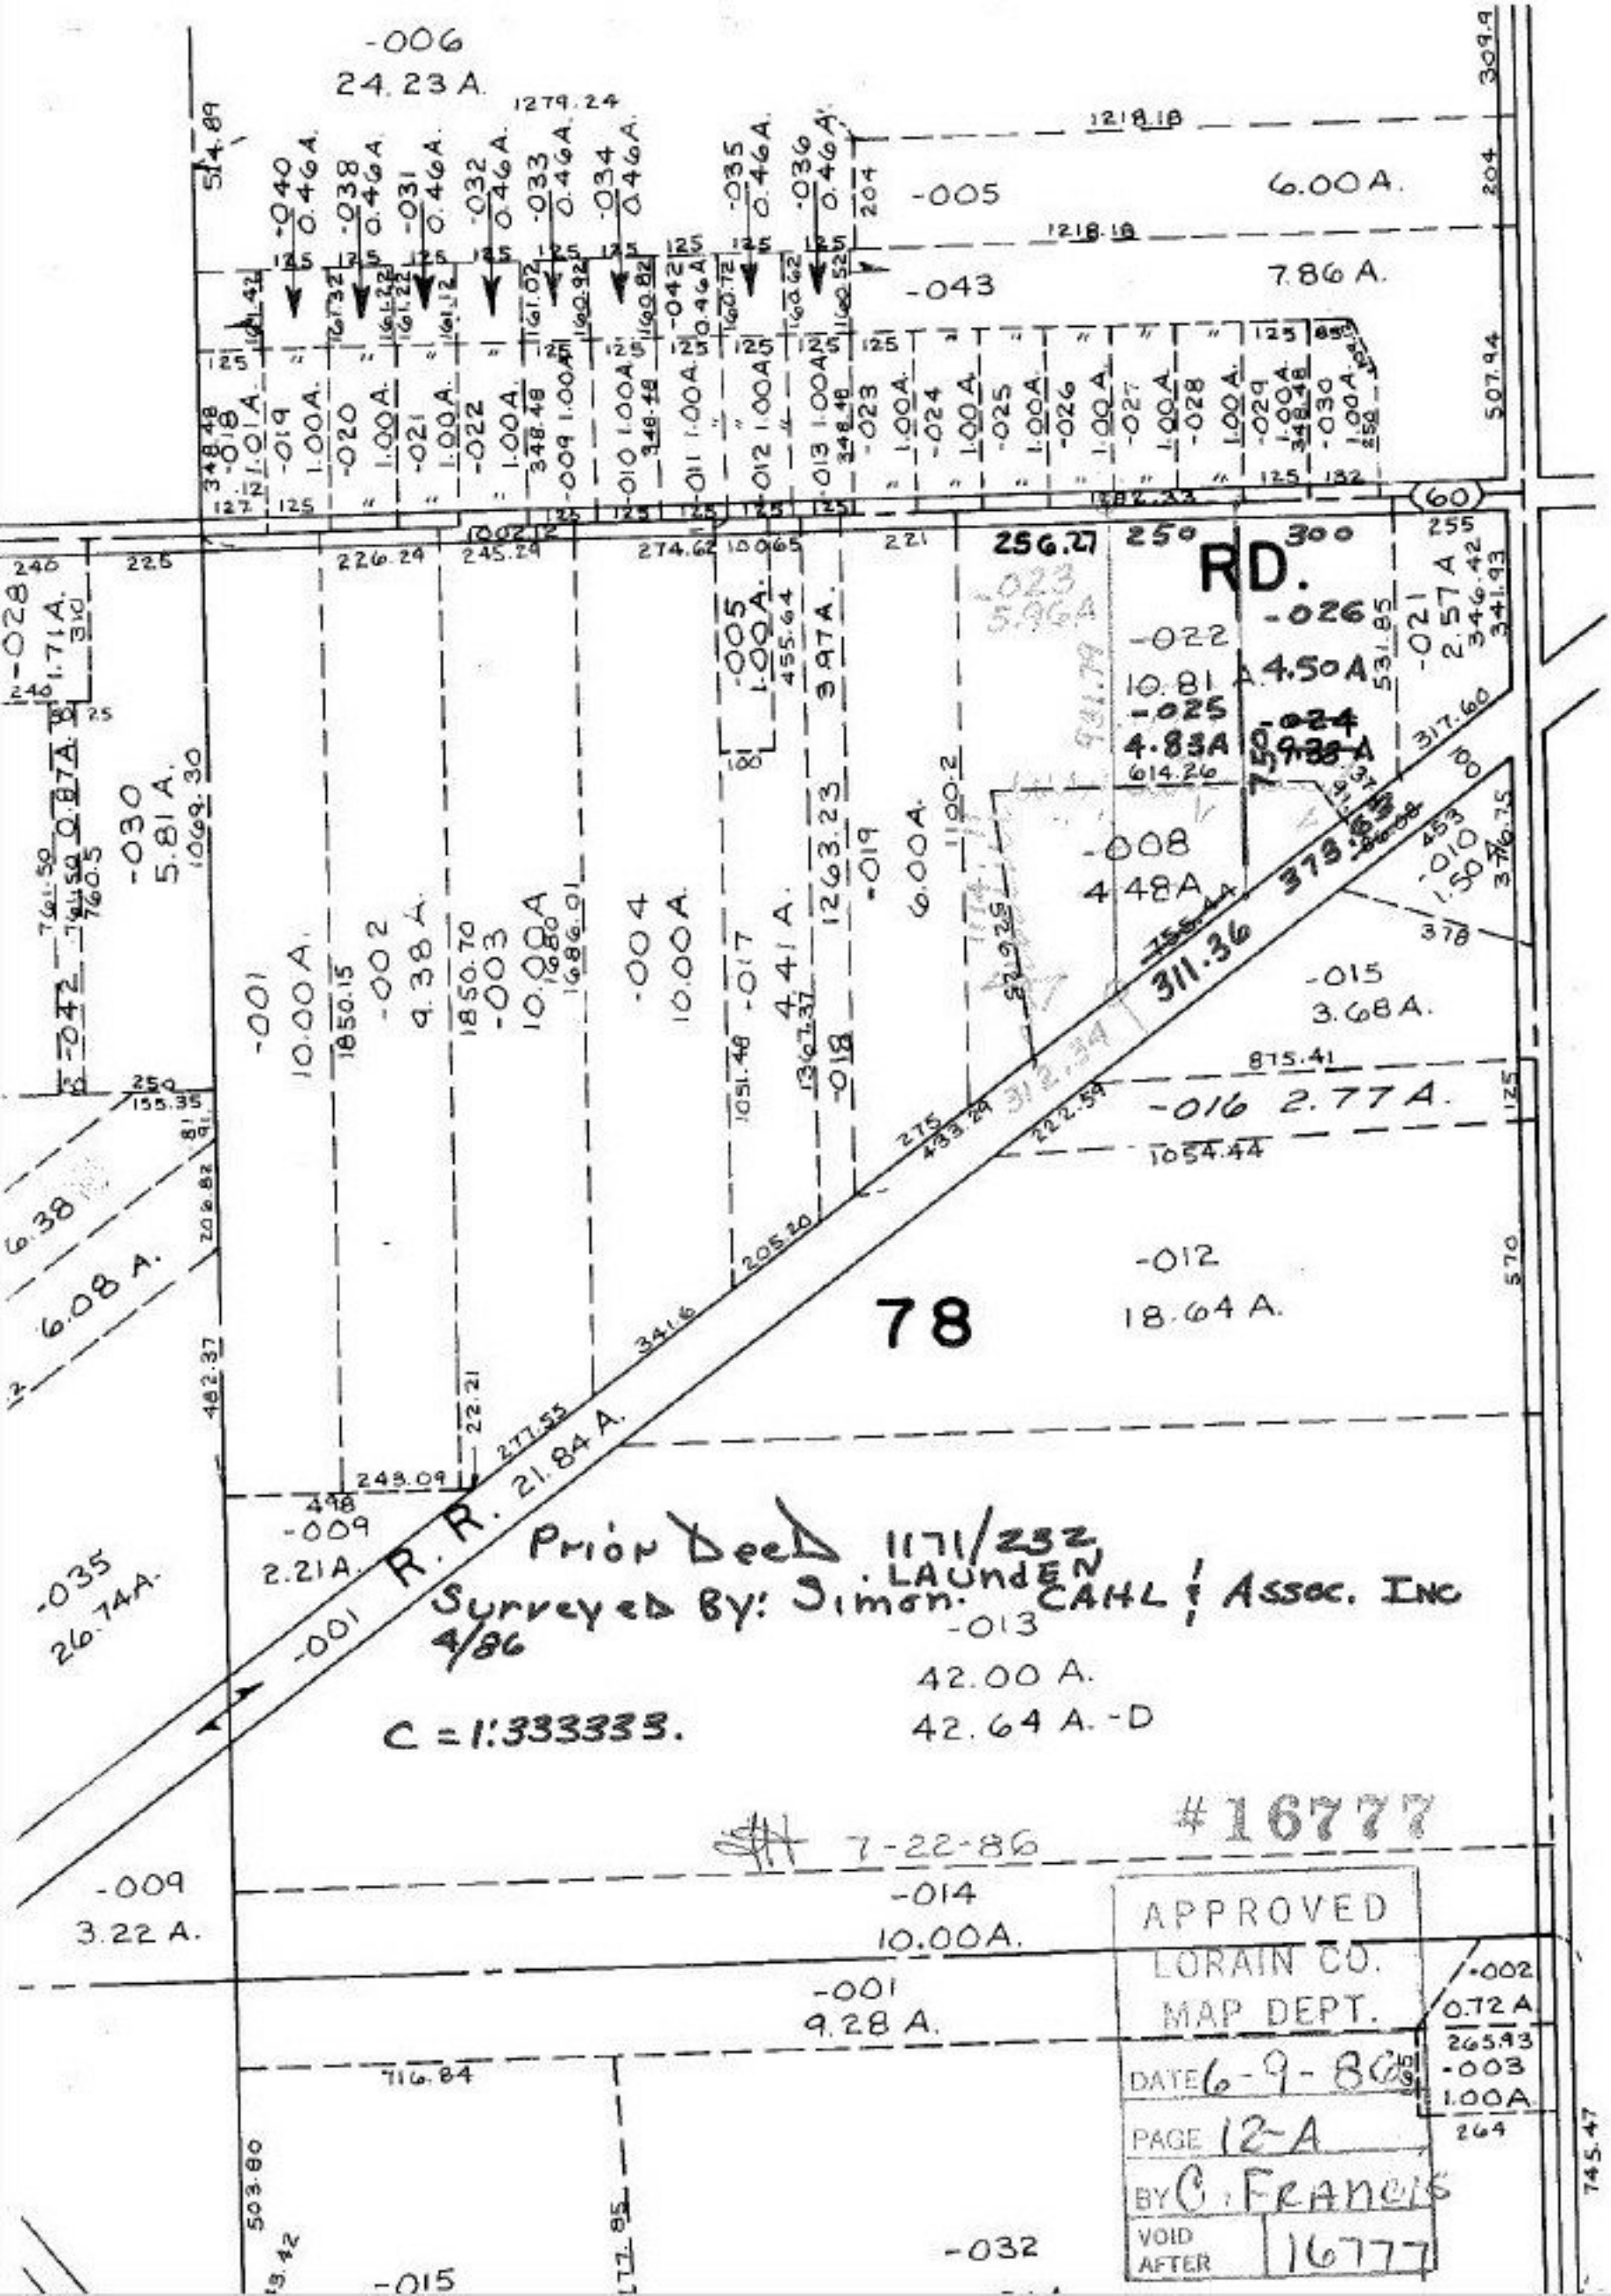

-006
24.23 A.
-005
6.00 A.
-043
7.86 A.
RD.
-022
10.81 A.
-026
4.50 A
-025
4.83 A
-008
4.48 A
-015
3.68 A.
-016 2.77 A.
-012
18.64 A.
78
R. R.
21.84 A.
-009
2.21 A.
-035
26.74 A.
-001
-013
42.00 A.
42.64 A.-D
C = 1:333333.
Prior Deed 1171/232
Surveyed By: Simon. LAUNDEN CAHL & Assoc. Inc
4/86
#16777
7-22-86
-009
3.22 A.
-014
10.00 A.
-001
9.28 A.
-002
0.72 A
-003
1.00 A.
-032
-015
APPROVED
LORAIN CO.
MAP DEPT.
DATE 6-9-86
PAGE 12-A
BY C. Francis
VOID AFTER 16777