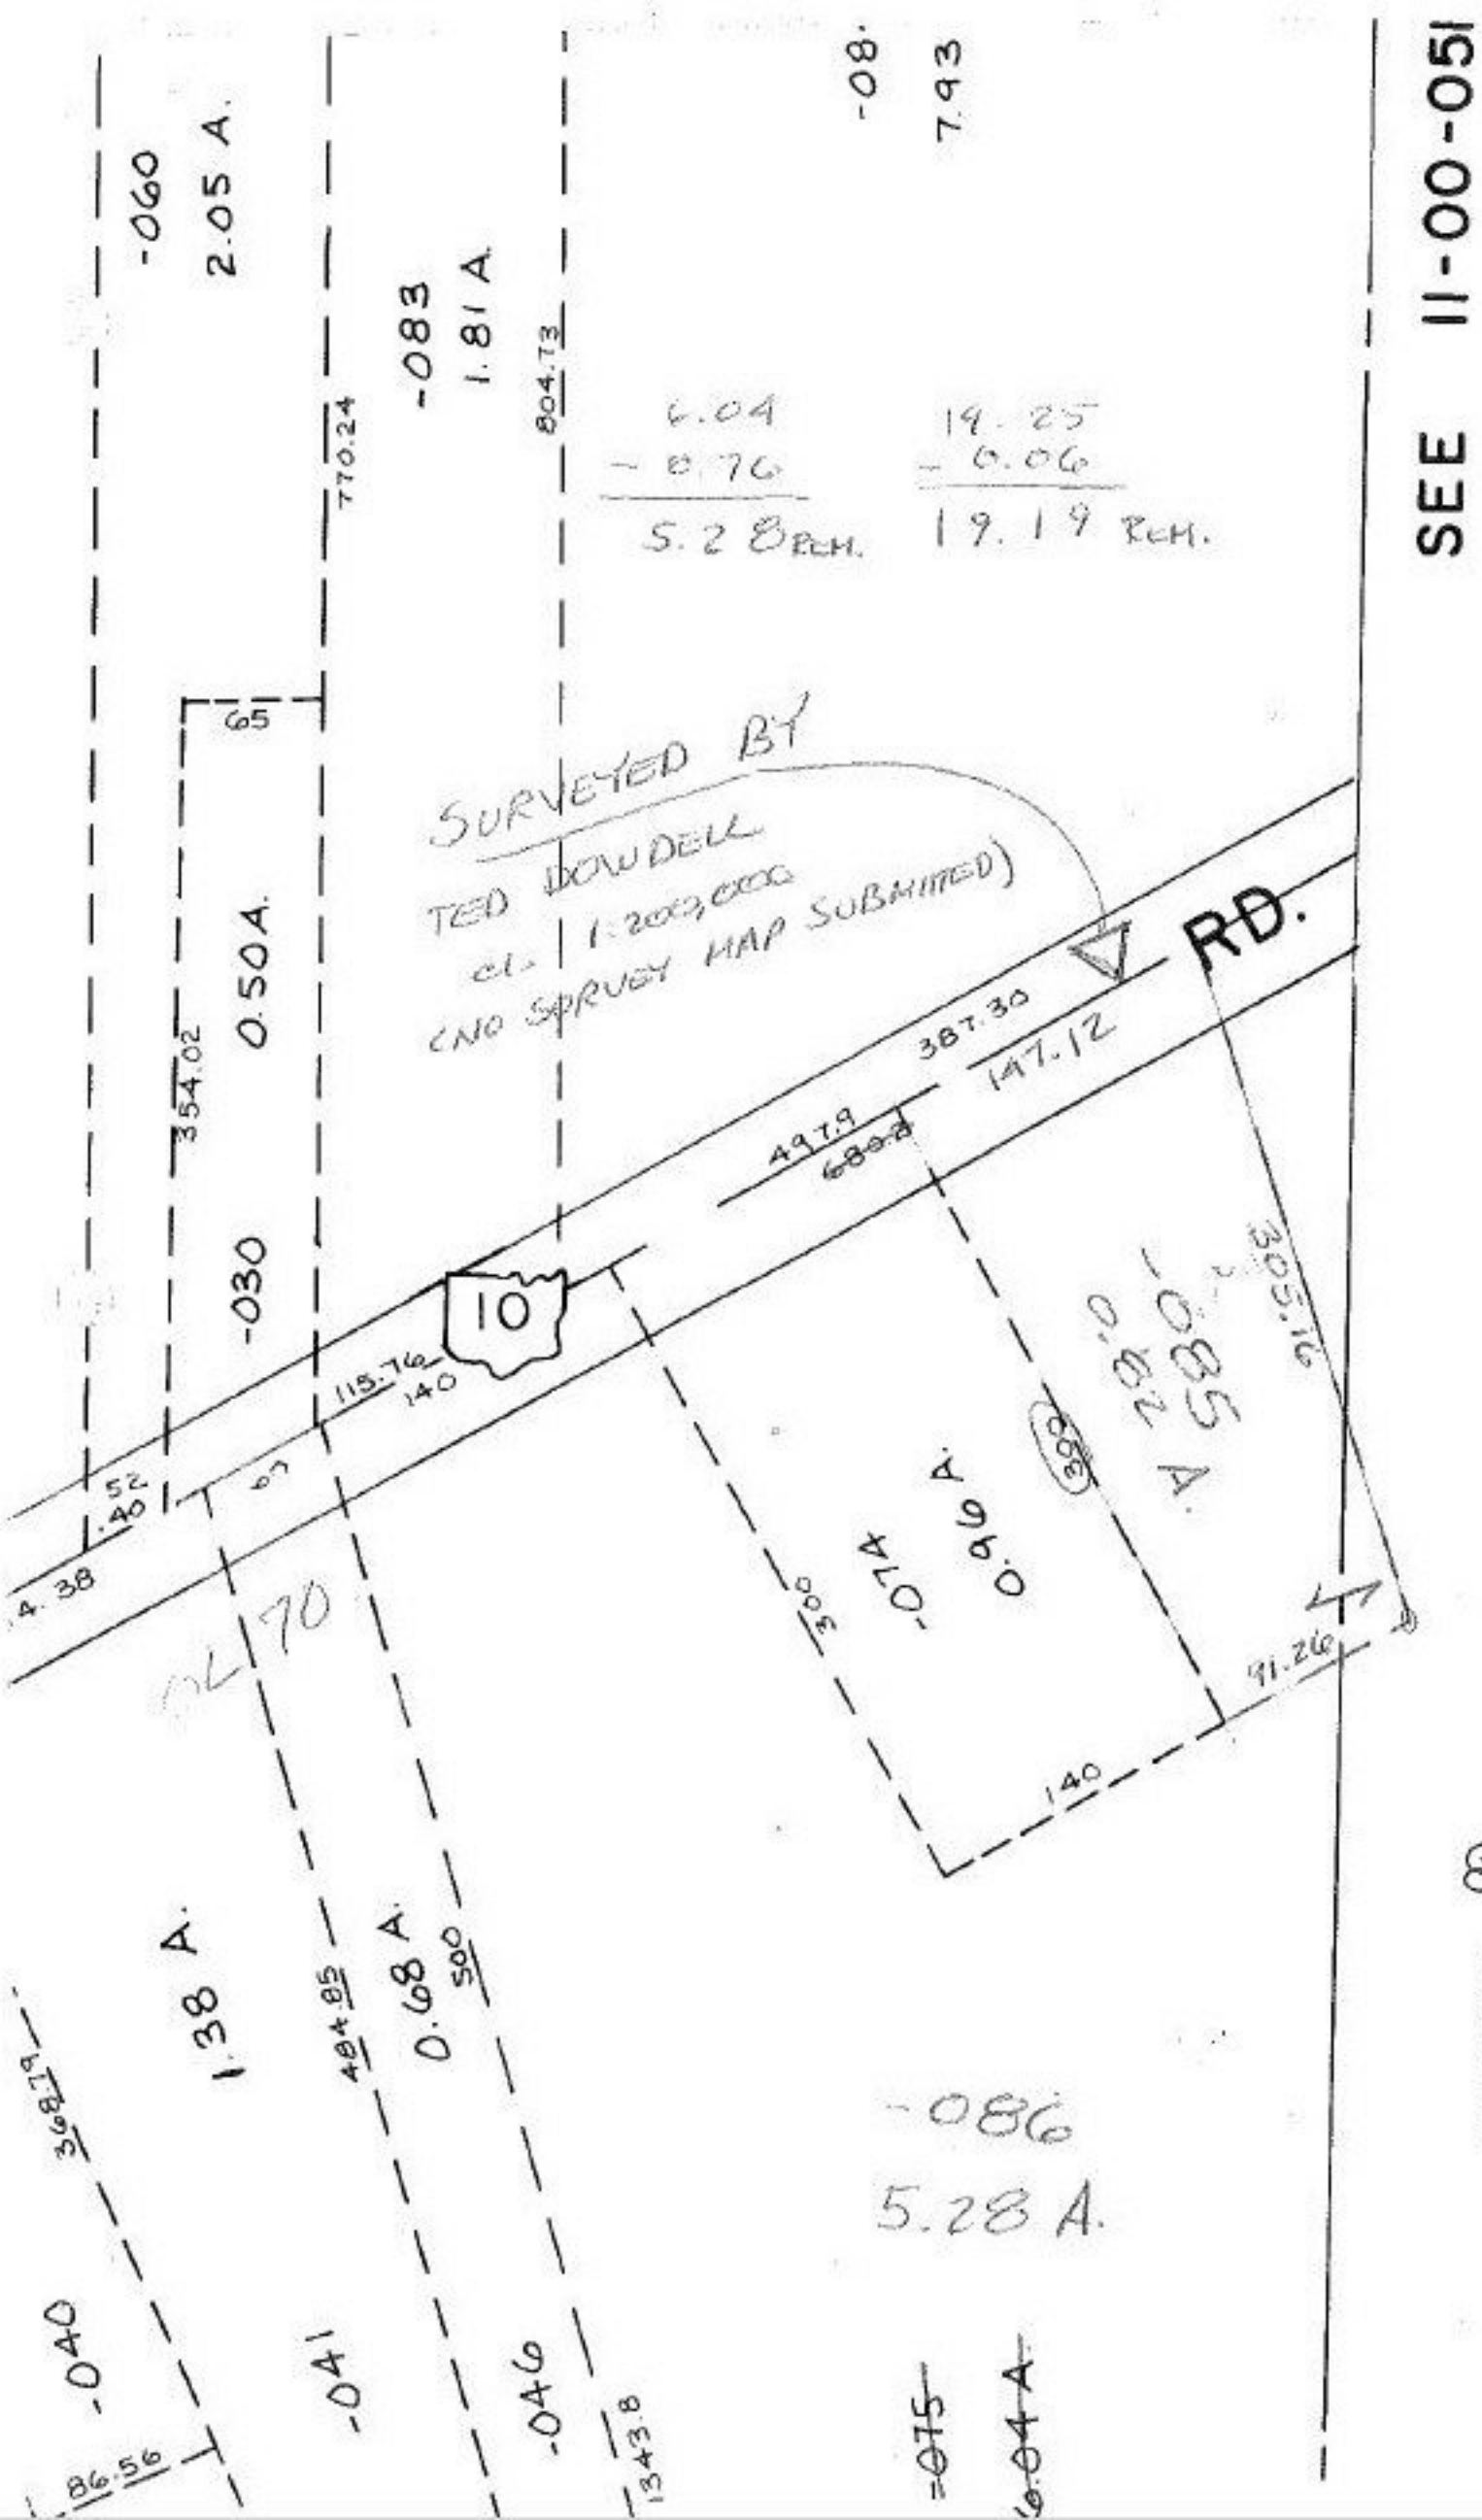

10/21/86

#16781

APPROVED
LORAIN CO.
MAP DEPT.

DATE 8-13-86

PAGE 11-00-070-B

BY T. McNair

VOID AFTER