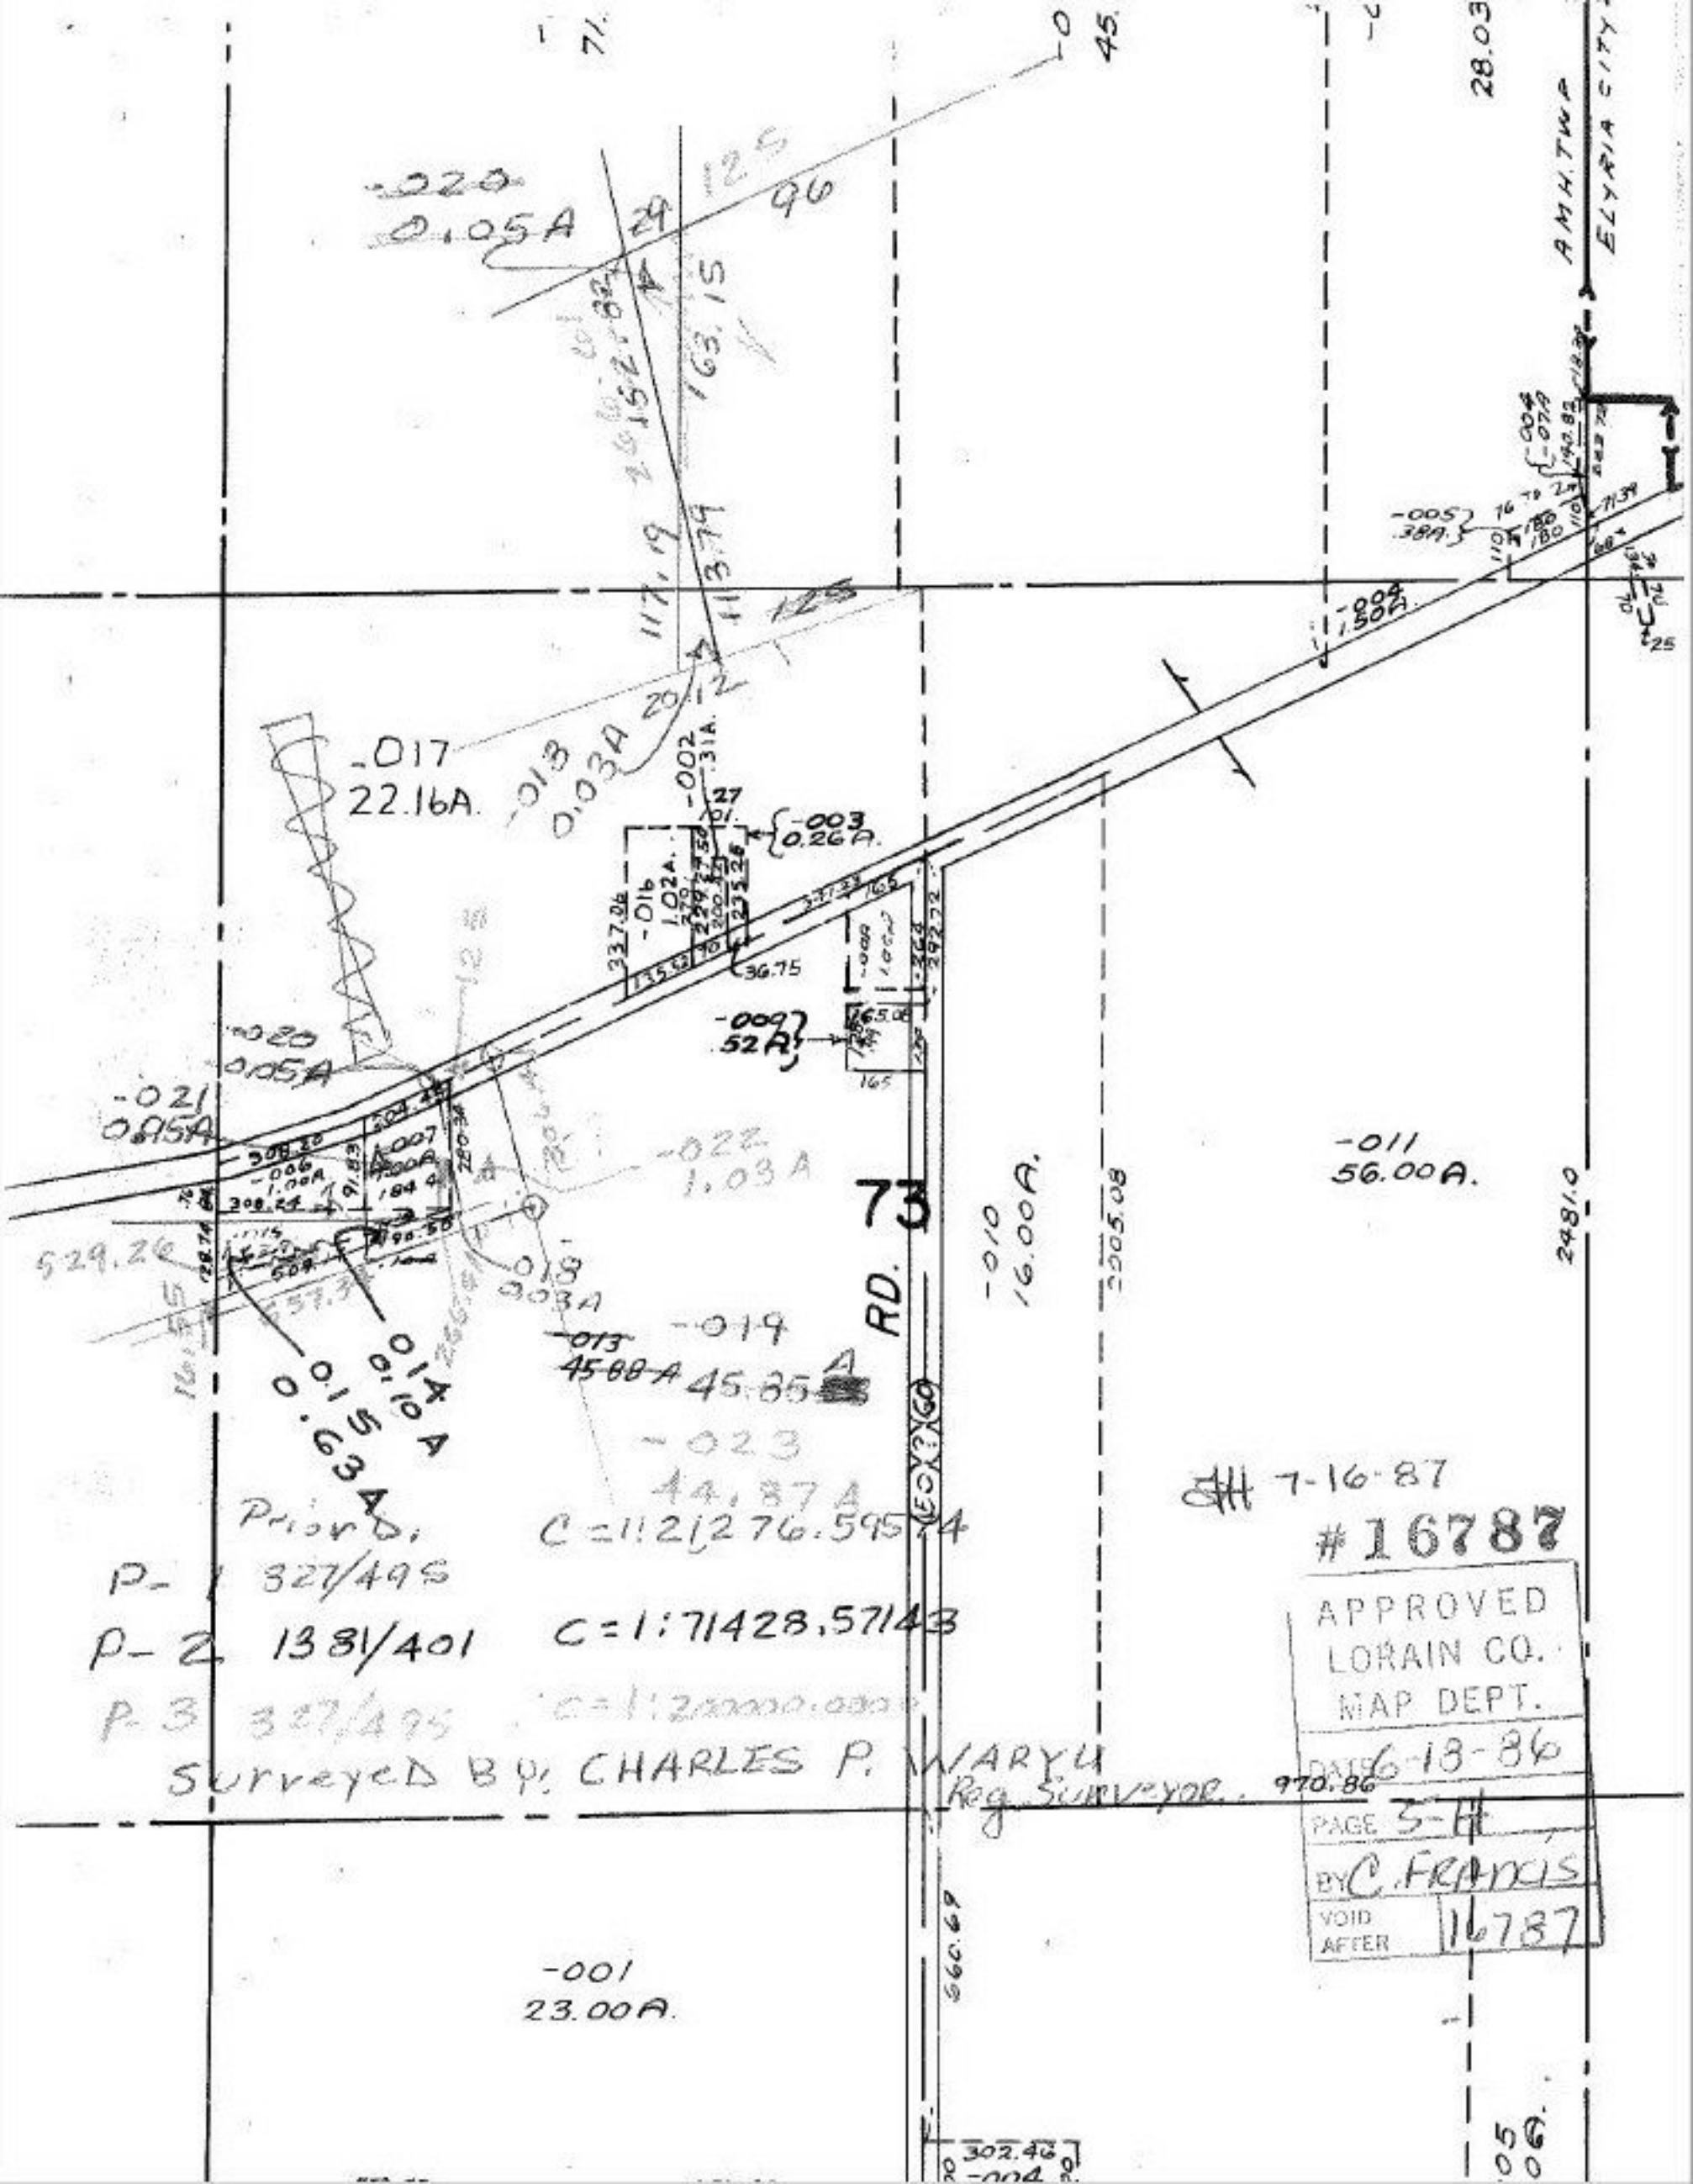

AMH. TWP
ELYRIA CITY
-020
0.05A
-017
22.16A.
-013
0.03A
-003
0.26A.
-004
1.50A.
-005
.38A.
-009
.52A
-020
0.05A
-021
0.05A
-022
1.03A
-018
0.03A
-019
45.85A
-013
45.88A
-023
44.87A
-014
0.10A
-015
0.63A
-010
16.00A.
-011
56.00A.
73
RD.
-001
23.00A.
Prior D.
P-1 327/495
P-2 1381/401
P-3 327/495
C=1:21276.59574
C=1:71428.57143
Surveyed By: CHARLES P. WARYU
Reg. Surveyor.
7-16-87
#16787
APPROVED
LORAIN CO.
MAP DEPT.
DATE 6-18-86
PAGE 5-H
BY C. FRANCIS
VOID AFTER 16787