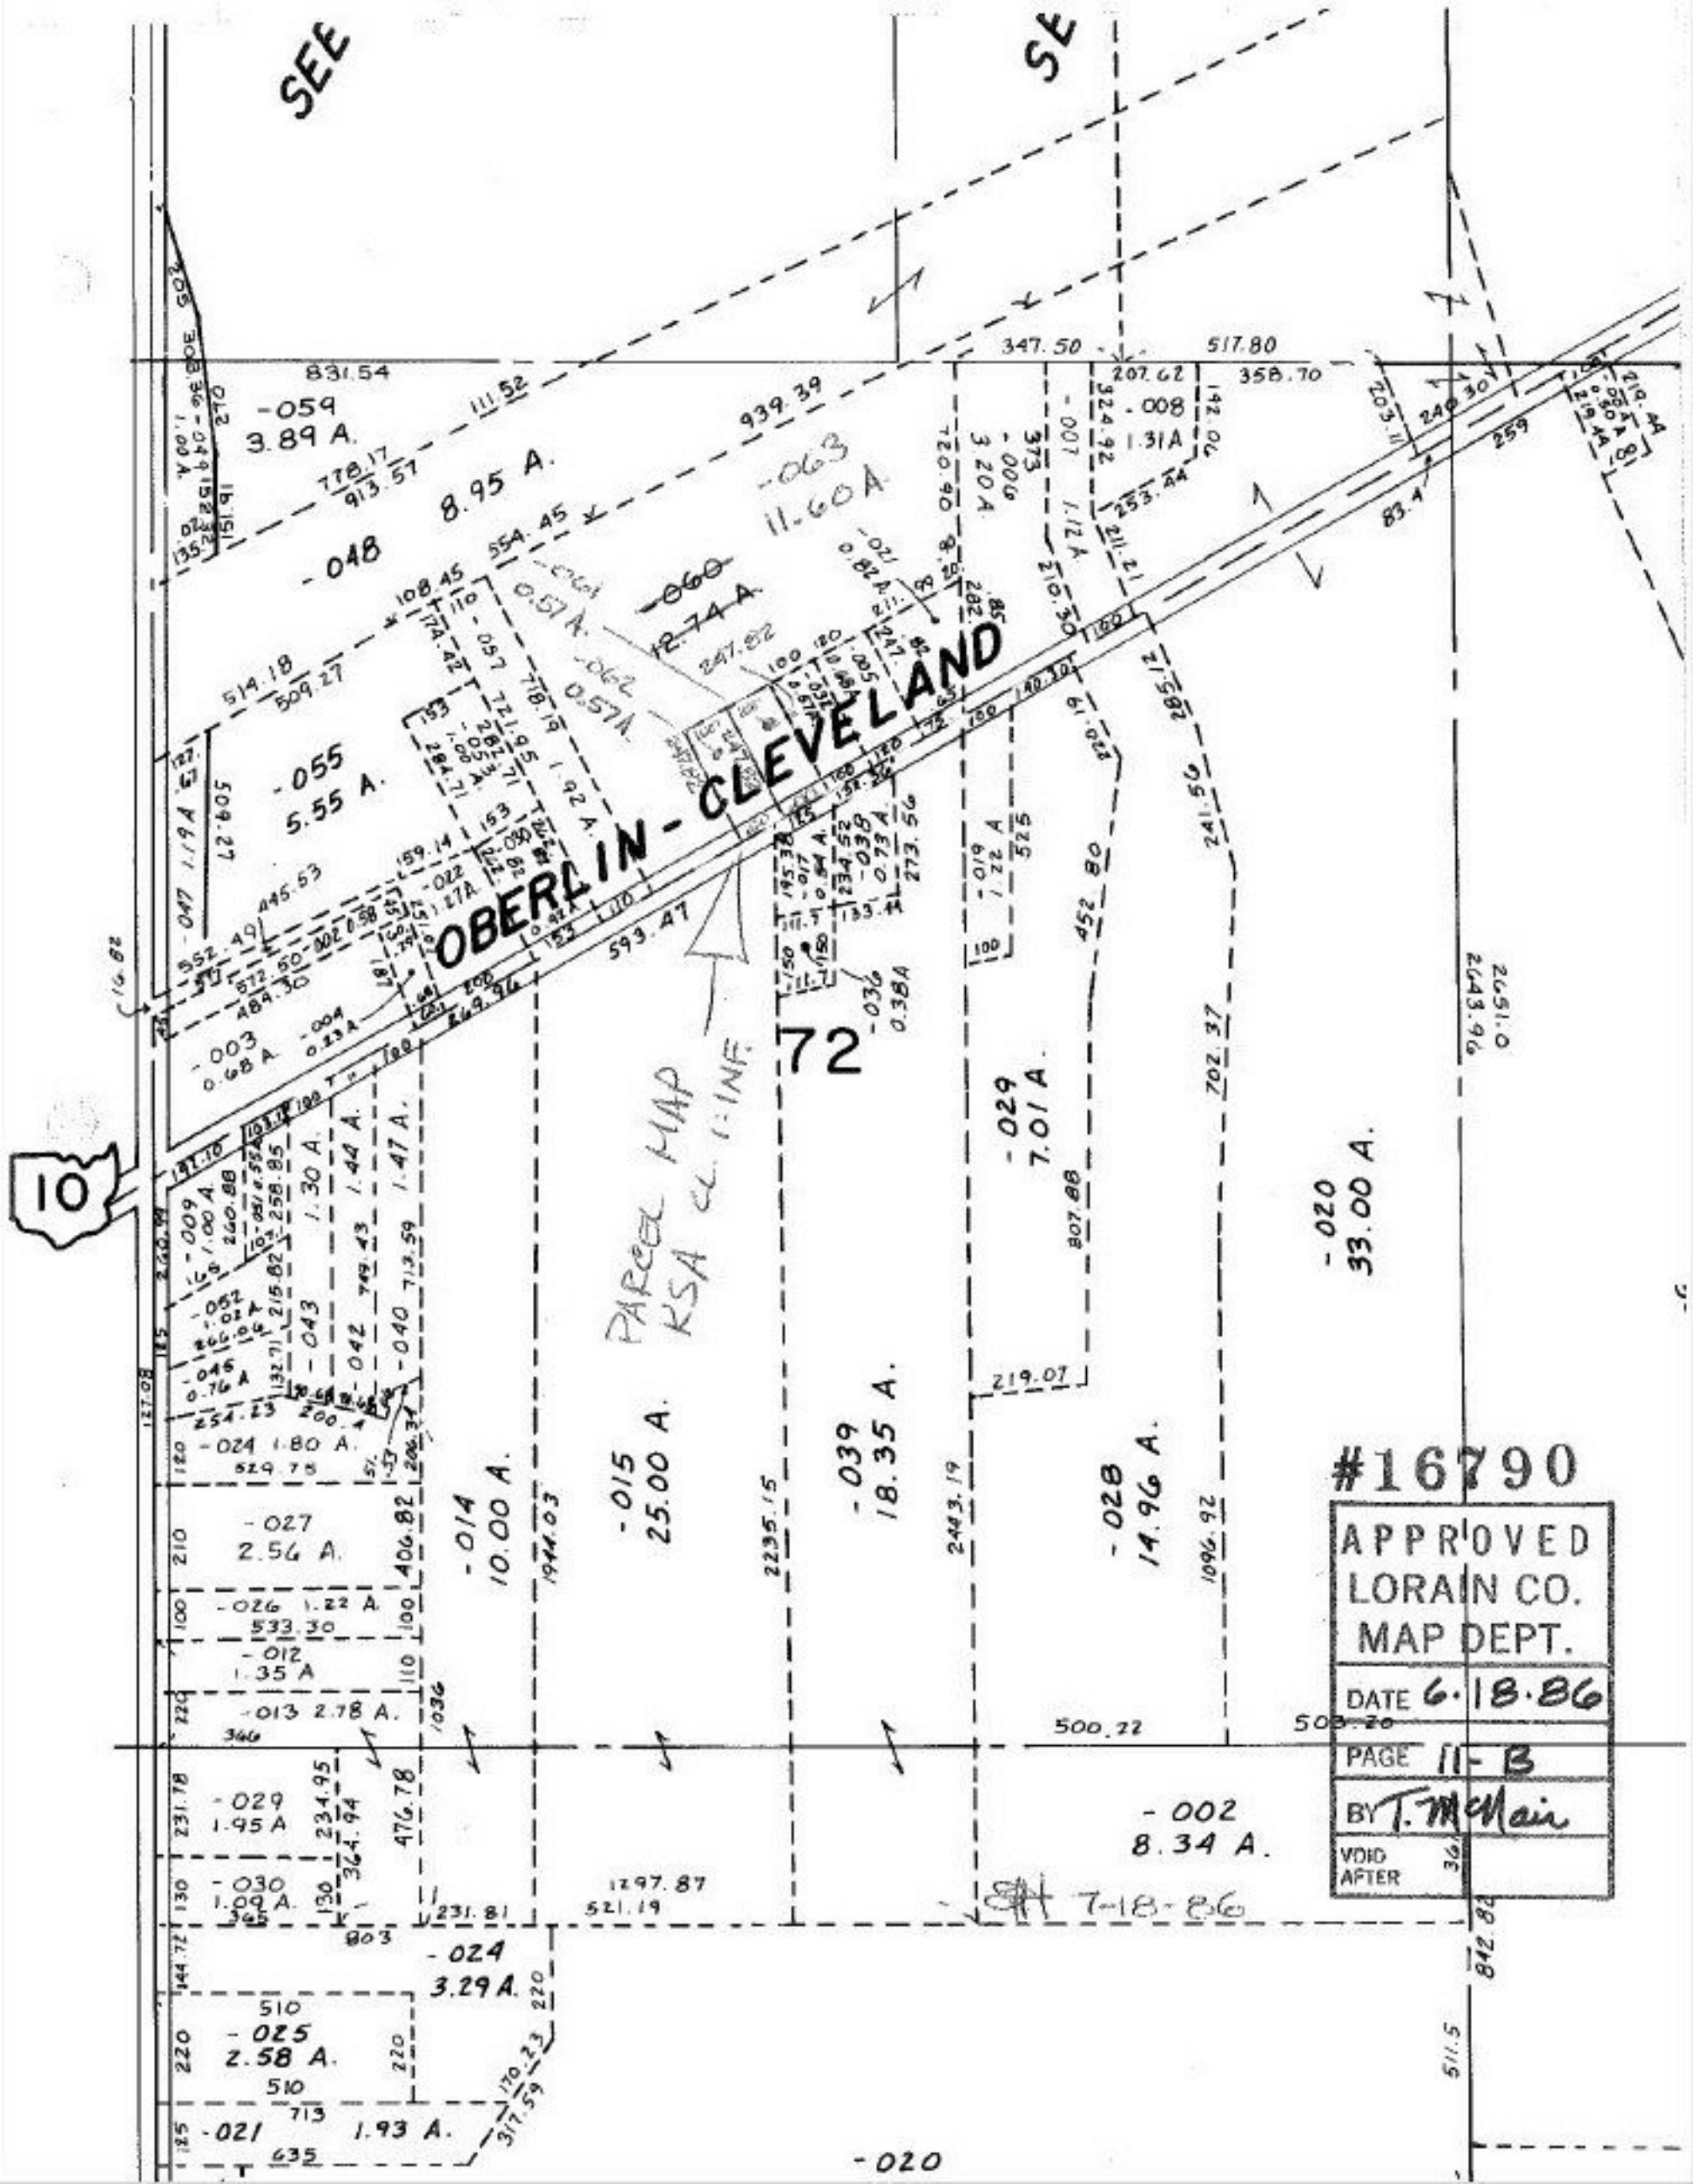

SEE
SE
OBERLIN - CLEVELAND
72
10
PARCEL MAP
KSA CL. 1:INF.
-059
3.89 A.
-048
8.95 A.
-063
11.60 A.
-060
12.74 A.
-061
0.57 A.
-062
0.57 A.
-055
5.55 A.
-003
0.68 A.
-009
1.00 A.
-052
1.02 A.
-045
0.76 A.
-043
1.30 A.
-042
1.44 A.
-040
1.47 A.
-024 1.80 A.
-027
2.56 A.
-026 1.22 A.
-012
1.35 A.
-013 2.78 A.
-029
1.95 A.
-030
1.09 A.
-024
3.29 A.
-025
2.58 A.
-021
1.93 A.
-014
10.00 A.
-015
25.00 A.
-039
18.35 A.
-028
14.96 A.
-029
7.01 A.
-020
33.00 A.
-002
8.34 A.
-020
831.54
111.52
939.39
347.50
517.80
358.70
207.62
-008
1.31 A.
-006
3.20 A.
-007
1.12 A.
-021
0.82 A.
-036
0.38 A.
-019
1.22 A.
-038
0.73 A.
-047 1.19 A.
-022
1.27 A.
-004
0.23 A.
-005
0.57 A.
-057
1.92 A.
-053
1.00 A.
1944.03
2235.15
2443.19
1096.92
1297.87
521.19
231.81
500.22
503.20
842.82
511.5
2651.0
2643.96
702.37
807.88
219.07
452.80
241.56
285.12
83.4
259
#16790
APPROVED
LORAIN CO.
MAP DEPT.
DATE 6.18.86
PAGE 11-B
BY T. McNair
VOID AFTER
7-18-86