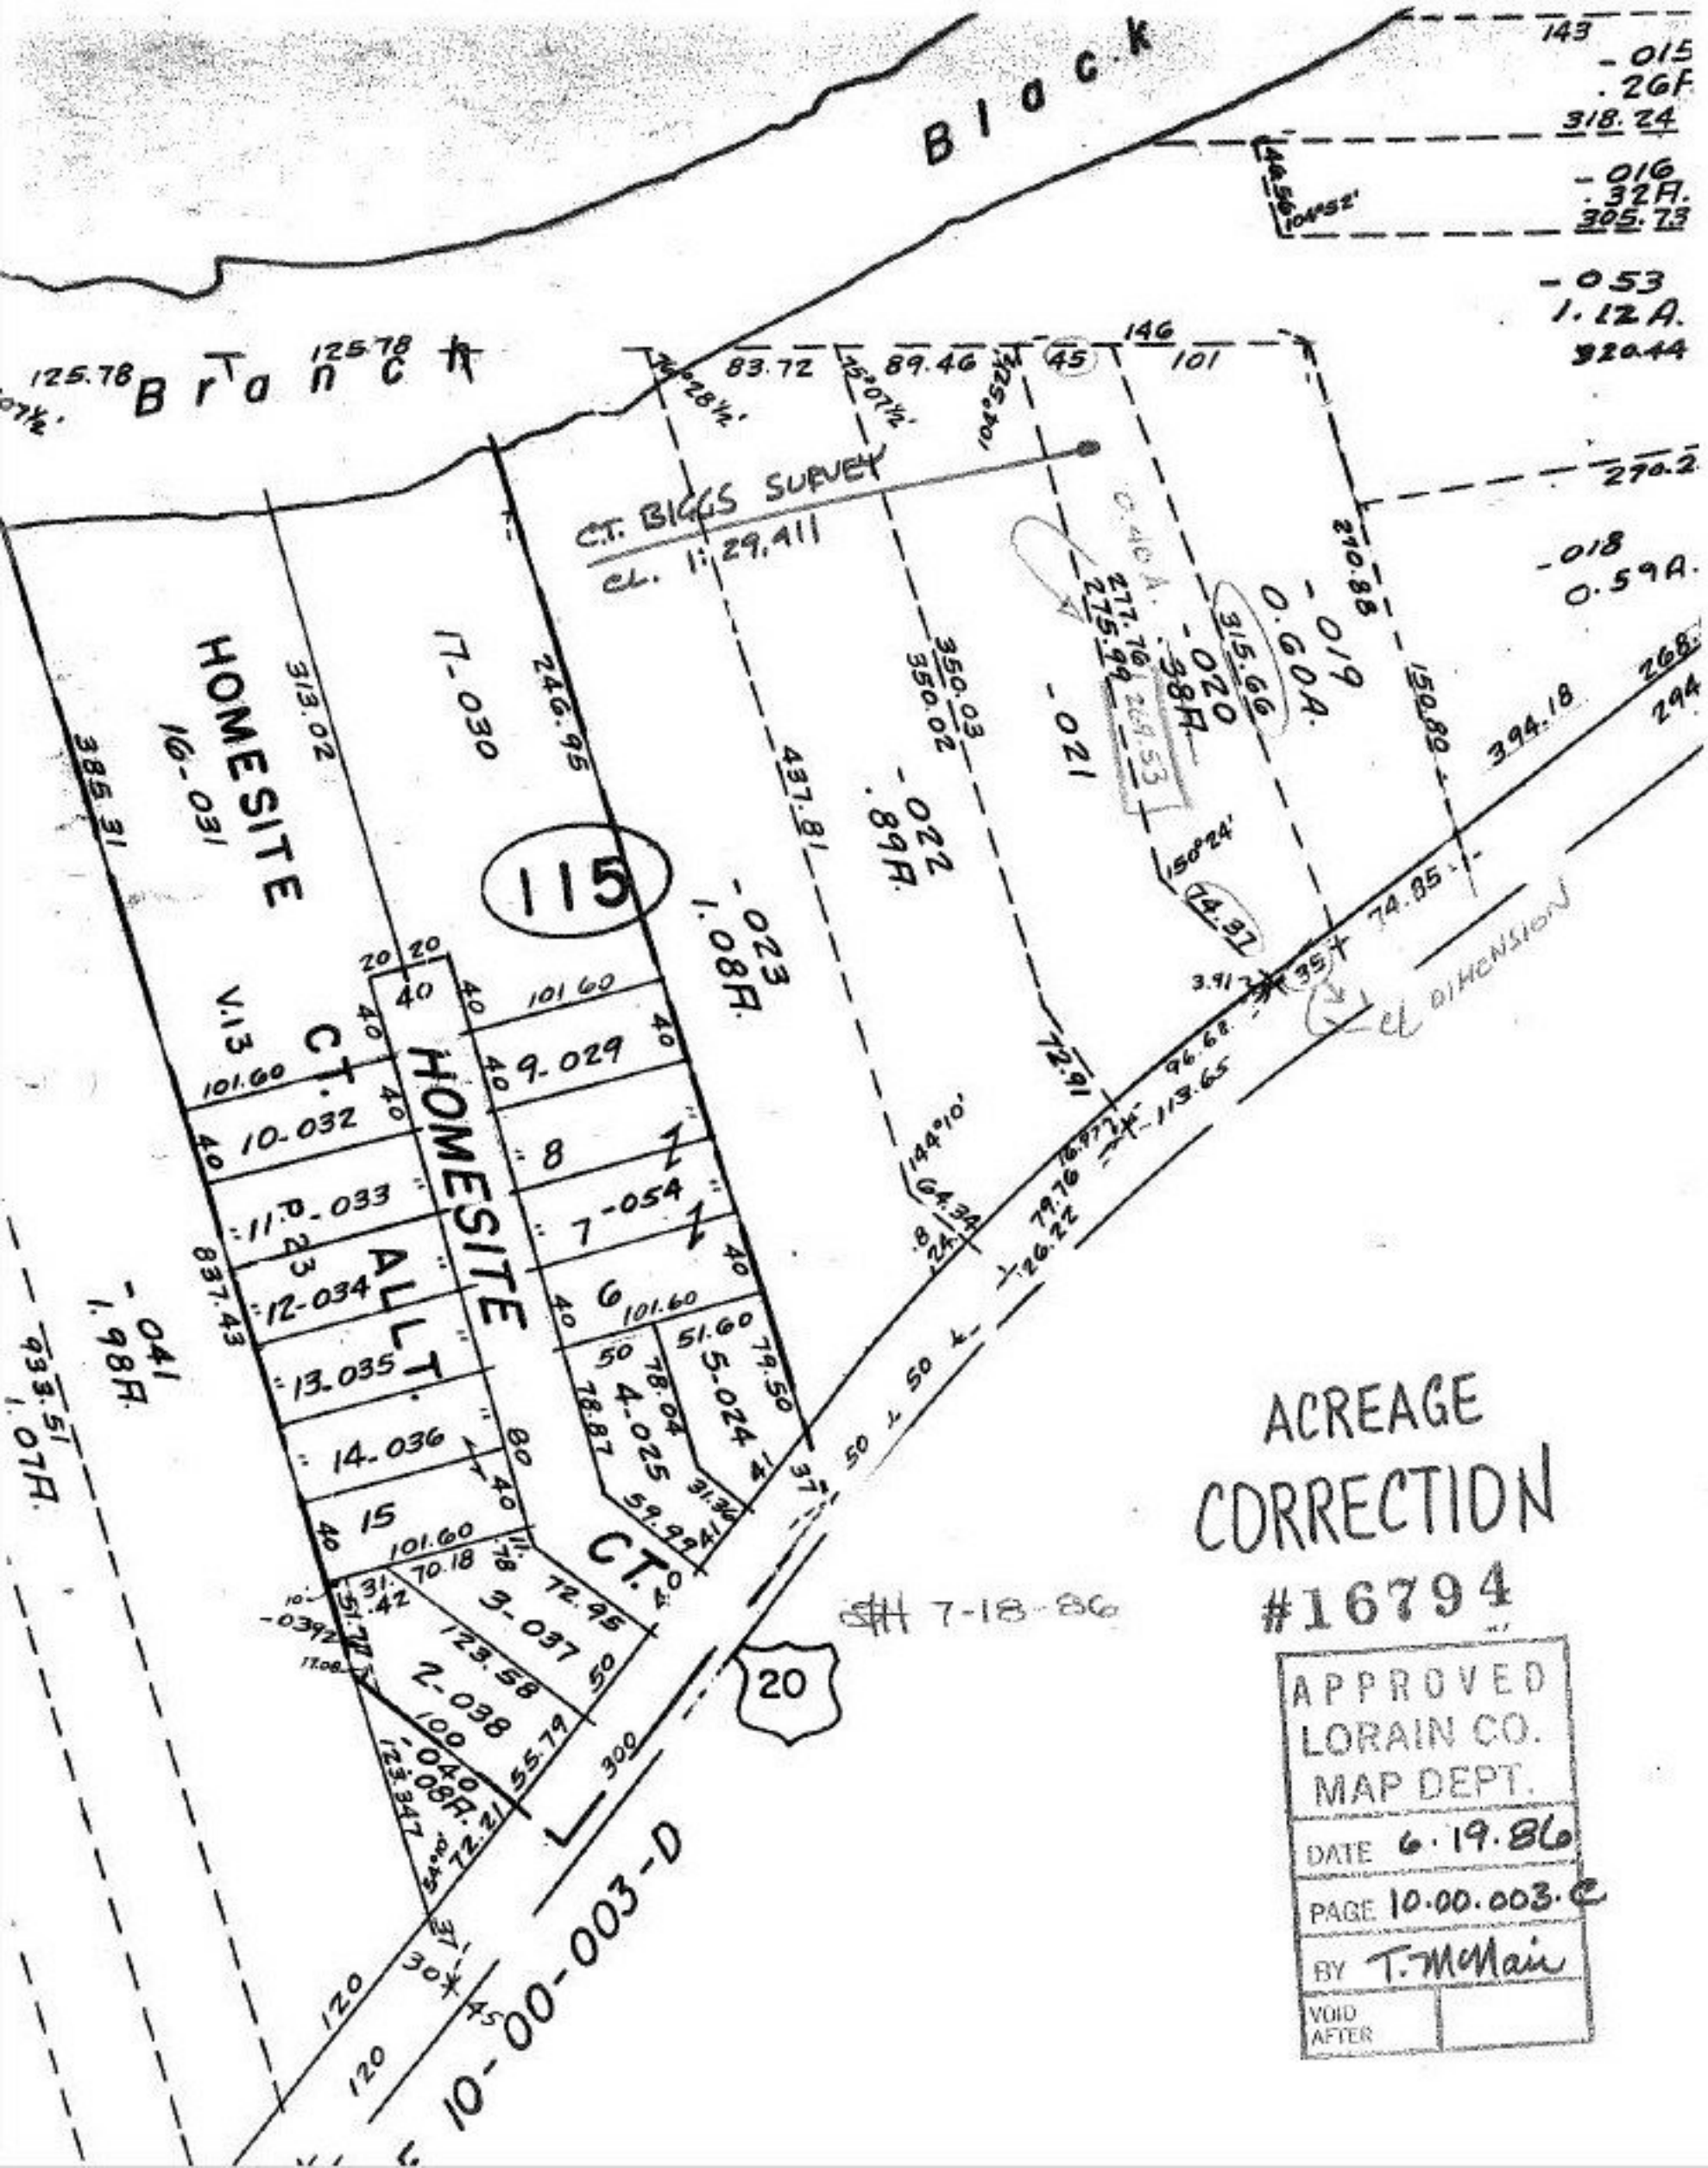
Block
Branch
C.T. BIGGS SURVEY
HOMESITE
ALLT.
CT.
115
20
10-00-003-D
ACREAGE
CORRECTION
#16794
APPROVED
LORAIN CO.
MAP DEPT.
DATE 6.19.86
PAGE 10.00.003.C
BY T. McNair
VOID AFTER